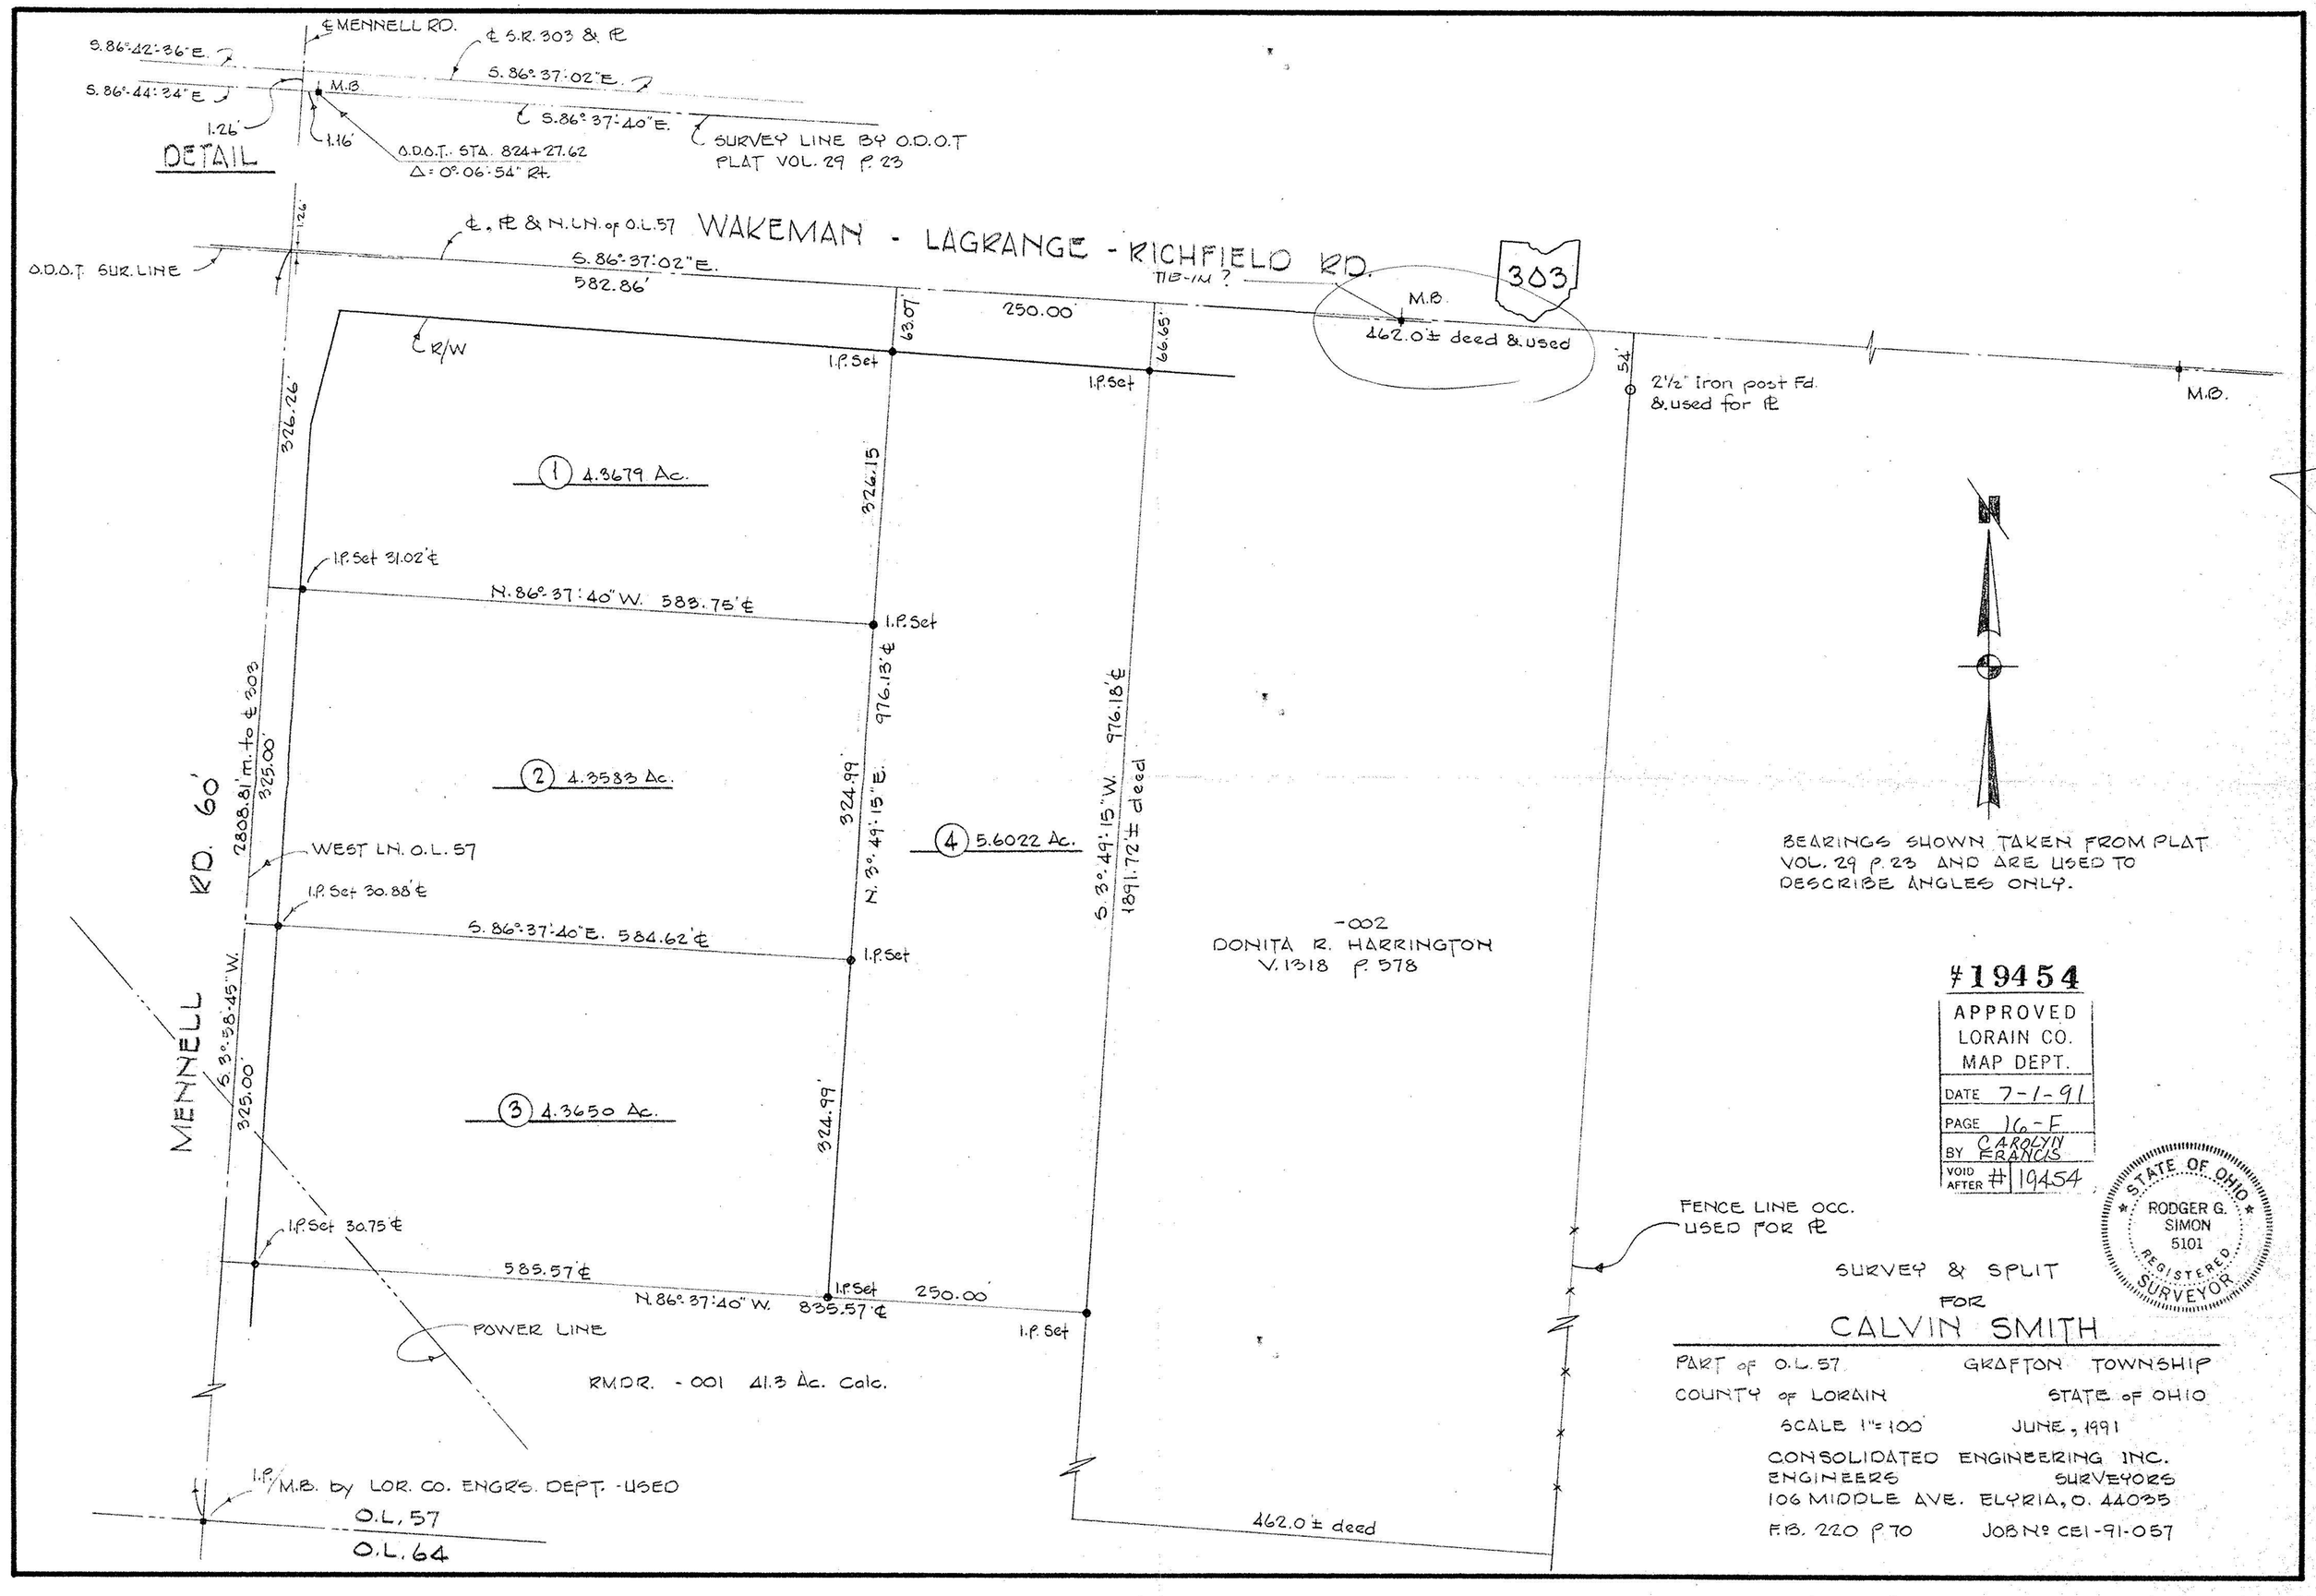

DETAIL
℄ MENNELL RD.
℄ S.R. 303 & PL
S. 86°-42'-36" E.
S. 86°-44'-34" E.
S. 86°-37'-02" E.
S. 86°-37'-40" E.
M.B.
1.26'
1.16'
O.D.O.T. STA. 824+27.62
Δ = 0°-06'-54" Rt.
SURVEY LINE BY O.D.O.T
PLAT VOL. 29 P. 23
℄, PL & N. LN. of O.L. 57
WAKEMAN - LAGRANGE - RICHFIELD RD.
303
O.D.O.T. SUR. LINE
S. 86°-37'-02" E.
582.86'
TIE-IN ?
M.B.
462.0'± deed & used
250.00'
63.07'
66.65'
54'
2½" Iron post Fd.
& used for PL
M.B.
℄ R/W
I.P. Set
I.P. Set
326.26'
326.15'
1 4.3679 Ac.
I.P. Set 31.02' ℄
N. 86°-37'-40" W. 583.75' ℄
I.P. Set
976.13' ℄
976.18' ℄
2808.81' m. to ℄ 303
325.00'
2 4.3583 Ac.
324.99'
N. 3°-49'-15" E.
4 5.6022 Ac.
S. 3°-49'-15" W.
1891.72'± deed
WEST LN. O.L. 57
I.P. Set 30.88' ℄
S. 86°-37'-40" E. 584.62' ℄
I.P. Set
-002
DONITA R. HARRINGTON
V. 1318 P. 578
MENNELL RD. 60'
S. 3°-58'-45" W.
325.00'
3 4.3650 Ac.
324.99'
I.P. Set 30.75' ℄
585.57' ℄
N. 86°-37'-40" W.
835.57' ℄
I.P. Set
250.00'
I.P. Set
POWER LINE
RMDR. -001 41.3 Ac. Calc.
I.P./M.B. by LOR. CO. ENGRS. DEPT. - USED
O.L. 57
O.L. 64
462.0'± deed
FENCE LINE OCC.
USED FOR PL
BEARINGS SHOWN TAKEN FROM PLAT
VOL. 29 P. 23 AND ARE USED TO
DESCRIBE ANGLES ONLY.
#19454
APPROVED
LORAIN CO.
MAP DEPT.
DATE 7-1-91
PAGE 16-F
BY CAROLYN FRANCIS
VOID AFTER # 19454
STATE OF OHIO
RODGER G. SIMON
5101
REGISTERED SURVEYOR
SURVEY & SPLIT
FOR
CALVIN SMITH
PART of O.L. 57
GRAFTON TOWNSHIP
COUNTY of LORAIN
STATE of OHIO
SCALE 1" = 100'
JUNE, 1991
CONSOLIDATED ENGINEERING INC.
ENGINEERS
SURVEYORS
106 MIDDLE AVE. ELYRIA, O. 44035
F.B. 220 P. 70
JOB No CEI-91-057