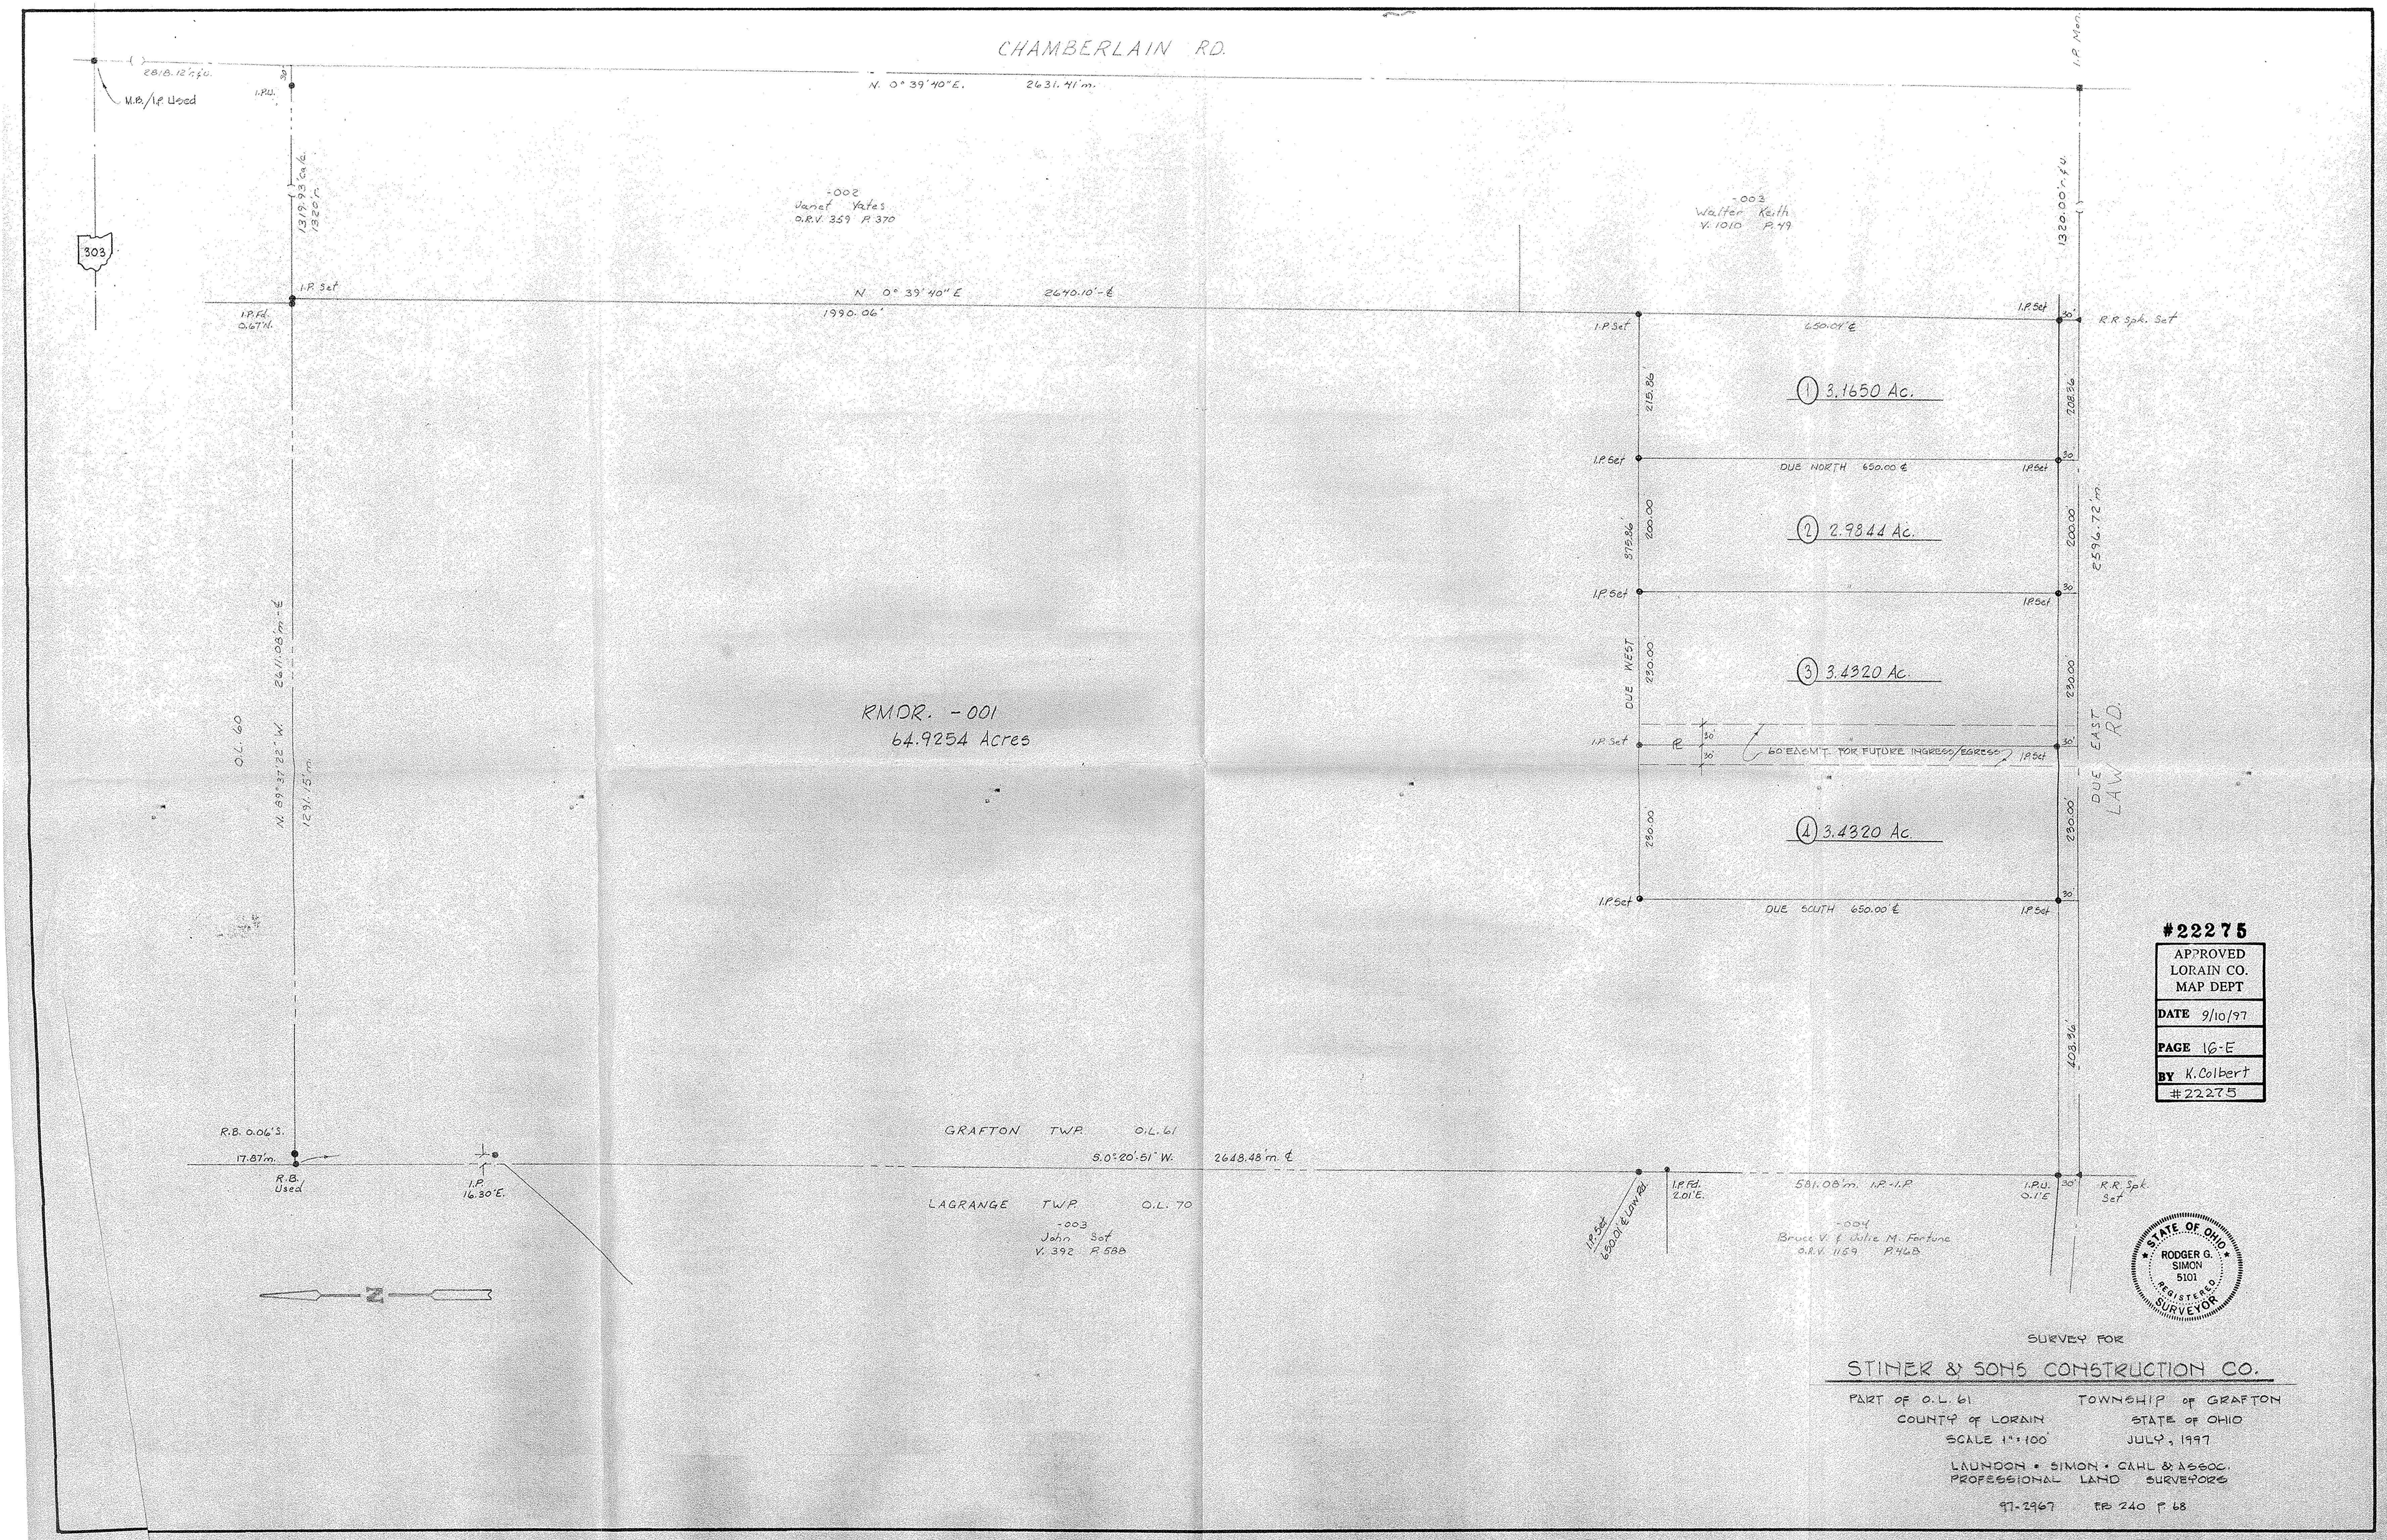
CHAMBERLAIN RD.
N. 0° 39' 40" E. 2631.41' m.
2818.12' r.f.u.
M.B./I.P. Used
303
1319.93' Calc.
1320' r.
-002
Janet Yates
O.R.V. 359 P. 370
-003
Walter Keith
V. 1010 P. 49
1320.00' r.f.u.
I.P. Set
N 0° 39' 40" E 2640.10' ℄
1990.06'
I.P. Fd. 0.67' N.
650.01' ℄
R.R. Spk. Set
1 3.1650 Ac.
DUE NORTH 650.00 ℄
2 2.9844 Ac.
3 3.4320 Ac.
4 3.4320 Ac.
DUE WEST
DUE EAST
LAW RD.
60' EASM'T. FOR FUTURE INGRESS/EGRESS
DUE SOUTH 650.00' ℄
RMDR. -001
64.9254 Acres
O.L. 60
N. 89° 37' 22" W. 2611.08' m. ℄
1291.15' m.
2596.72' m.
R.B. 0.06' S.
17.87' m.
R.B. Used
I.P. 16.30' E.
GRAFTON TWP. O.L. 61
S. 0° 20' 51" W. 2648.48' m. ℄
LAGRANGE TWP. O.L. 70
-003
John Sot
V. 392 P. 588
I.P. Set 650.01' ℄ Law Rd.
I.P. Fd. 2.01' E.
581.08' m. I.P.-I.P.
-004
Bruce V. & Julie M. Fortune
O.R.V. 1159 P. 468
I.P.U. 0.1' E.
R.R. Spk. Set
N
#22275
APPROVED
LORAIN CO.
MAP DEPT
DATE 9/10/97
PAGE 16-E
BY K. Colbert
#22275
STATE OF OHIO
RODGER G. SIMON
5101
REGISTERED SURVEYOR
SURVEY FOR
STINER & SONS CONSTRUCTION CO.
PART OF O.L. 61
TOWNSHIP OF GRAFTON
COUNTY OF LORAIN
STATE OF OHIO
SCALE 1" = 100'
JULY, 1997
LAUNDON • SIMON • CAHL & ASSOC.
PROFESSIONAL LAND SURVEYORS
97-2967 FB 240 P. 68