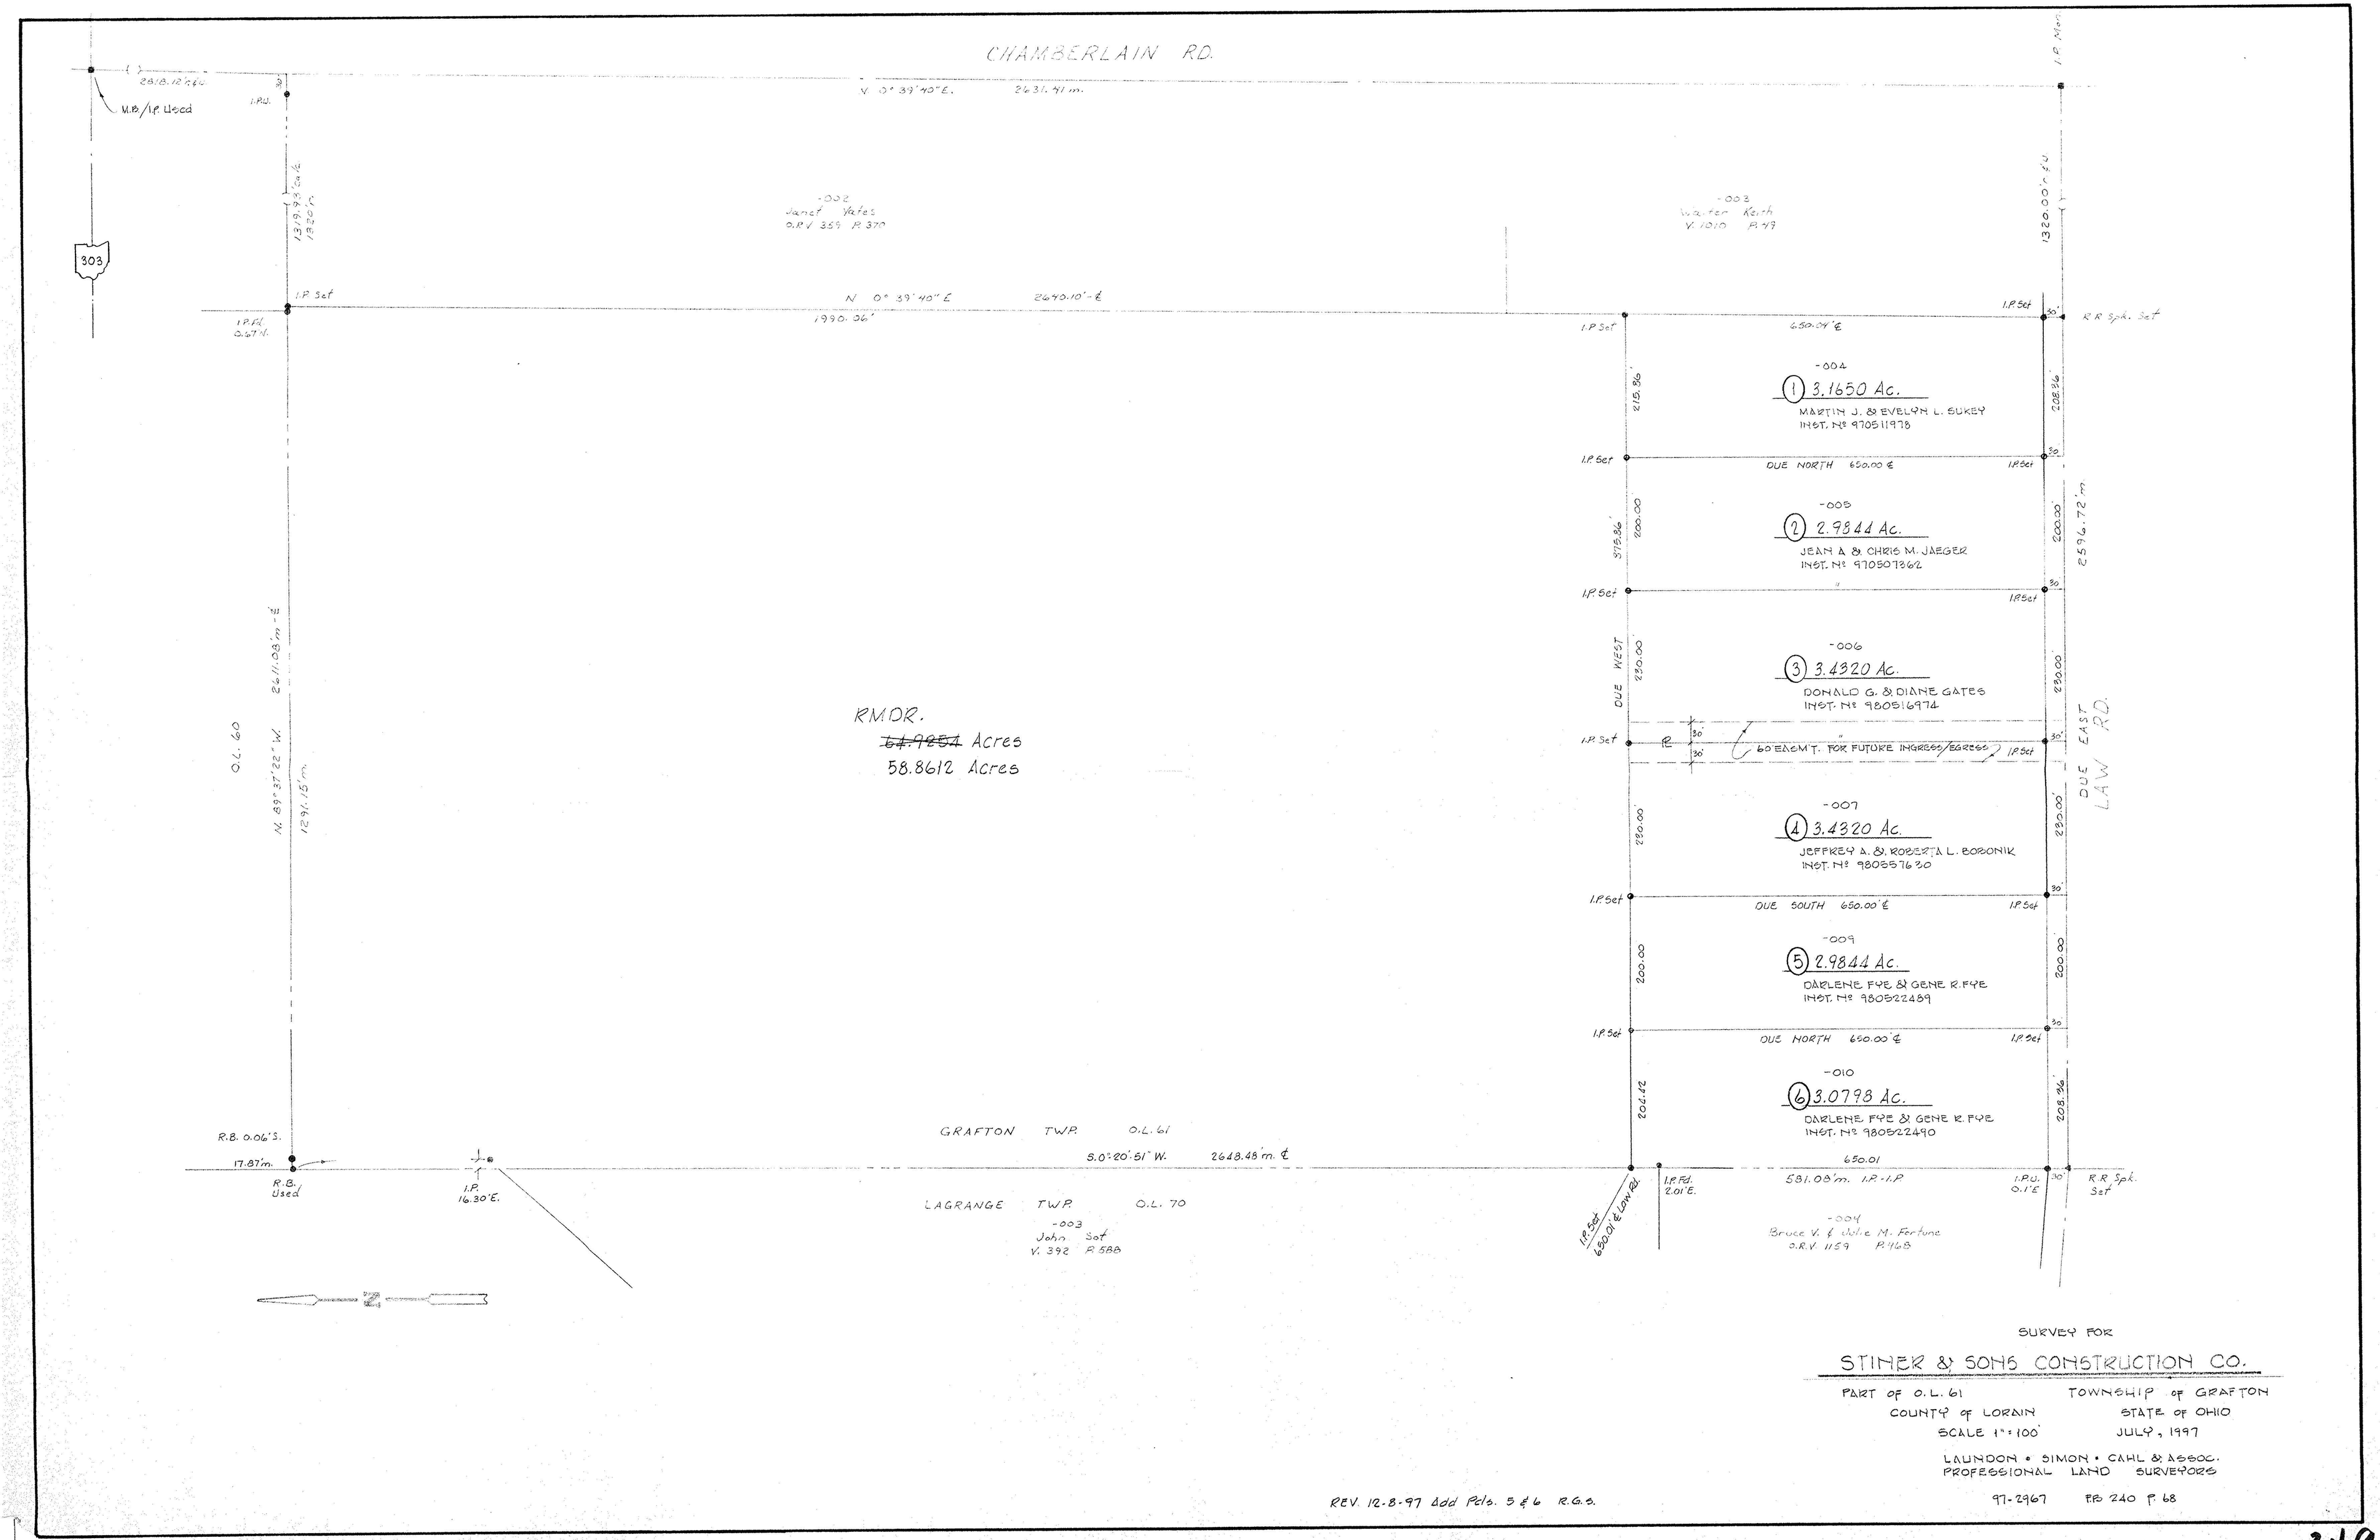
CHAMBERLAIN RD.
N 0° 39' 40" E. 2631.41 m.
M.B./I.P. Used
303
-002
Janet Yates
O.R.V. 359 P. 370
-003
Walter Keith
V. 1010 P. 49
I.P. Set
N 0° 39' 40" E 2640.10' ℄
1990.06'
650.04' ℄
-004
1 3.1650 Ac.
MARTIN J. & EVELYN L. SUKEY
INST. Nº 970511978
DUE NORTH 650.00 ℄
-005
2 2.9844 Ac.
JEAN A. & CHRIS M. JAEGER
INST. Nº 970507362
-006
3 3.4320 Ac.
DONALD G. & DIANE GATES
INST. Nº 980516974
60' EASM'T. FOR FUTURE INGRESS/EGRESS
-007
4 3.4320 Ac.
JEFFREY A. & ROBERTA L. BOBONIK
INST. Nº 980557630
DUE SOUTH 650.00' ℄
-009
5 2.9844 Ac.
DARLENE FYE & GENE R. FYE
INST. Nº 980522489
DUE NORTH 650.00' ℄
-010
6 3.0798 Ac.
DARLENE FYE & GENE R. FYE
INST. Nº 980522490
DUE WEST
DUE EAST
LAW RD.
2596.72' m.
1320.00' ℄
R.R. Spk. Set
O.L. 60
N. 89° 37' 22" W. 2611.08' m. ℄
1291.15' m.
RMDR.
~~64.9254~~ Acres
58.8612 Acres
GRAFTON TWP. O.L. 61
S. 0° 20' 51" W. 2648.48' m. ℄
LAGRANGE TWP. O.L. 70
-003
John Sot
V. 392 P. 588
R.B. 0.06' S.
17.87' m.
R.B. Used
I.P. 16.30' E.
I.P. Set 650.01' ℄ Law Rd.
I.P. Fd. 2.01' E.
650.01
581.08' m. I.P.-I.P.
I.P.U. 0.1' E.
-004
Bruce V. & Julie M. Fortune
O.R.V. 1159 P. 468
SURVEY FOR
STINER & SONS CONSTRUCTION CO.
PART OF O.L. 61
TOWNSHIP OF GRAFTON
COUNTY OF LORAIN
STATE OF OHIO
SCALE 1" = 100'
JULY, 1997
LAUNDON • SIMON • CAHL & ASSOC.
PROFESSIONAL LAND SURVEYORS
97-2967 F.B. 240 P. 68
REV. 12-8-97 Add Pcls. 5 & 6 R.G.S.