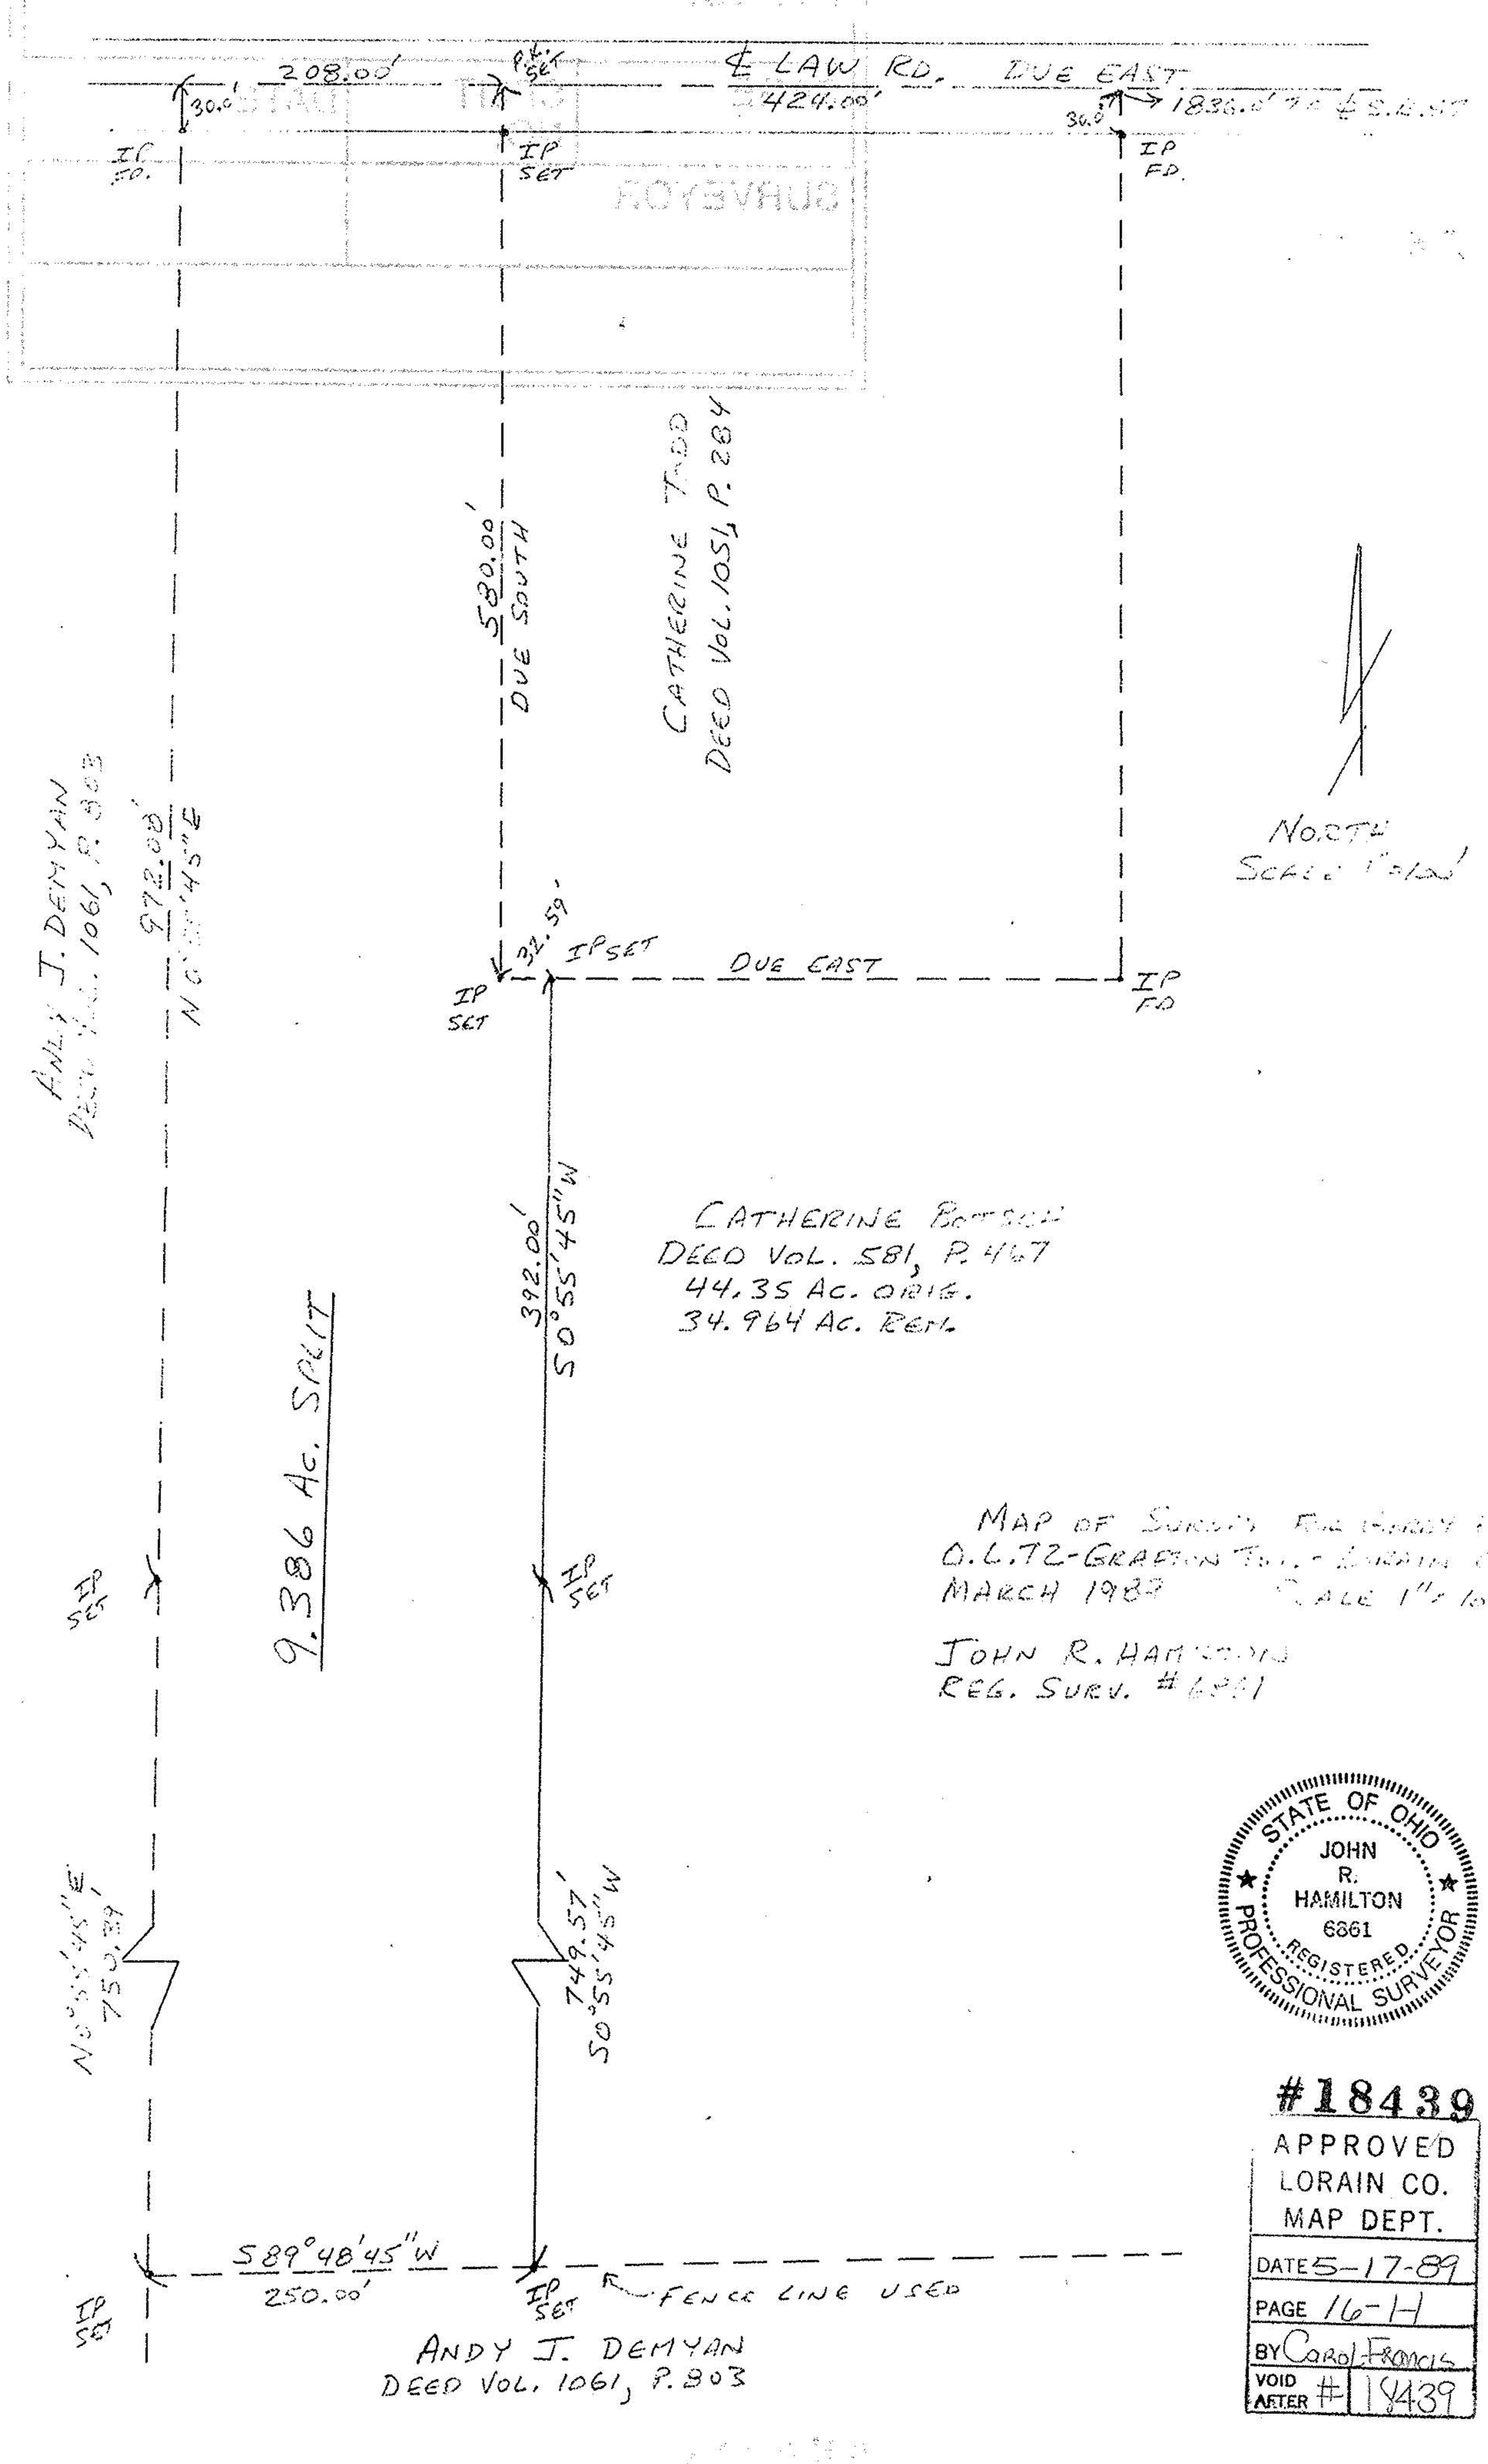
208.00'
30.0'
IP FD.
IP SET
℄ LAW RD.
1424.00'
DUE EAST
1836.0'
30.0'
IP FD.
580.00'
DUE SOUTH
CATHERINE
DEED VOL. 1051, P. 284
392.00'
S0°55'45"W
32.59'
IP SET
DUE EAST
IP FD
IP SET
ANDY J. DEMYAN
DEED VOL. 1061, P. 803
972.00'
N 0°55'45"E
9.386 Ac. SPLIT
IP SET
N0°55'45"E
750.39'
749.57'
S0°55'45"W
589°48'45"W
250.00'
IP SET
FENCE LINE USED
IP SET
NORTH
CATHERINE BOTSKO
DEED VOL. 581, P. 467
44.35 AC. ORIG.
34.964 AC. REM.
MAP OF SURVEY FOR ANDY J. DEMYAN
O.L. 72-GRAFTON TWP. - LORAIN CO.
MARCH 1989 SCALE 1"=100'
JOHN R. HAMILTON
REG. SURV. #6861
STATE OF OHIO
JOHN R. HAMILTON
6861
REGISTERED
PROFESSIONAL SURVEYOR
#18439
APPROVED
LORAIN CO.
MAP DEPT.
DATE 5-17-89
PAGE 16-H
BY Carol Francis
VOID AFTER # 18439