

16-14

16-00-073-000

Deed Check only

|      |         |
|------|---------|
| -001 | 30.50 A |
| -024 | 1.00    |
| 028  | 1.00    |
| 022  | 1.00    |
| 026  | 1.00    |
| -030 | 1.87A   |

5.87  
 -031 14.13 A  
 -----  
 20.00 A


LAW

ERHART

73

-031  
 14.13 A

Exception

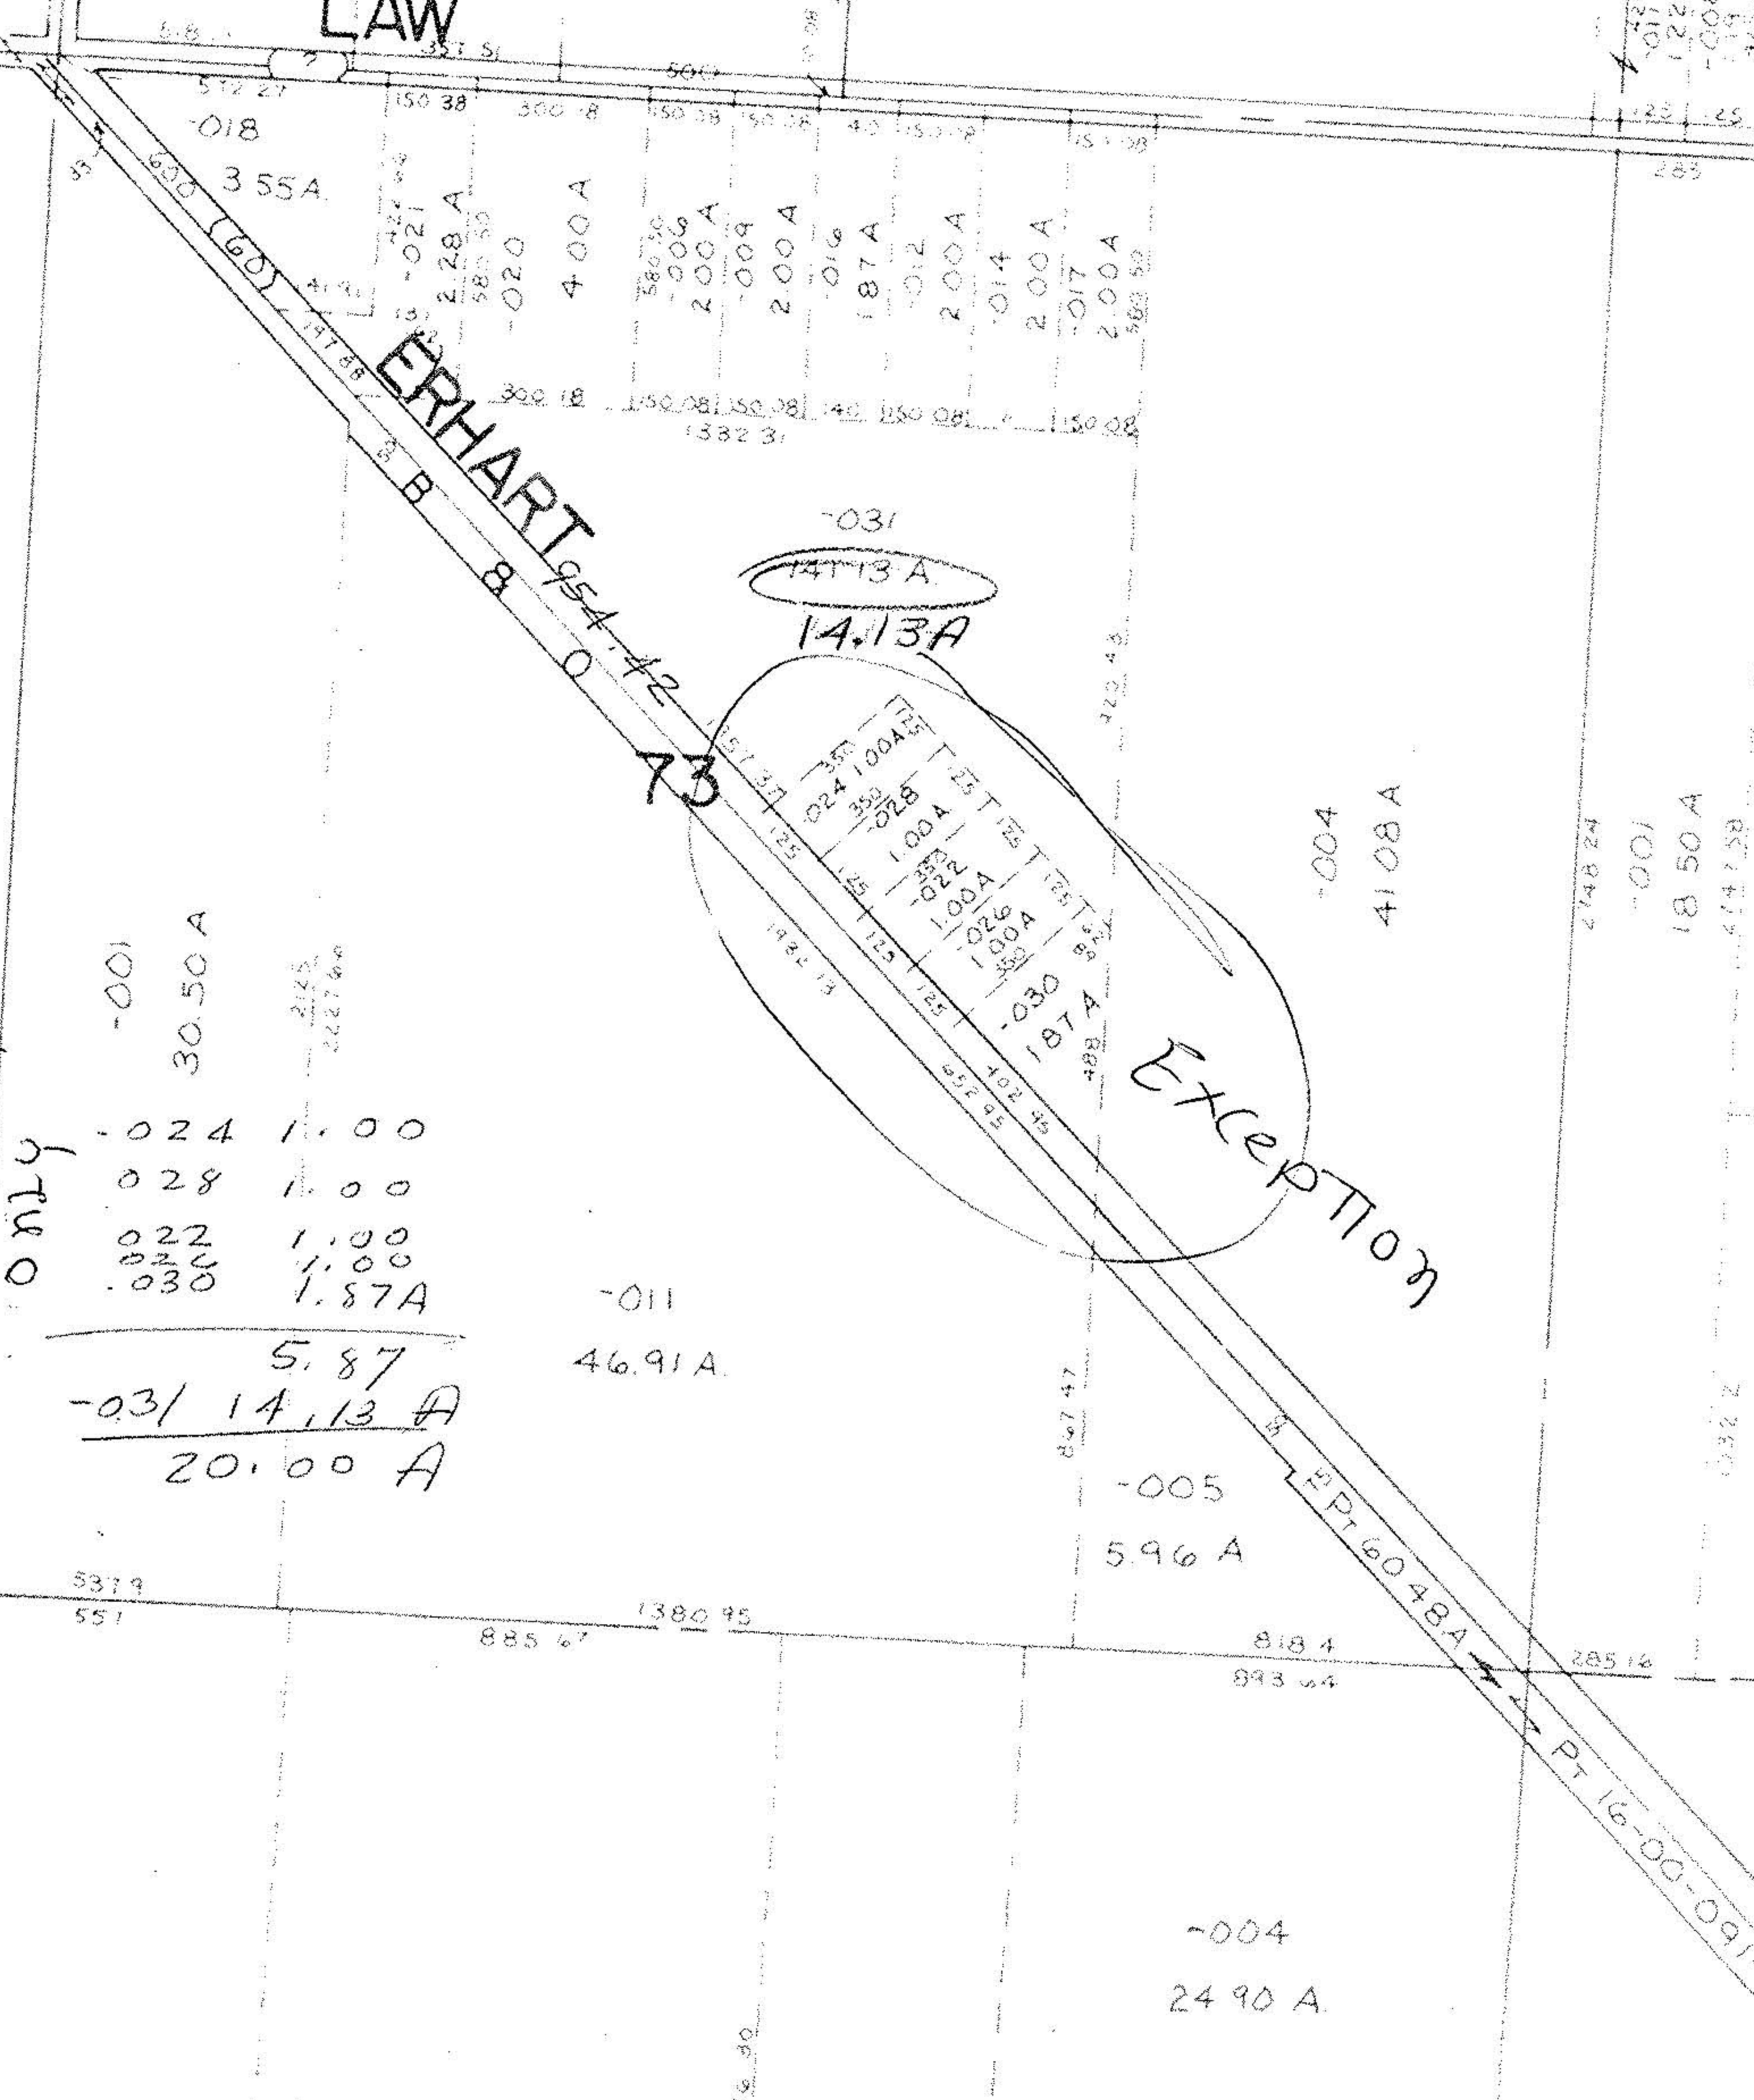

-011  
46.91 A

-005  
596 A

-004  
2490 A

-004  
4108 A

-001  
1850 A

1017  
122 A  
-008  
119 A  
145  
-009  
25 A

5379  
551

885 67

1380 95

818 4  
893 64

285 16

1496 90

2748 24

1115 38

2262

1115 38

2262

2262

2262