



DATE: APRIL 1988
SCALE: 1"=100'

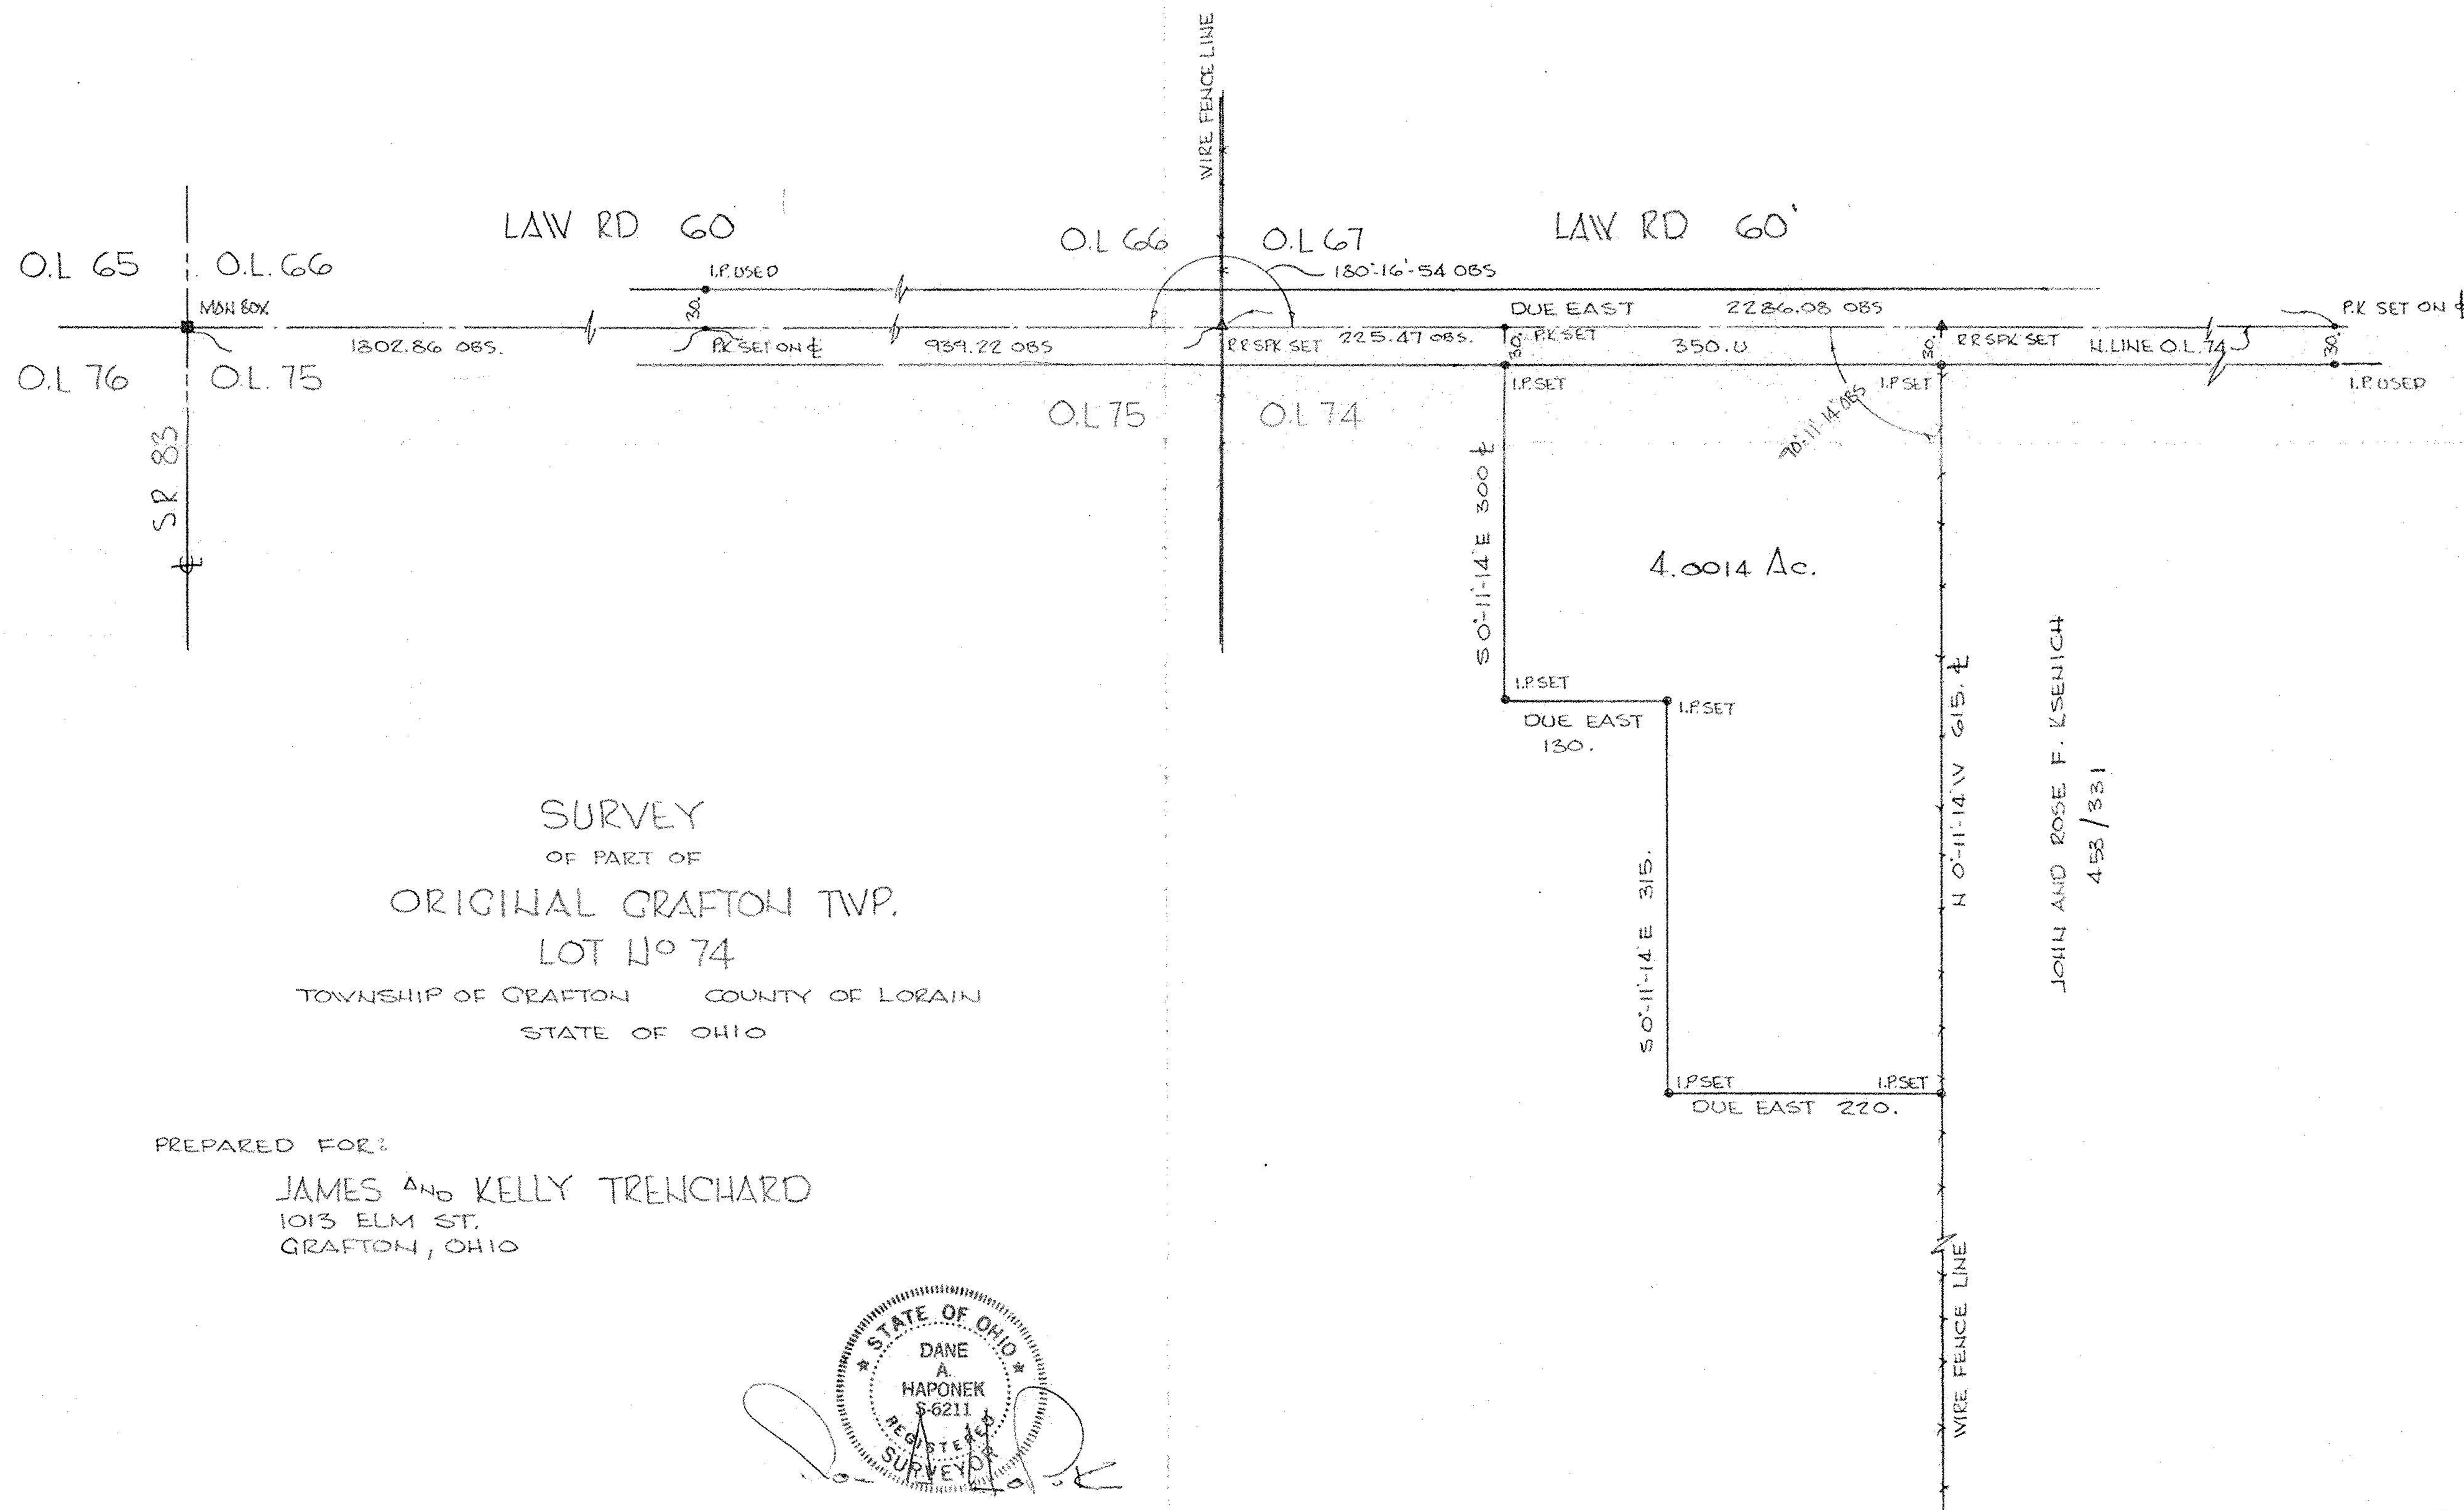

SURVEY
OF PART OF
ORIGINAL GRAFTON TWP.
LOT NO 74
TOWNSHIP OF GRAFTON COUNTY OF LORAIN
STATE OF OHIO

PREPARED FOR:
JAMES AND KELLY TRENCHARD
1013 ELM ST.
GRAFTON, OHIO

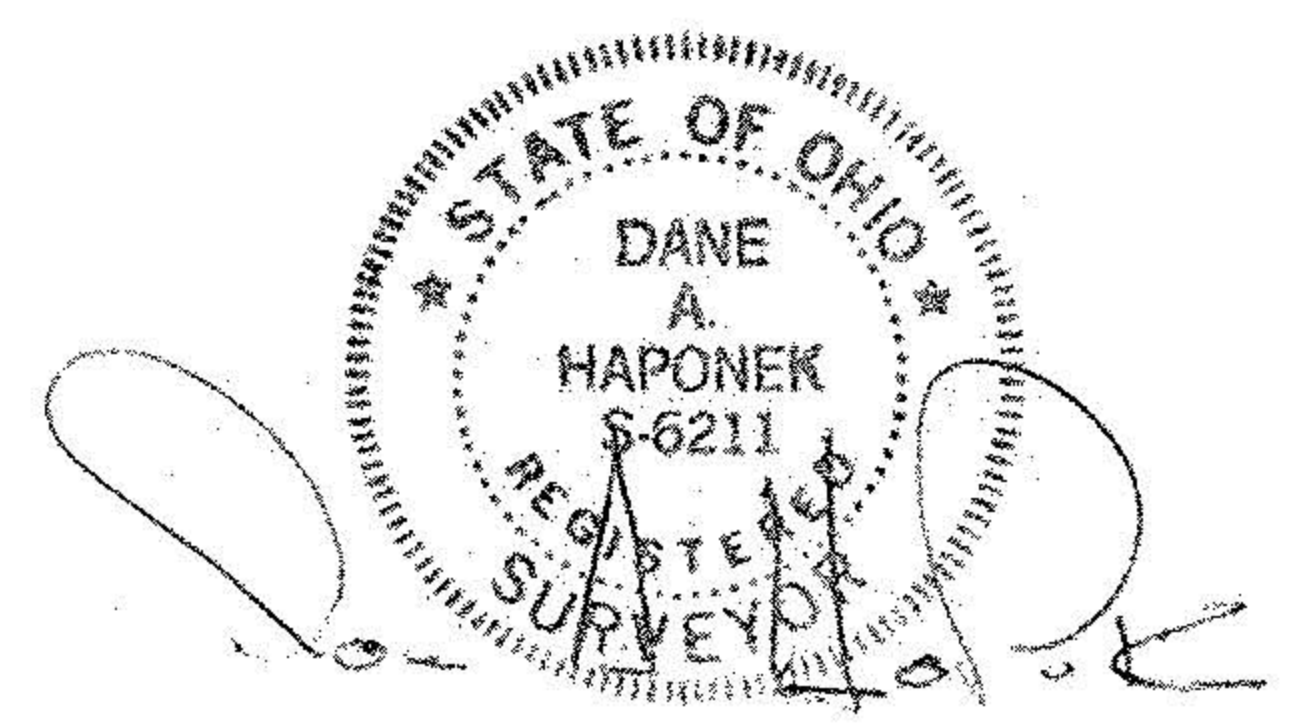

JOHN AND ROSE F. KSENICH
458 / 331