#11241

16G

5.3201 Ac.

We hereby accept the Mortgage Ident. showing property to be excepted which is outlined in red.

Ray D. Ware

Jean R. Ware

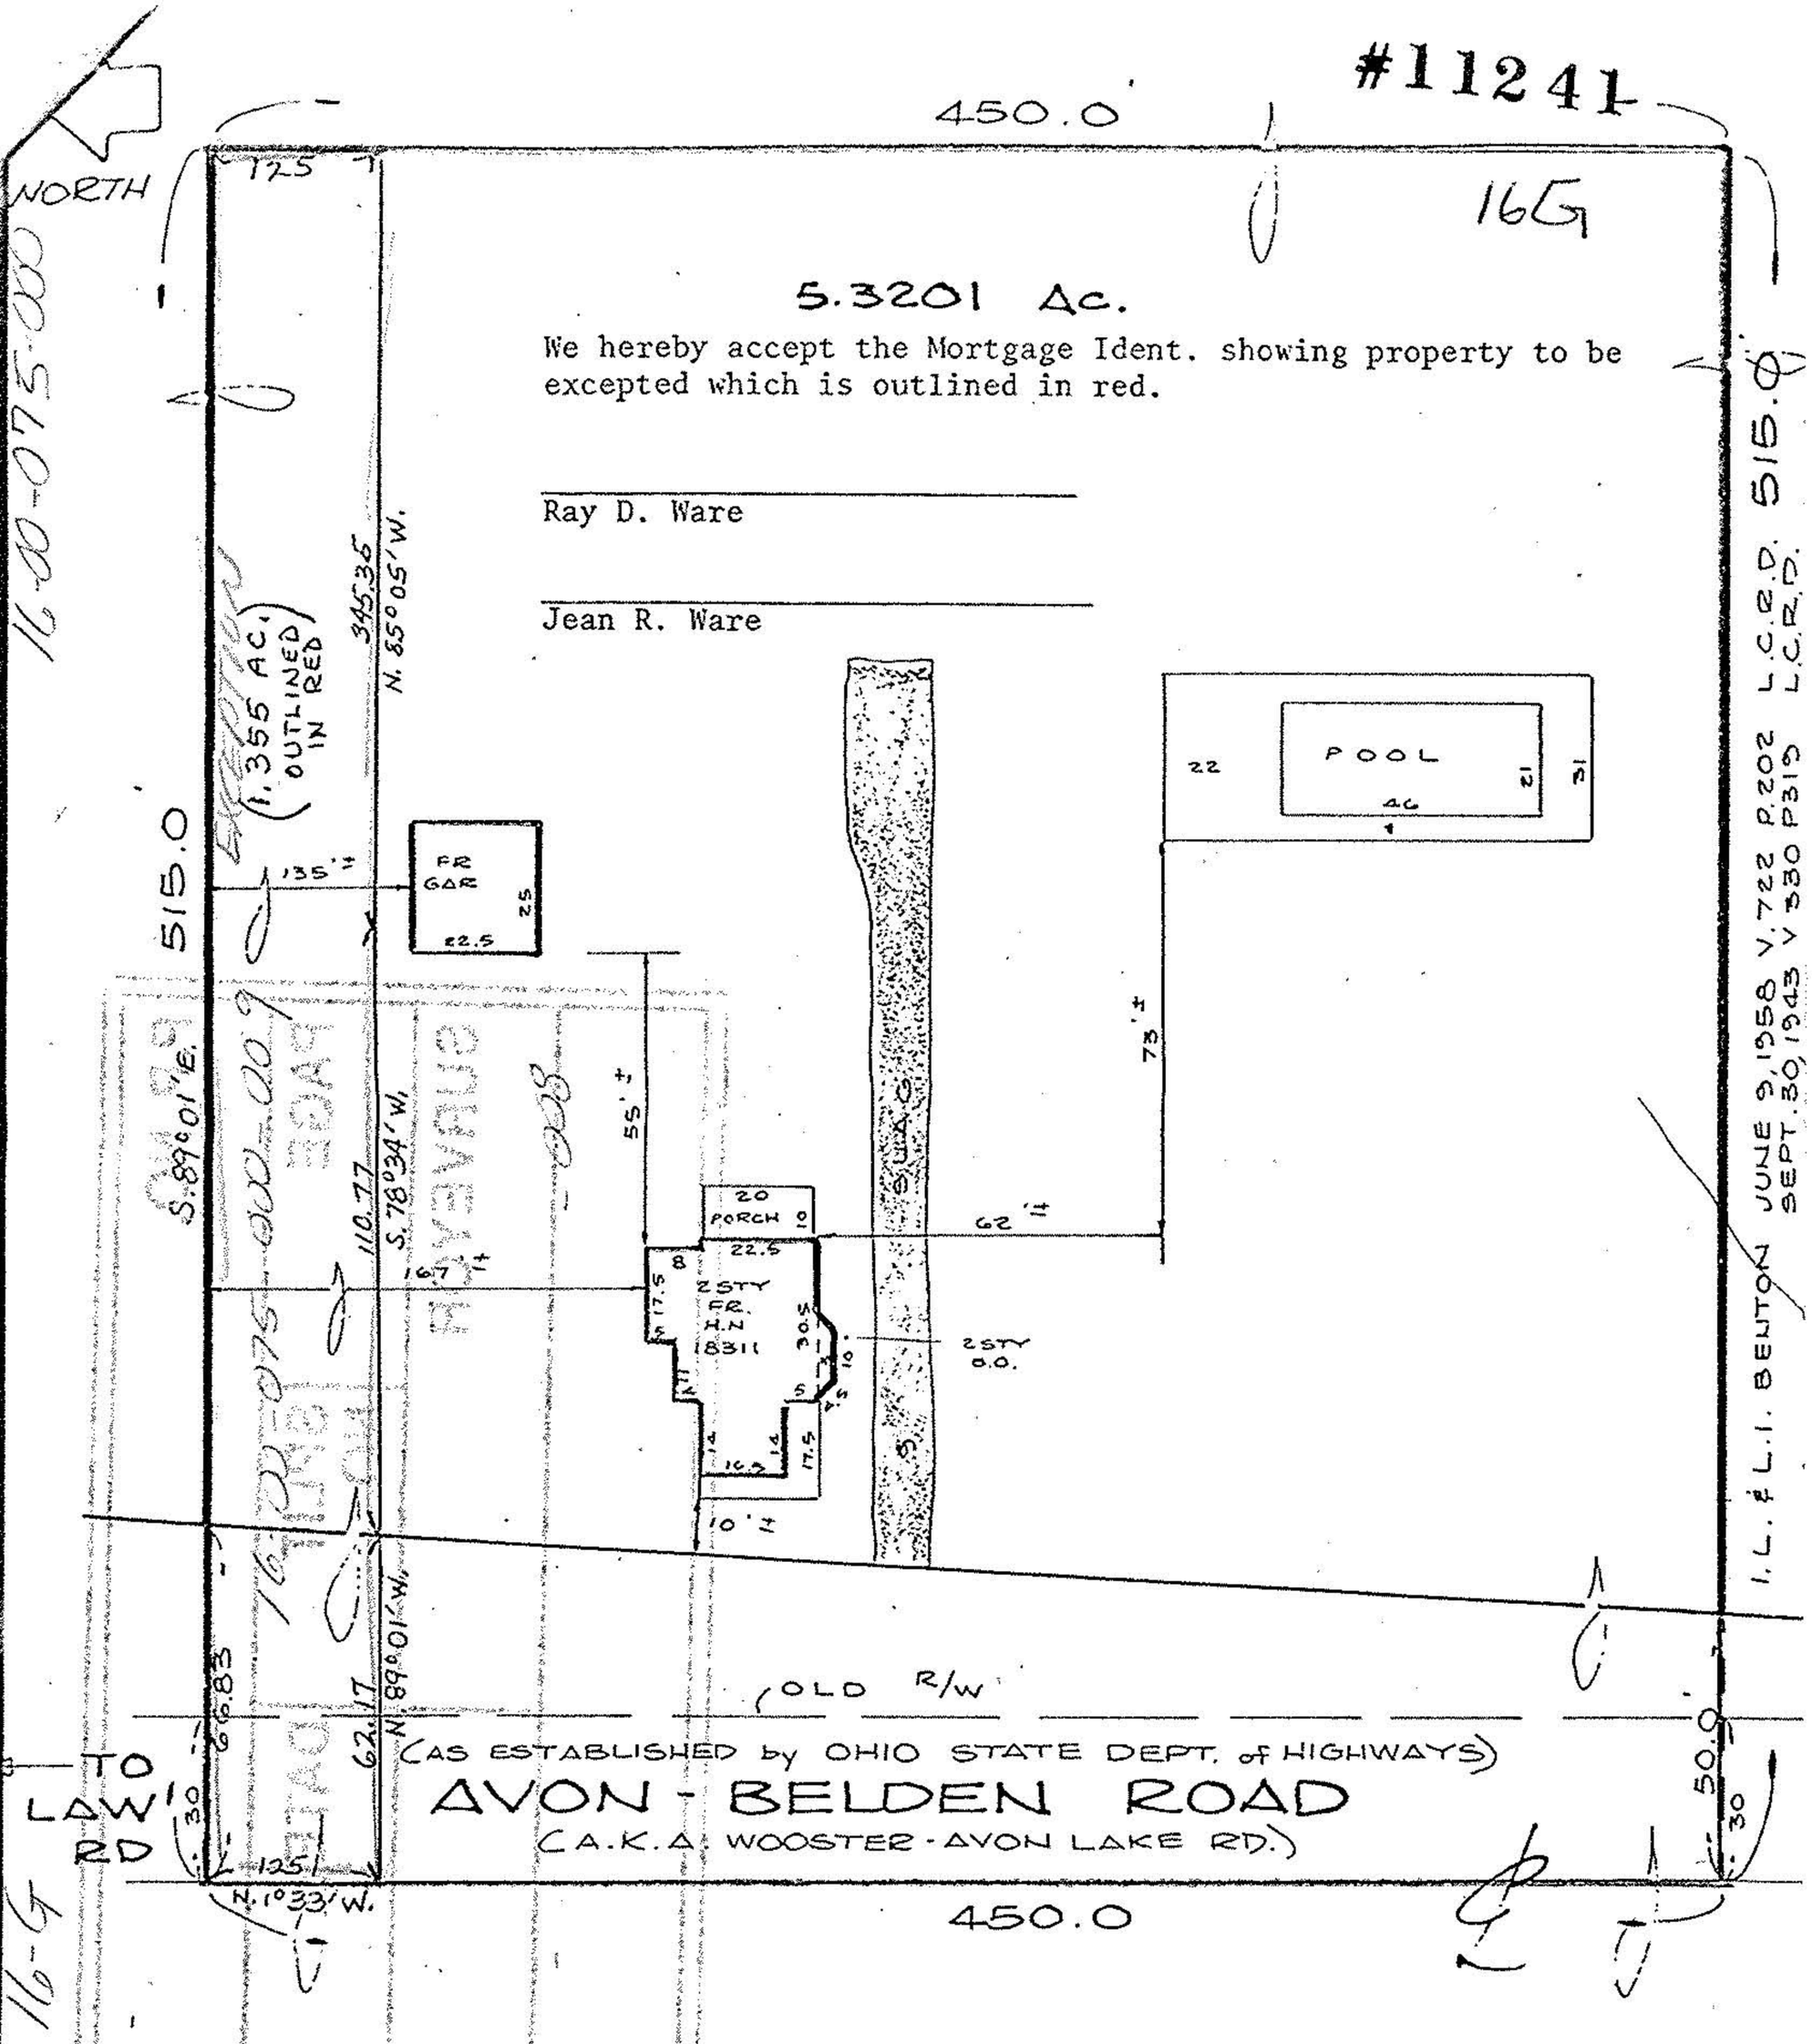

NEFF & ASSOCIATES *Consulting Engineers and Surveyors* CLEVELAND - ELYRIA, OHIO

This MORTGAGEE'S INSPECTION was prepared for IDENTIFICATION PURPOSES for the MORTGAGEE in connection with a new mortgage, and is not intended or represented to be a land or property line survey. NO corners were set. Do not use for establishing fence or building line. No responsibility is extended herein to the present or future land owner or occupant.

SCALE —	1"=40
DATE —	11-10-77
JOB No. —	41971
TITLE No. —	10,003