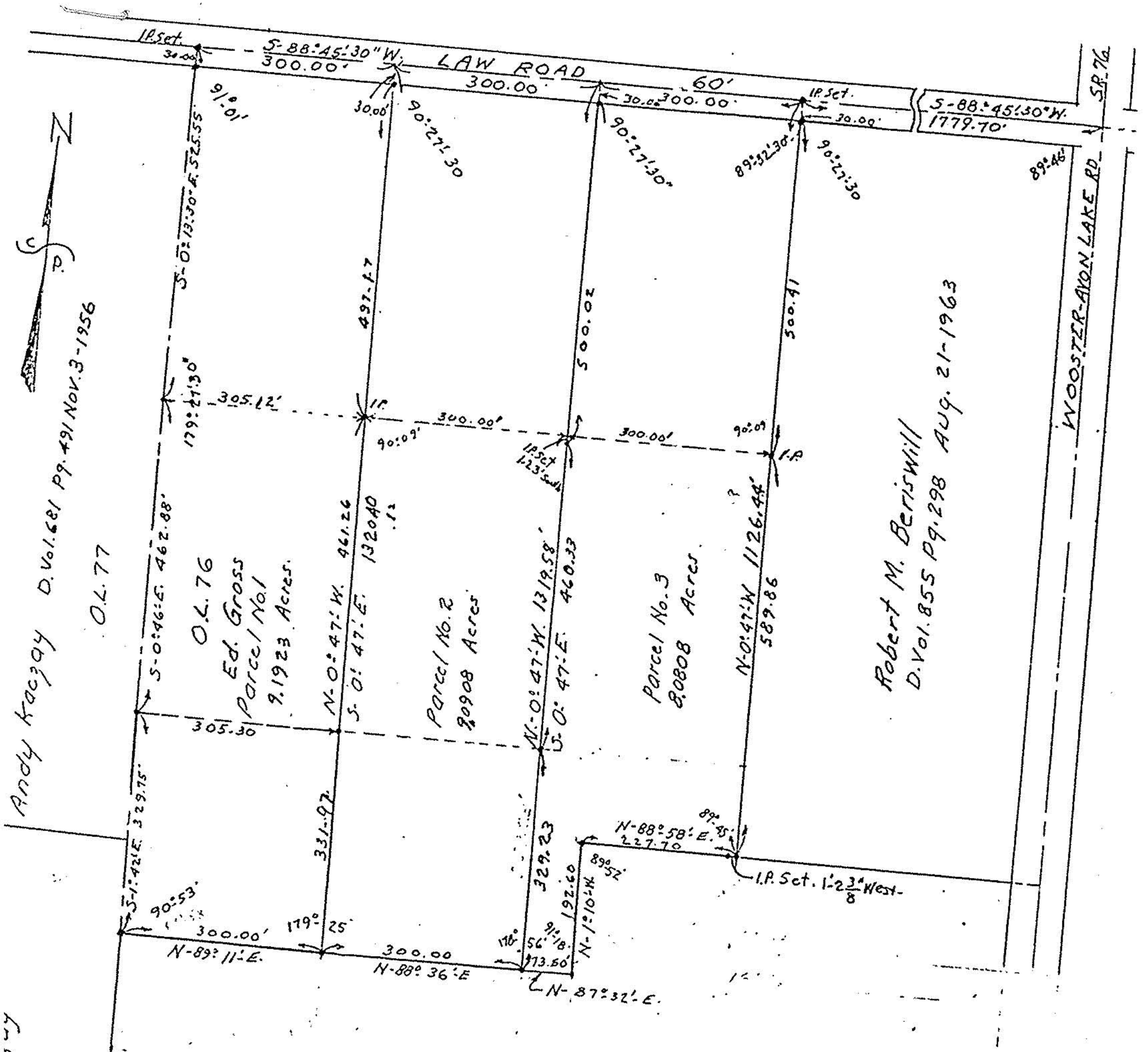

Note:: Iron pins set shown Thus: •

Max. & Irene Joppeck
D.Vol. 414 Page 417 June 18-1947

MAP OF SURVEY FOR
Robert M. Berriswill
ORIGINAL LOT 76 G.RAFTON TOWNSHIP
LORAIN COUNTY OHIO
Scale 1"= 200' April 10-1970
C.E. Penfound Registered Surveyor

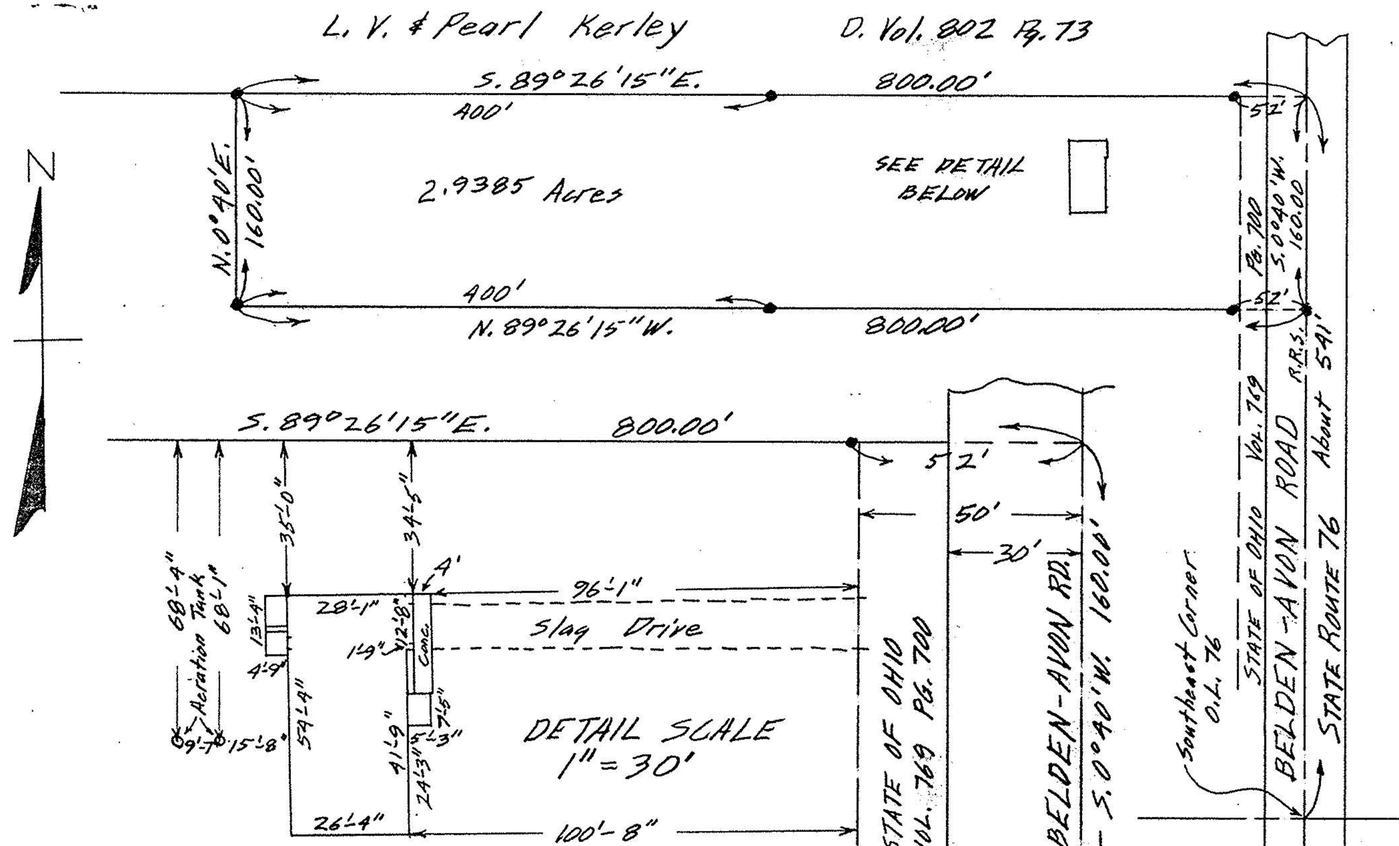

MAP OF SURVEY OF PART OF LAND OF
MILTON W. GATES IN ORIG. LOT NO. 76
GRAFTON TWP. – LORAIN COUNTY – OHIO
MAP SCALE: 1"=100' AUG. 22-1964 5:30 P.M.
Gary E. Penfound REG. SURVEYOR NO. 4457