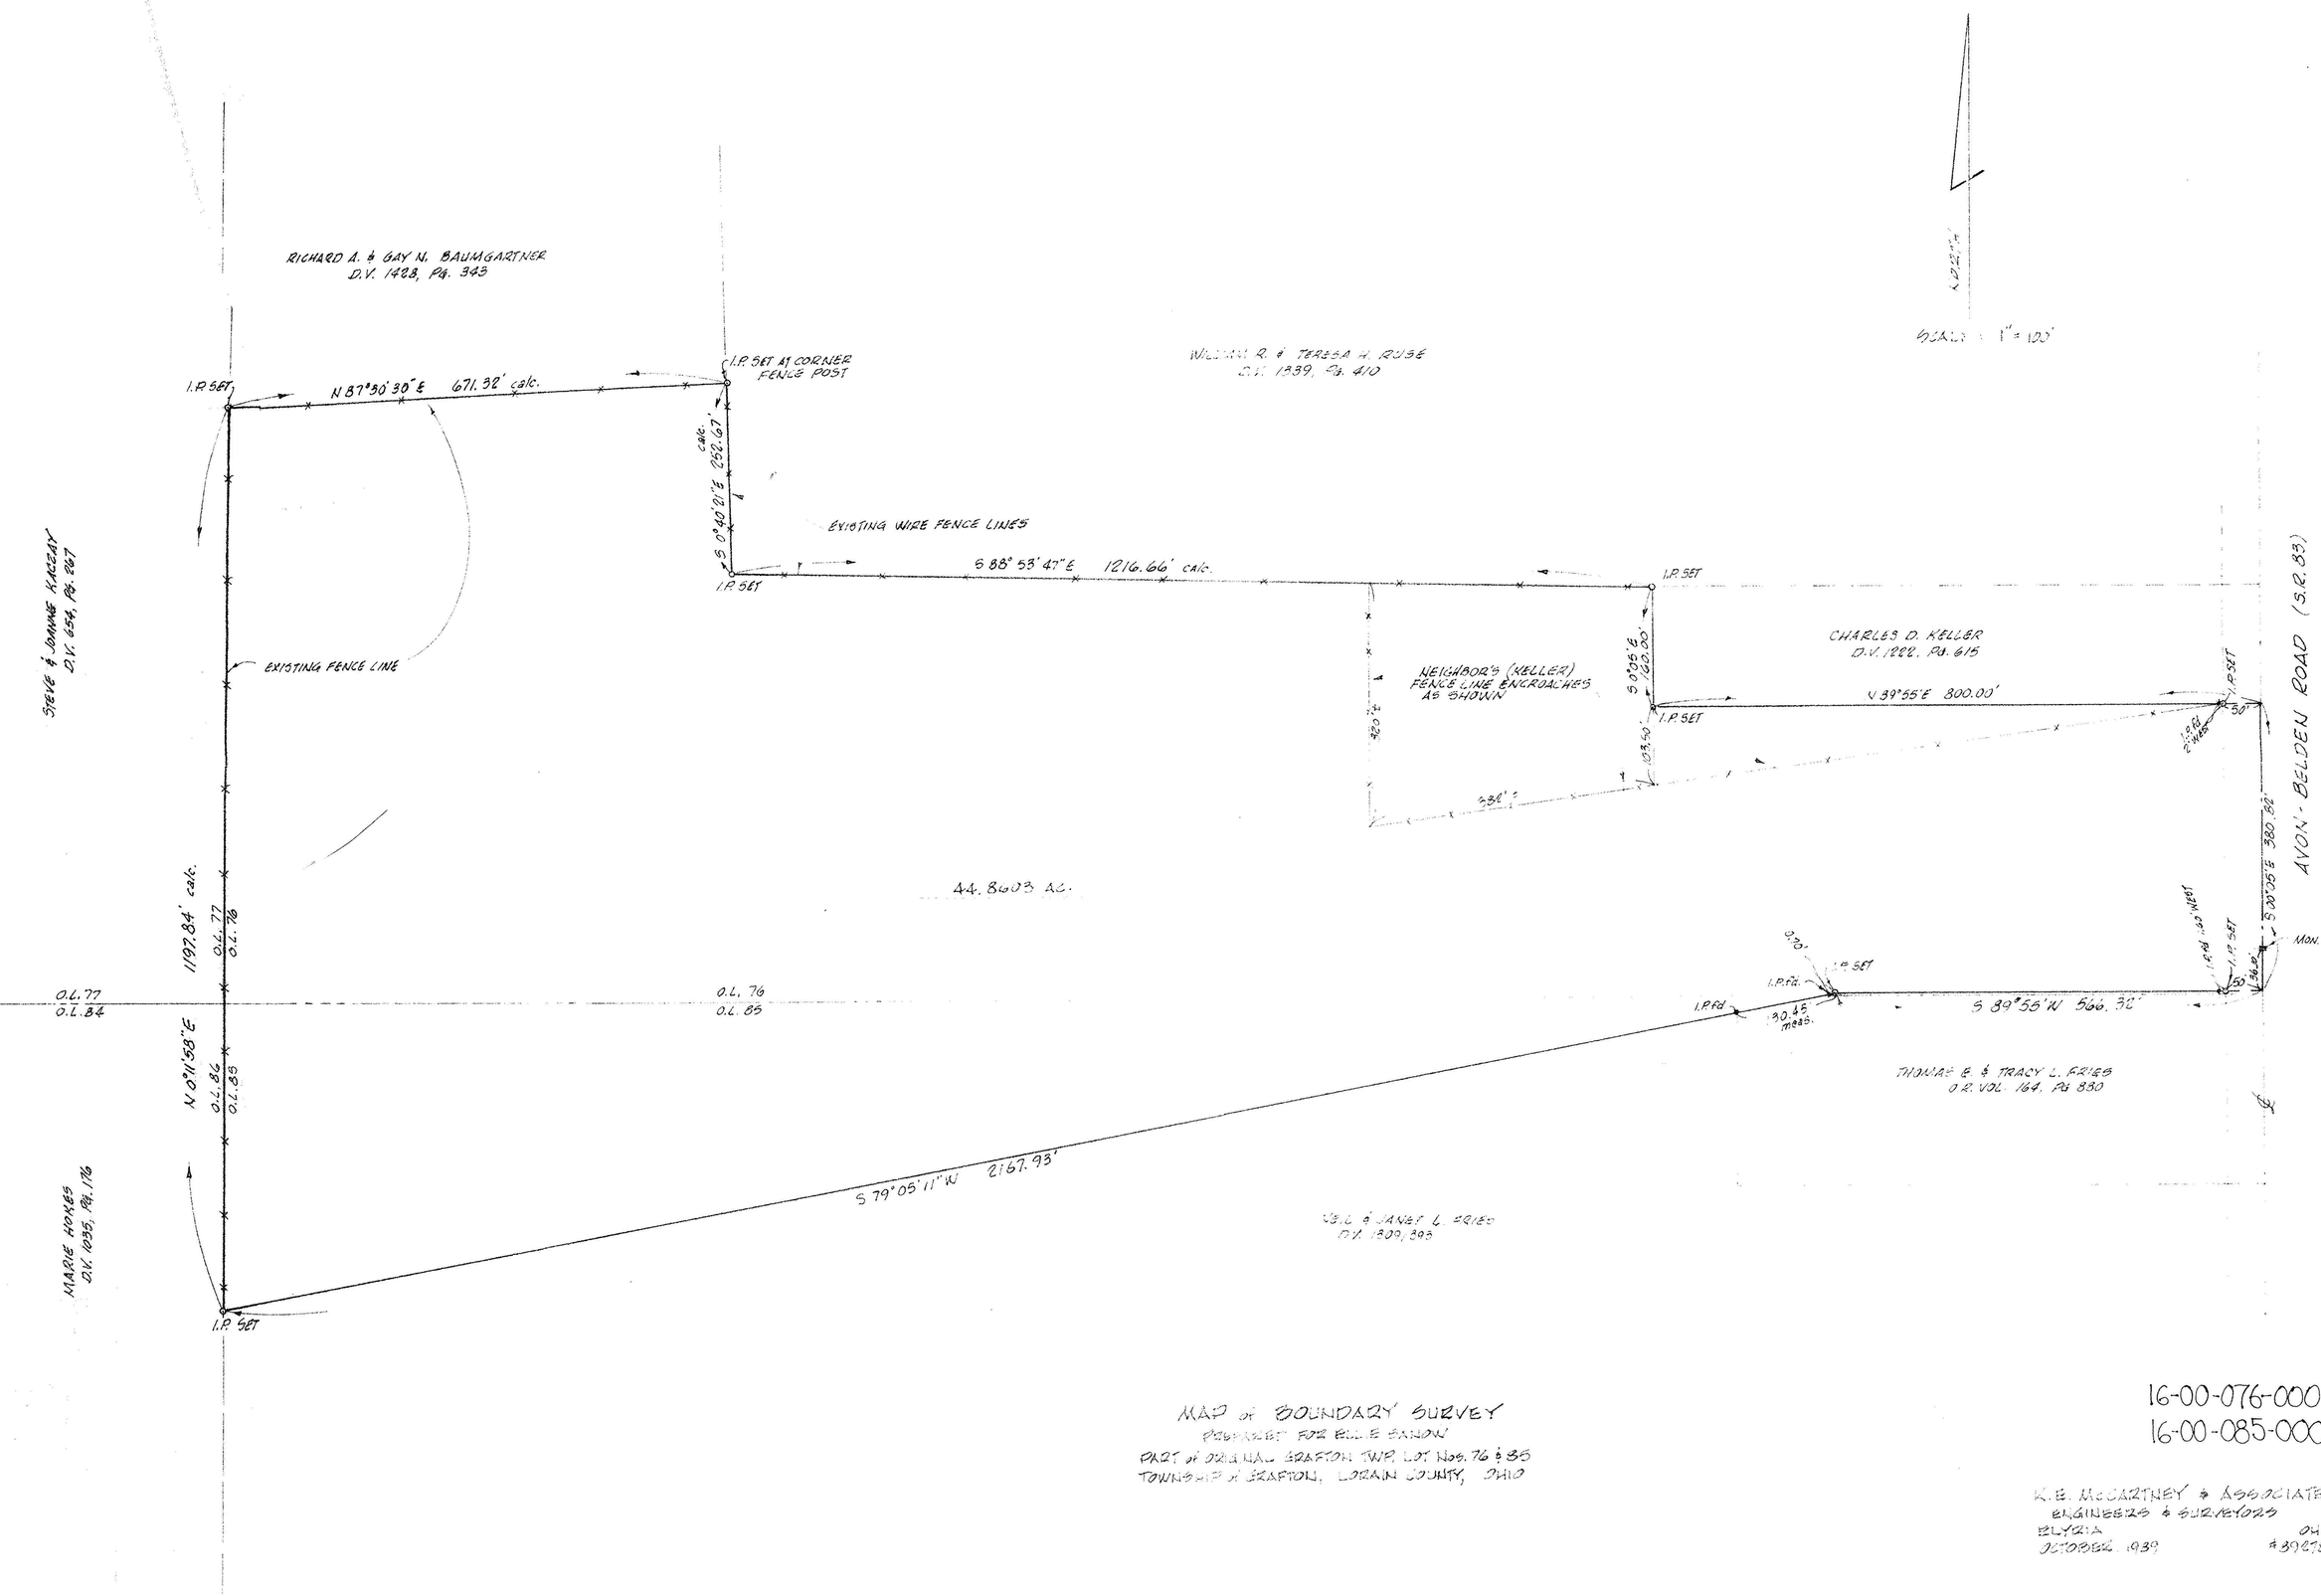

SCALE: 1" = 100'

MAP of BOUNDARY SURVEY
PREPARED FOR ELLE SANDOW
PART of ORIGINAL GRAFTON TWP. LOT Nos. 76 & 85
TOWNSHIP of GRAFTON, LORAIN COUNTY, OHIO

16-00-076-000 –
16-00-085-000 –

K.E. McCARTNEY & ASSOCIATES
ENGINEERS & SURVEYORS
ELYRIA OHIO
OCTOBER, 1989 #89C137

#18798 A

APPROVED LORAIN CO. MAP DEPT.	
DATE	5-29-90
PAGE	16-F
BY	CAROLYN FRANCIS
VOID AFTER #	18798A