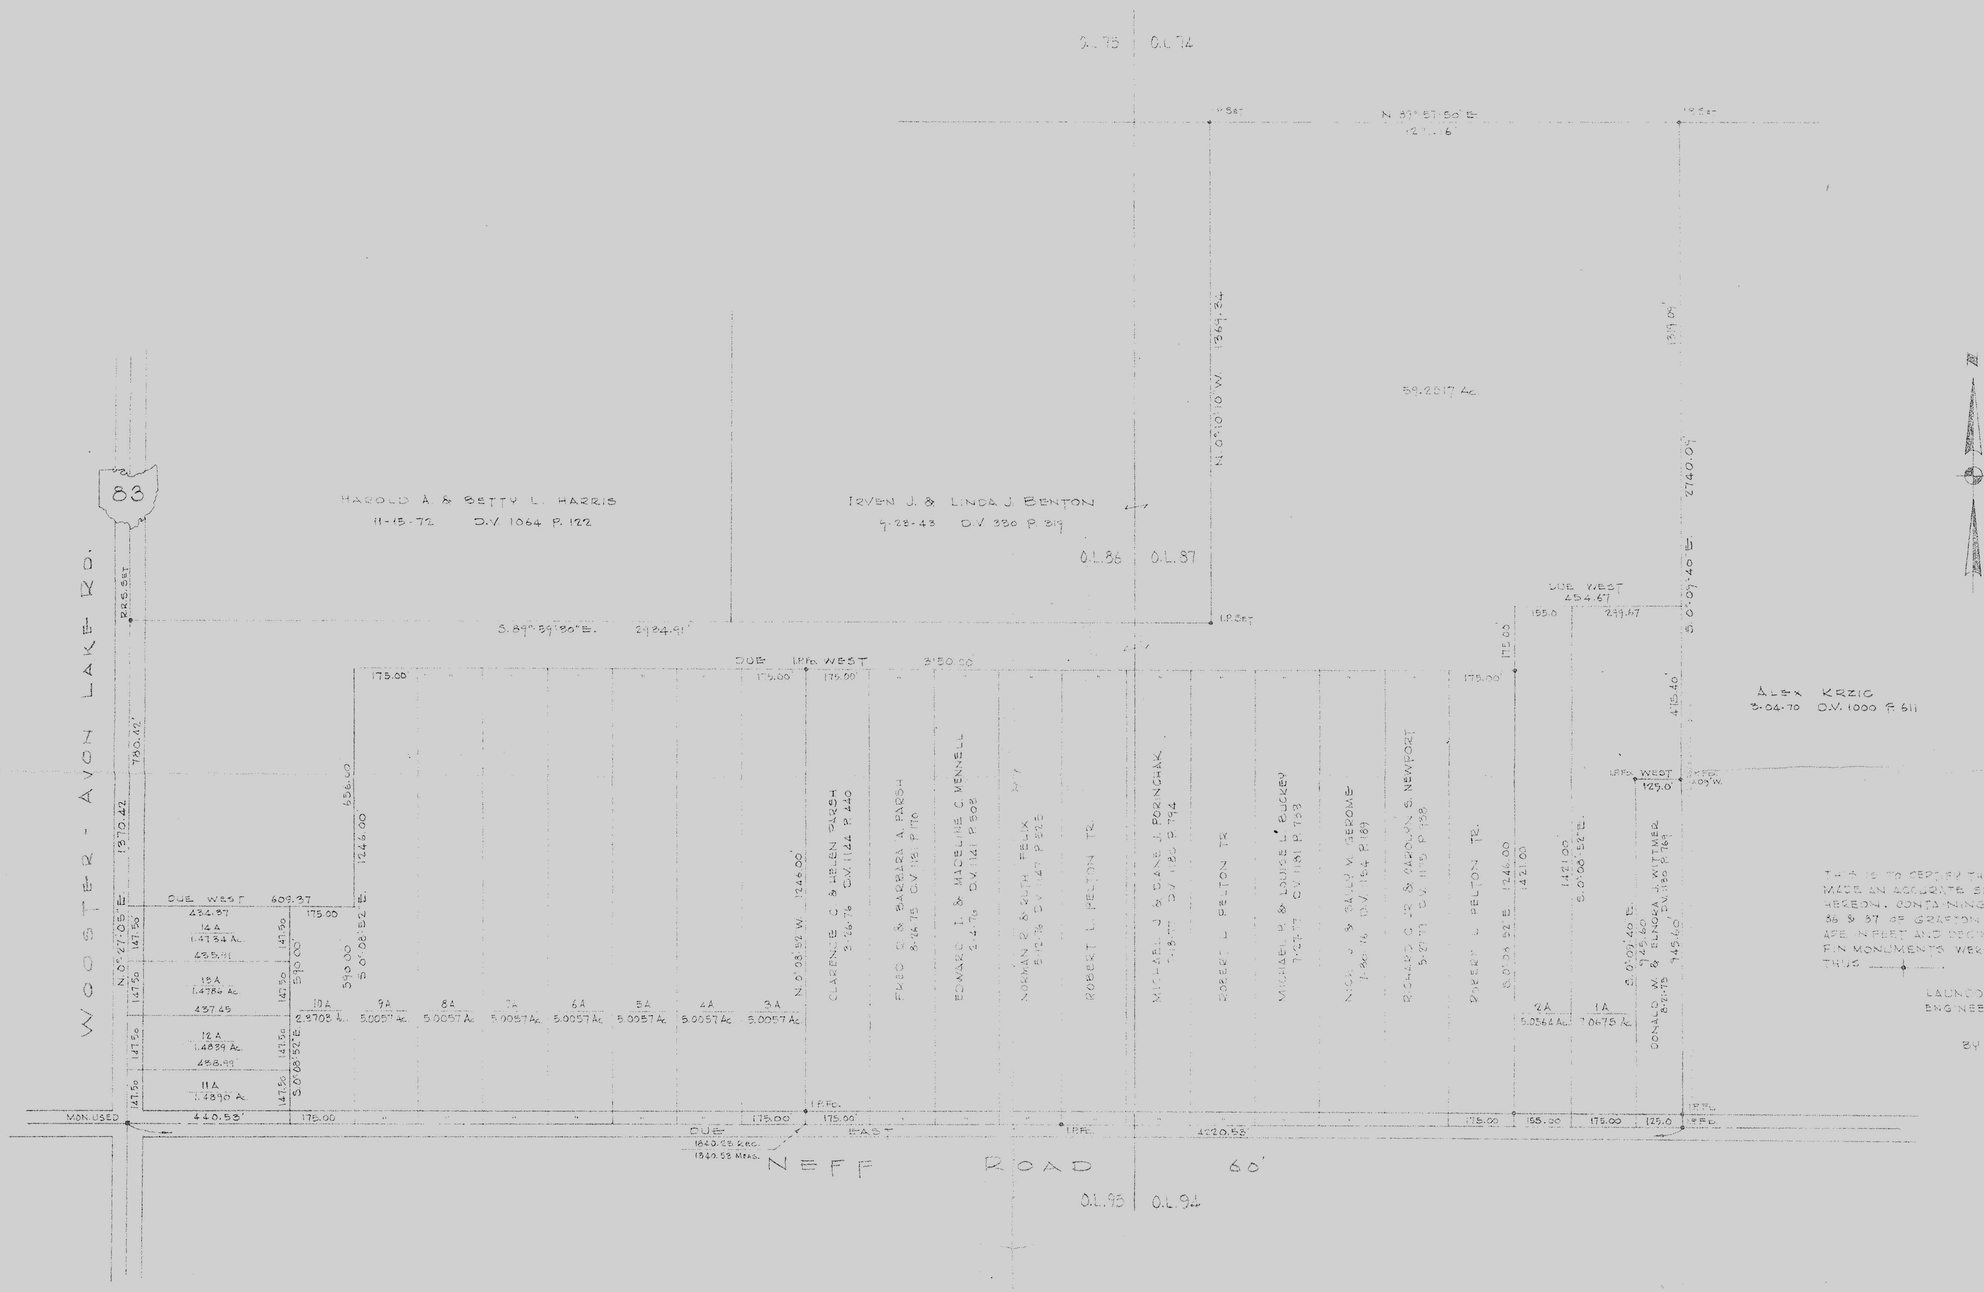

THIS IS TO CERTIFY THAT IN NOVEMBER OF 1977, WE MADE AN ACCURATE SURVEY OF THE LANDS SHOWN HEREON, CONTAINING 114.7105 ACRES IN O.L.S 86 & 87 OF GRAFTON TOWNSHIP. MEASUREMENTS ARE IN FEET AND DECIMAL PARTS THEREOF. IRON PIN MONUMENTS WERE FOUND OR SET SHOWN THUS ——●——.

LAUNDON • SIMON • CAHL & ASSOC.
ENGINEERS SURVEYORS
BY Rudolph Simon
REG. SURVEYOR No. 5101

ACREAGE BREAKDOWN	
O.L. 86	60.22 Ac.
O.L. 87	54.49 Ac.

SURVEY OF LANDS OF RUTH V. MOHR ET AL
FOR
BIREX DEVELOPMENT CO. INC.

PART OF O.L.S 86 & 87 — GRAFTON TOWNSHIP
LORAIN COUNTY — OHIO
SCALE 1"=200' — OCTOBER, 1977

LAUNDON • SIMON • CAHL & ASSOC.
ENGINEERS SURVEYORS
JOB No. 77-677 F.B. 174-52

Revised 12-06-77 Pts 1A & 2A R.G.S.
Revised 11-15-77 Pt. 13A R.G.S.

SHEET 1 OF 1

86