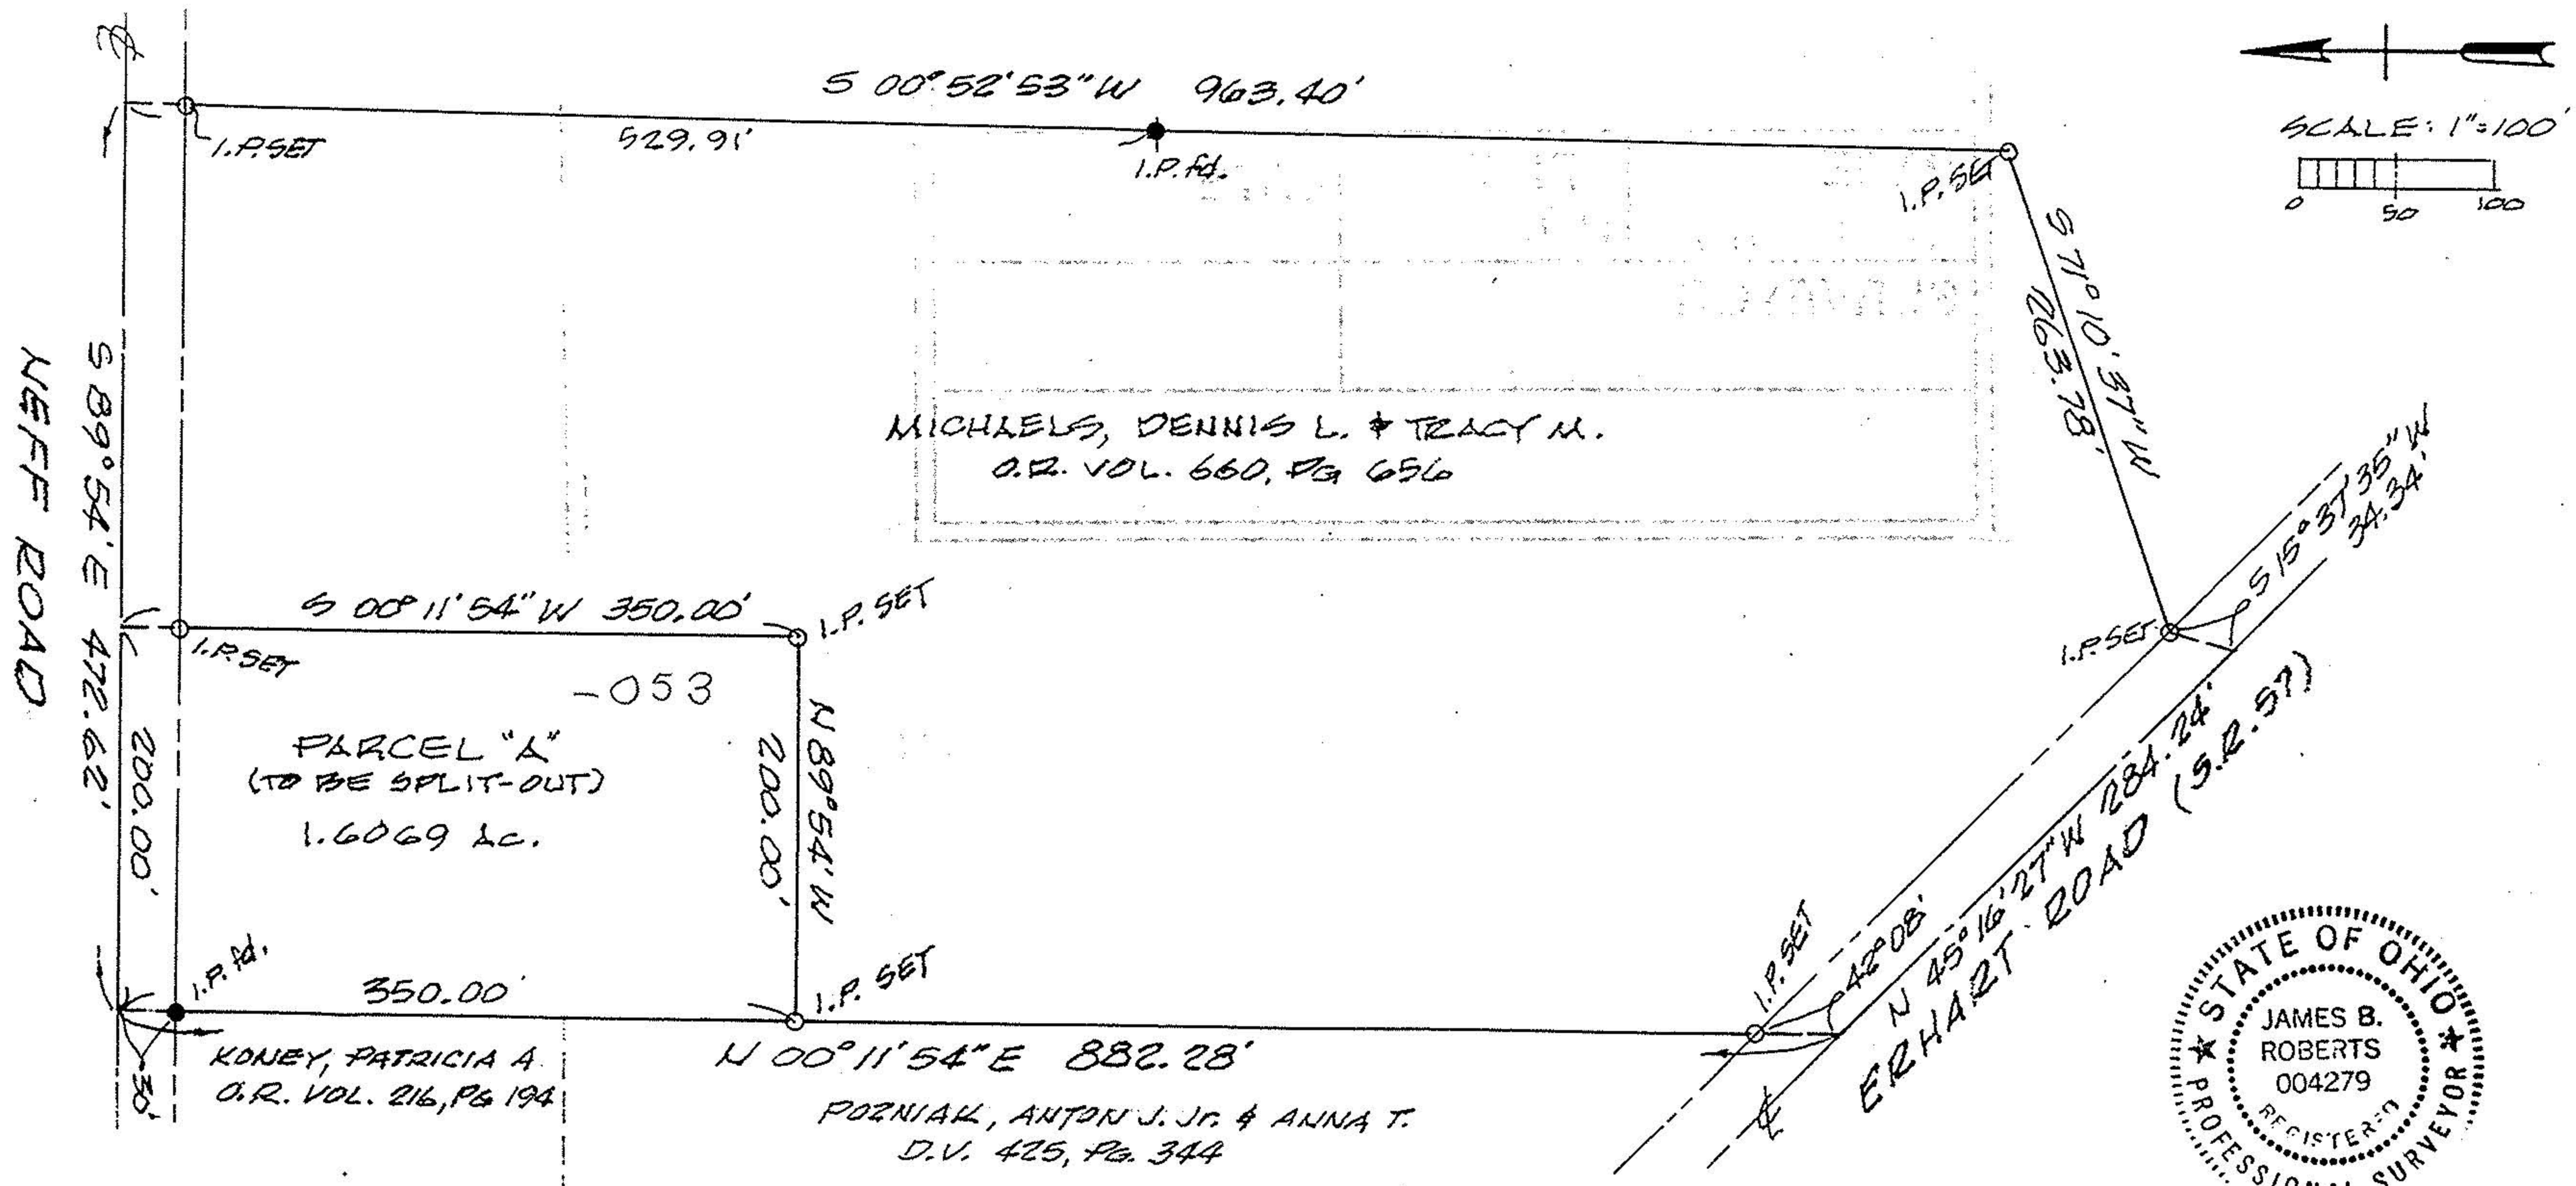

MAP of SURVEY

PREPARED FOR DENNIS & TRACY MICHAELS

PART of ORIGINAL GRAFTON TWP. LOT 91

TOWNSHIP of GRAFTON, LORAIN COUNTY, OHIO

REF: PP # 16-00-091-000-024

K.E. McCARTNEY & ASSOCIATES INC.

ENGINEERS & SURVEYORS

ELYRIA OHIO

AUGUST, 1994 #935253