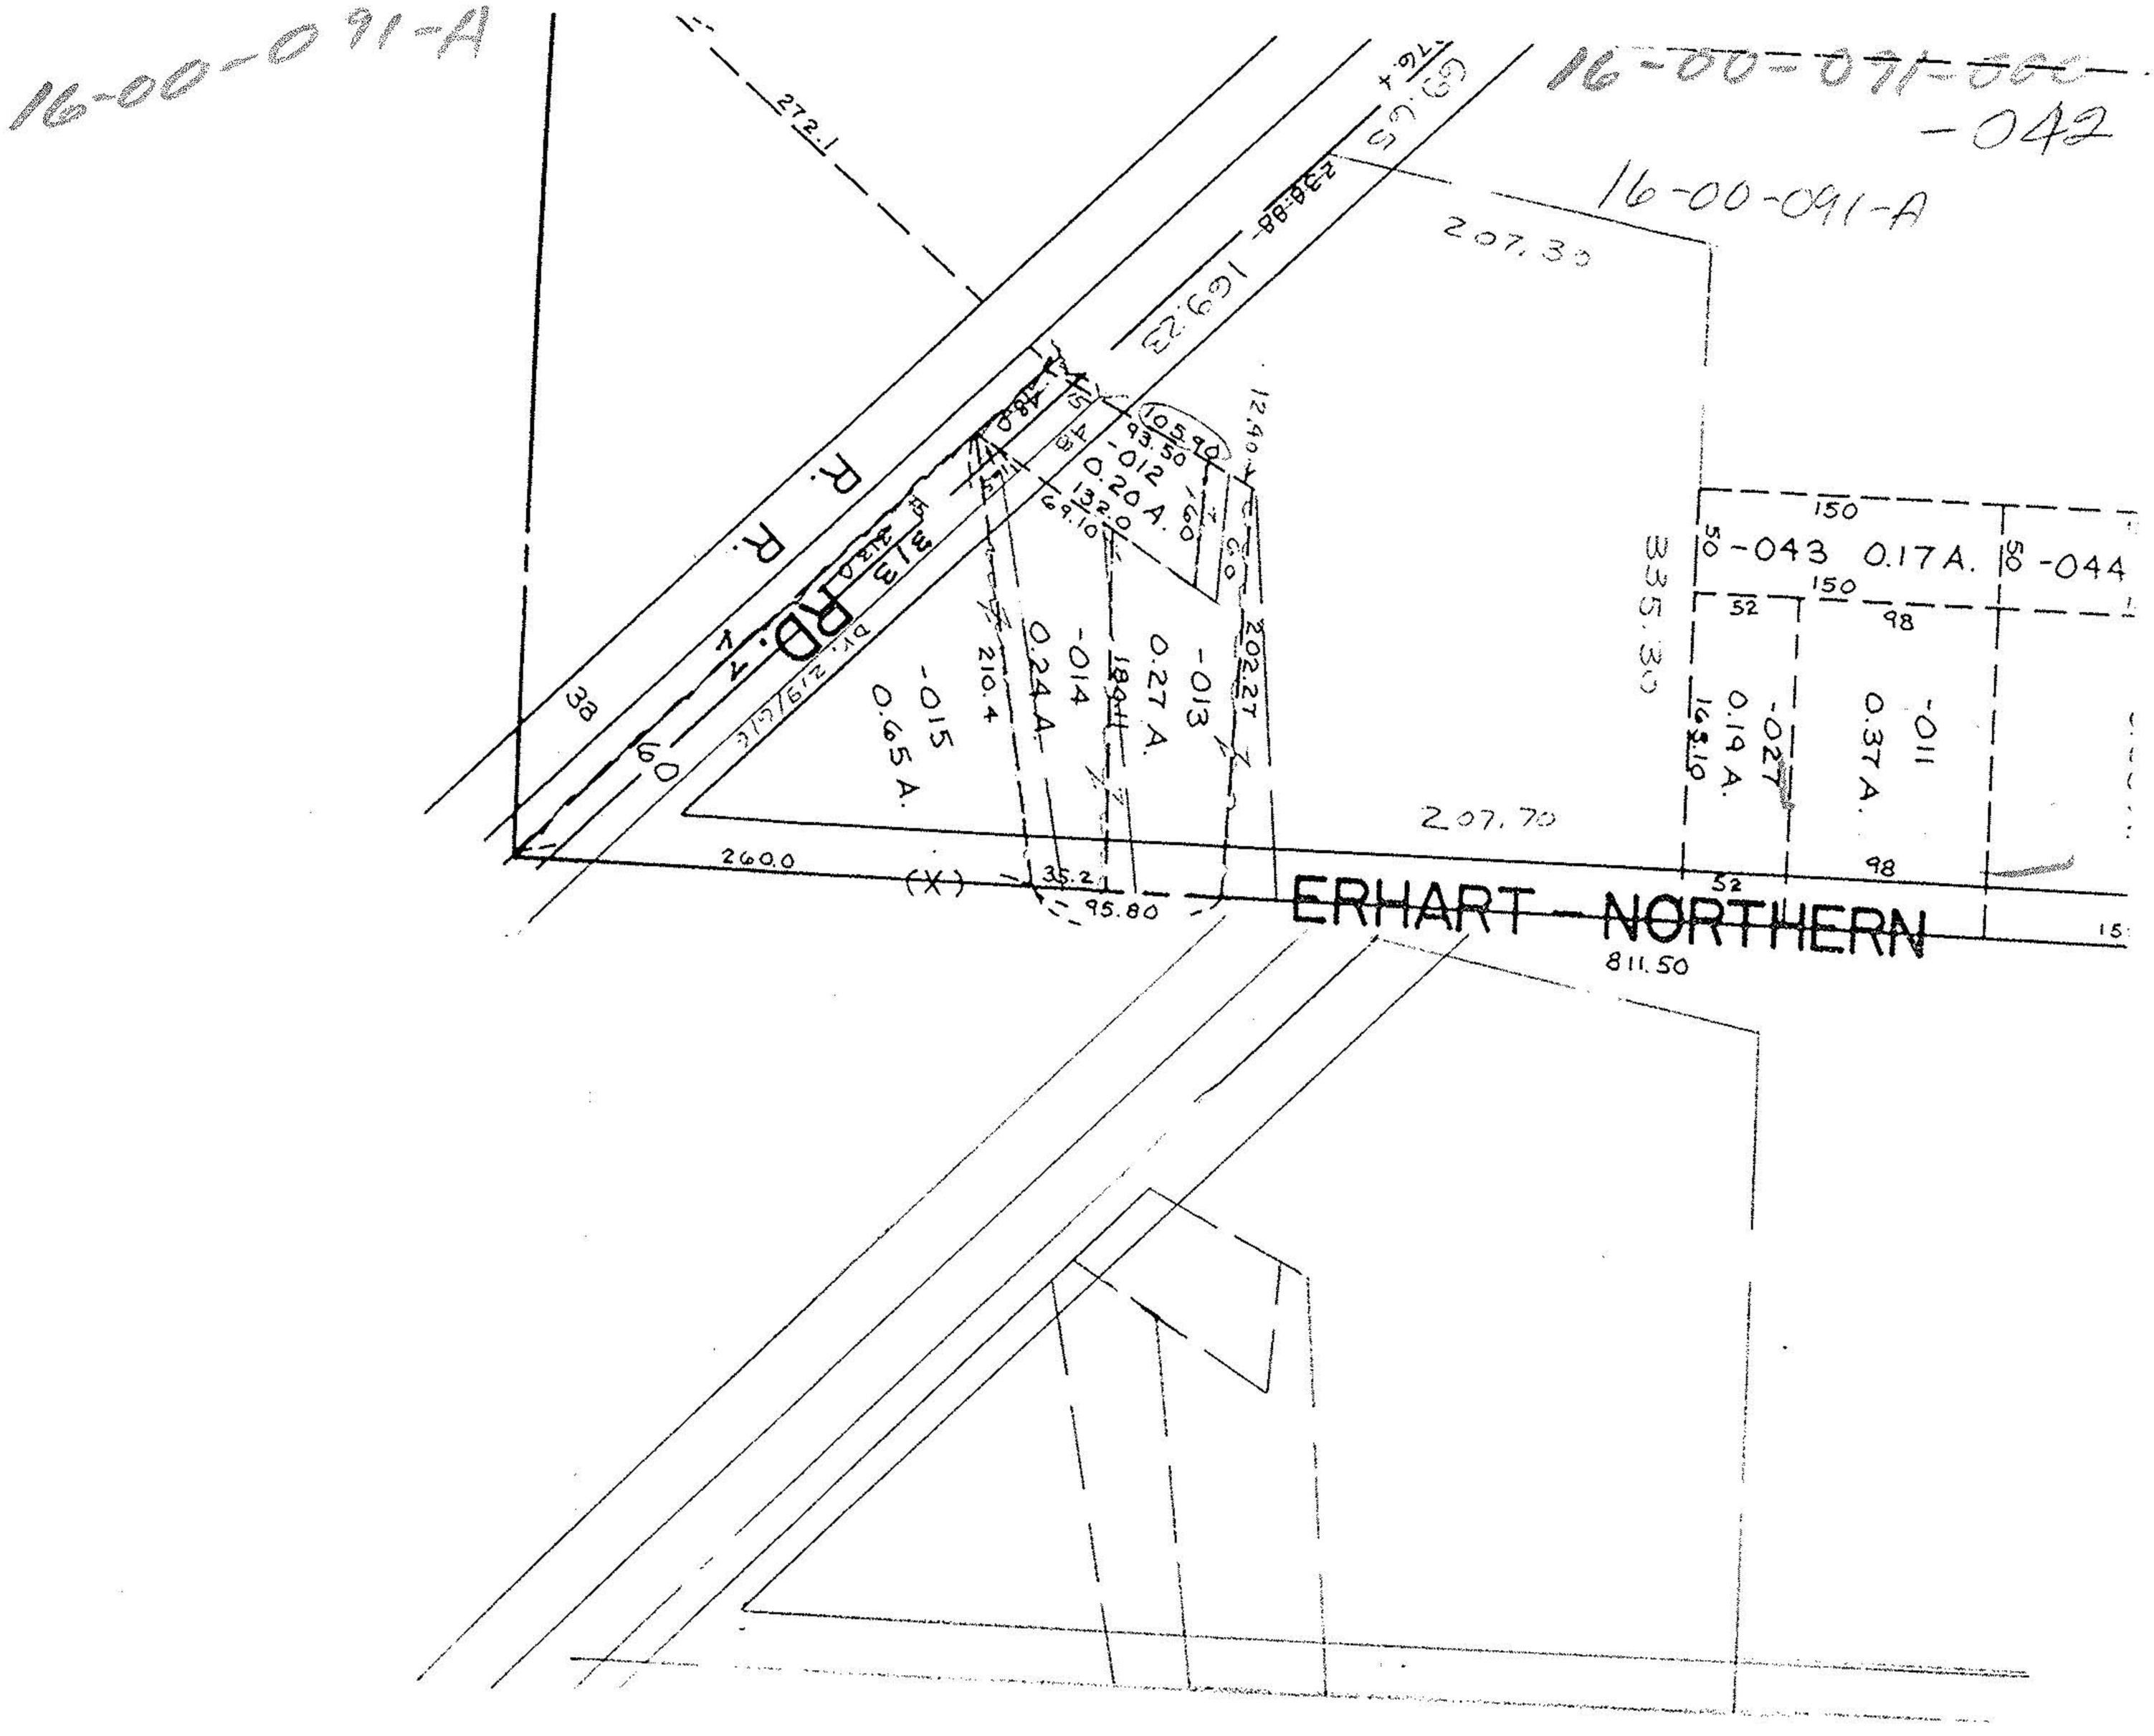
16-00-091-A
16-00-091-000
-042
16-00-091-A
272.1
69.65
238.88
169.23
207.30
R. R.
RD. 1
313
212.0
38
60
105.90
93.50
-012
0.20 A.
132.0
69.10
12.40
-013
0.27 A.
-014
0.24 A.
-015
0.65 A.
210.4
202.27
335.30
150
50
-043
0.17 A.
50
-044
150
52
98
-011
0.37 A.
-027
0.19 A.
163.10
207.70
260.0
(X)
35.2
95.80
52
98
ERHART - NORTHERN
811.50