

Wooster Avon Lake SE 83

Divol 561 Pg 299
Walter Odon

Ruth Billman Divol 1312 Pg 203

S 89° 28' 33" E

249.95 249.95 299.95

Michael J &
Rose M
Sutmaier

N 1° 9' 14" E
1680.10'
9.633 Acres

S 16° 51' 14" W
1677.80'
Roger & Cynthia J. Smith
OR Pg 597

David J & Christine
Gredlock OR Pg 729

#18641

APPROVED
LORAIN CO.
MAP DEPT.

DATE 9-20-89


PAGE 16-G

CAROLYN
BY FRANCIS

VOID
AFTER # 18641

Edmond & Leona
Toll
26.82 acres
Remainder

567.10
016.94

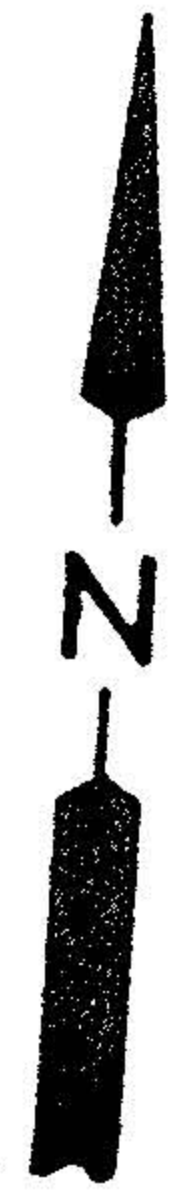

Dunham Rd

N 30° 25' 00" W 250.00
S 89° 49' 26" W

30'
300'
30'
833.89'
RRS A 1383.89'

IP 219.8'
Lorain County
RRSfd Medina County

- iron pipes fd
- o iron pipes set

John Poznywak
Reg Surveyor 5292

Survey of Parcel Split
Toll Property
Part of Original Lot 95
Grafton Township
Lorain County Office
Scale 1"=400' Aug 22, 1989