LAUNDON · SIMON · CAHL & ASSOC. INC.
CONSULTING ENGINEERS & SURVEYORS
219 COURT ST. ELYRIA, OHIO 44035

SURVEY FOR:
MARK LINDEN

Orig. Lot 3	City of	Date AUG. '91 Scale 1"= 100
Orig. Sec	Village of GRAFTON	Dwn. by R.G.S. Chkd. by R.C.
Tract	County of LORAIN	Job No. 91-2057 F.B.
Township of GRAFTON	State of OHIO	Printed
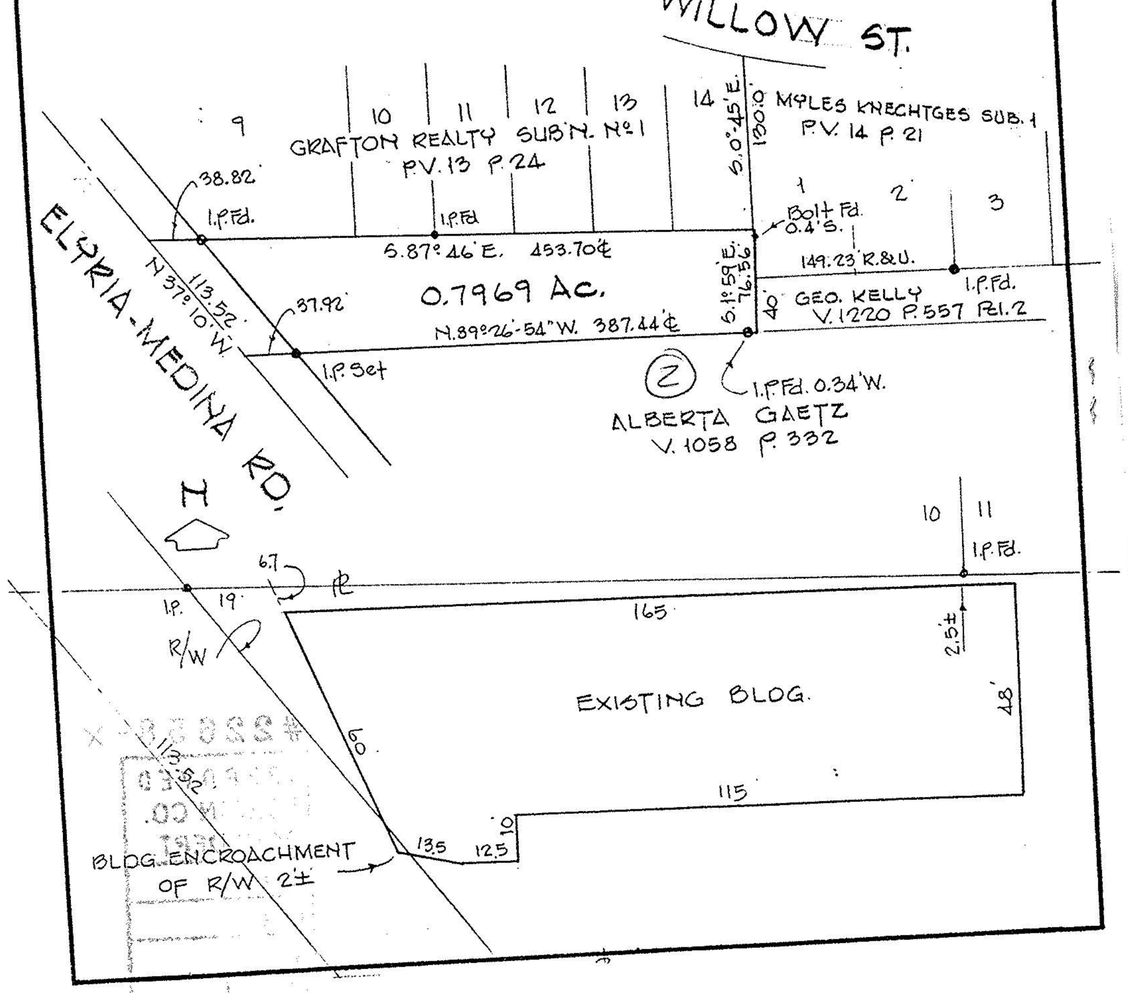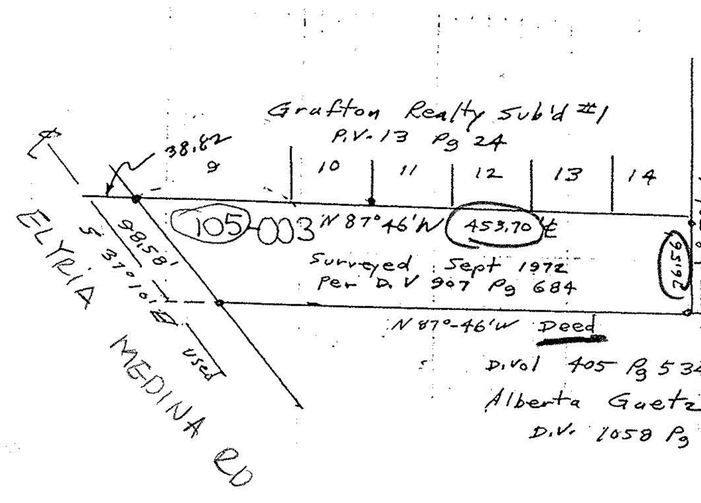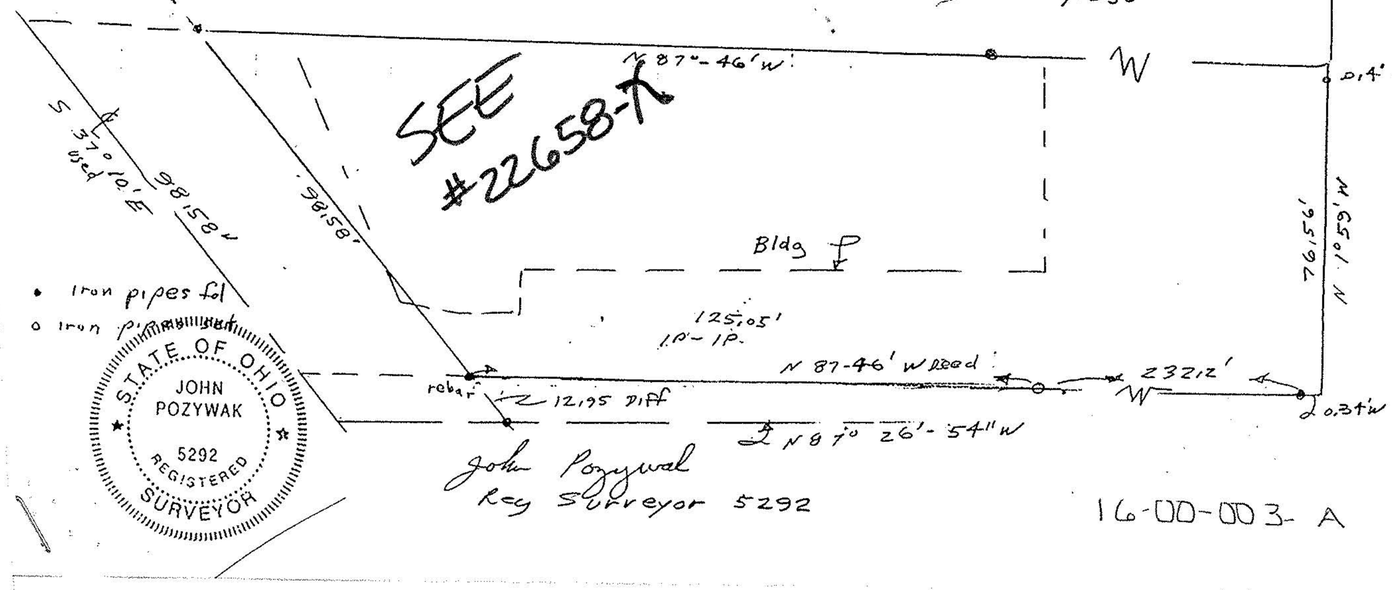
DEED OF REF. D.V. 68 P. 50 (1892)