


1600 00-003-104
1600 00-003-105

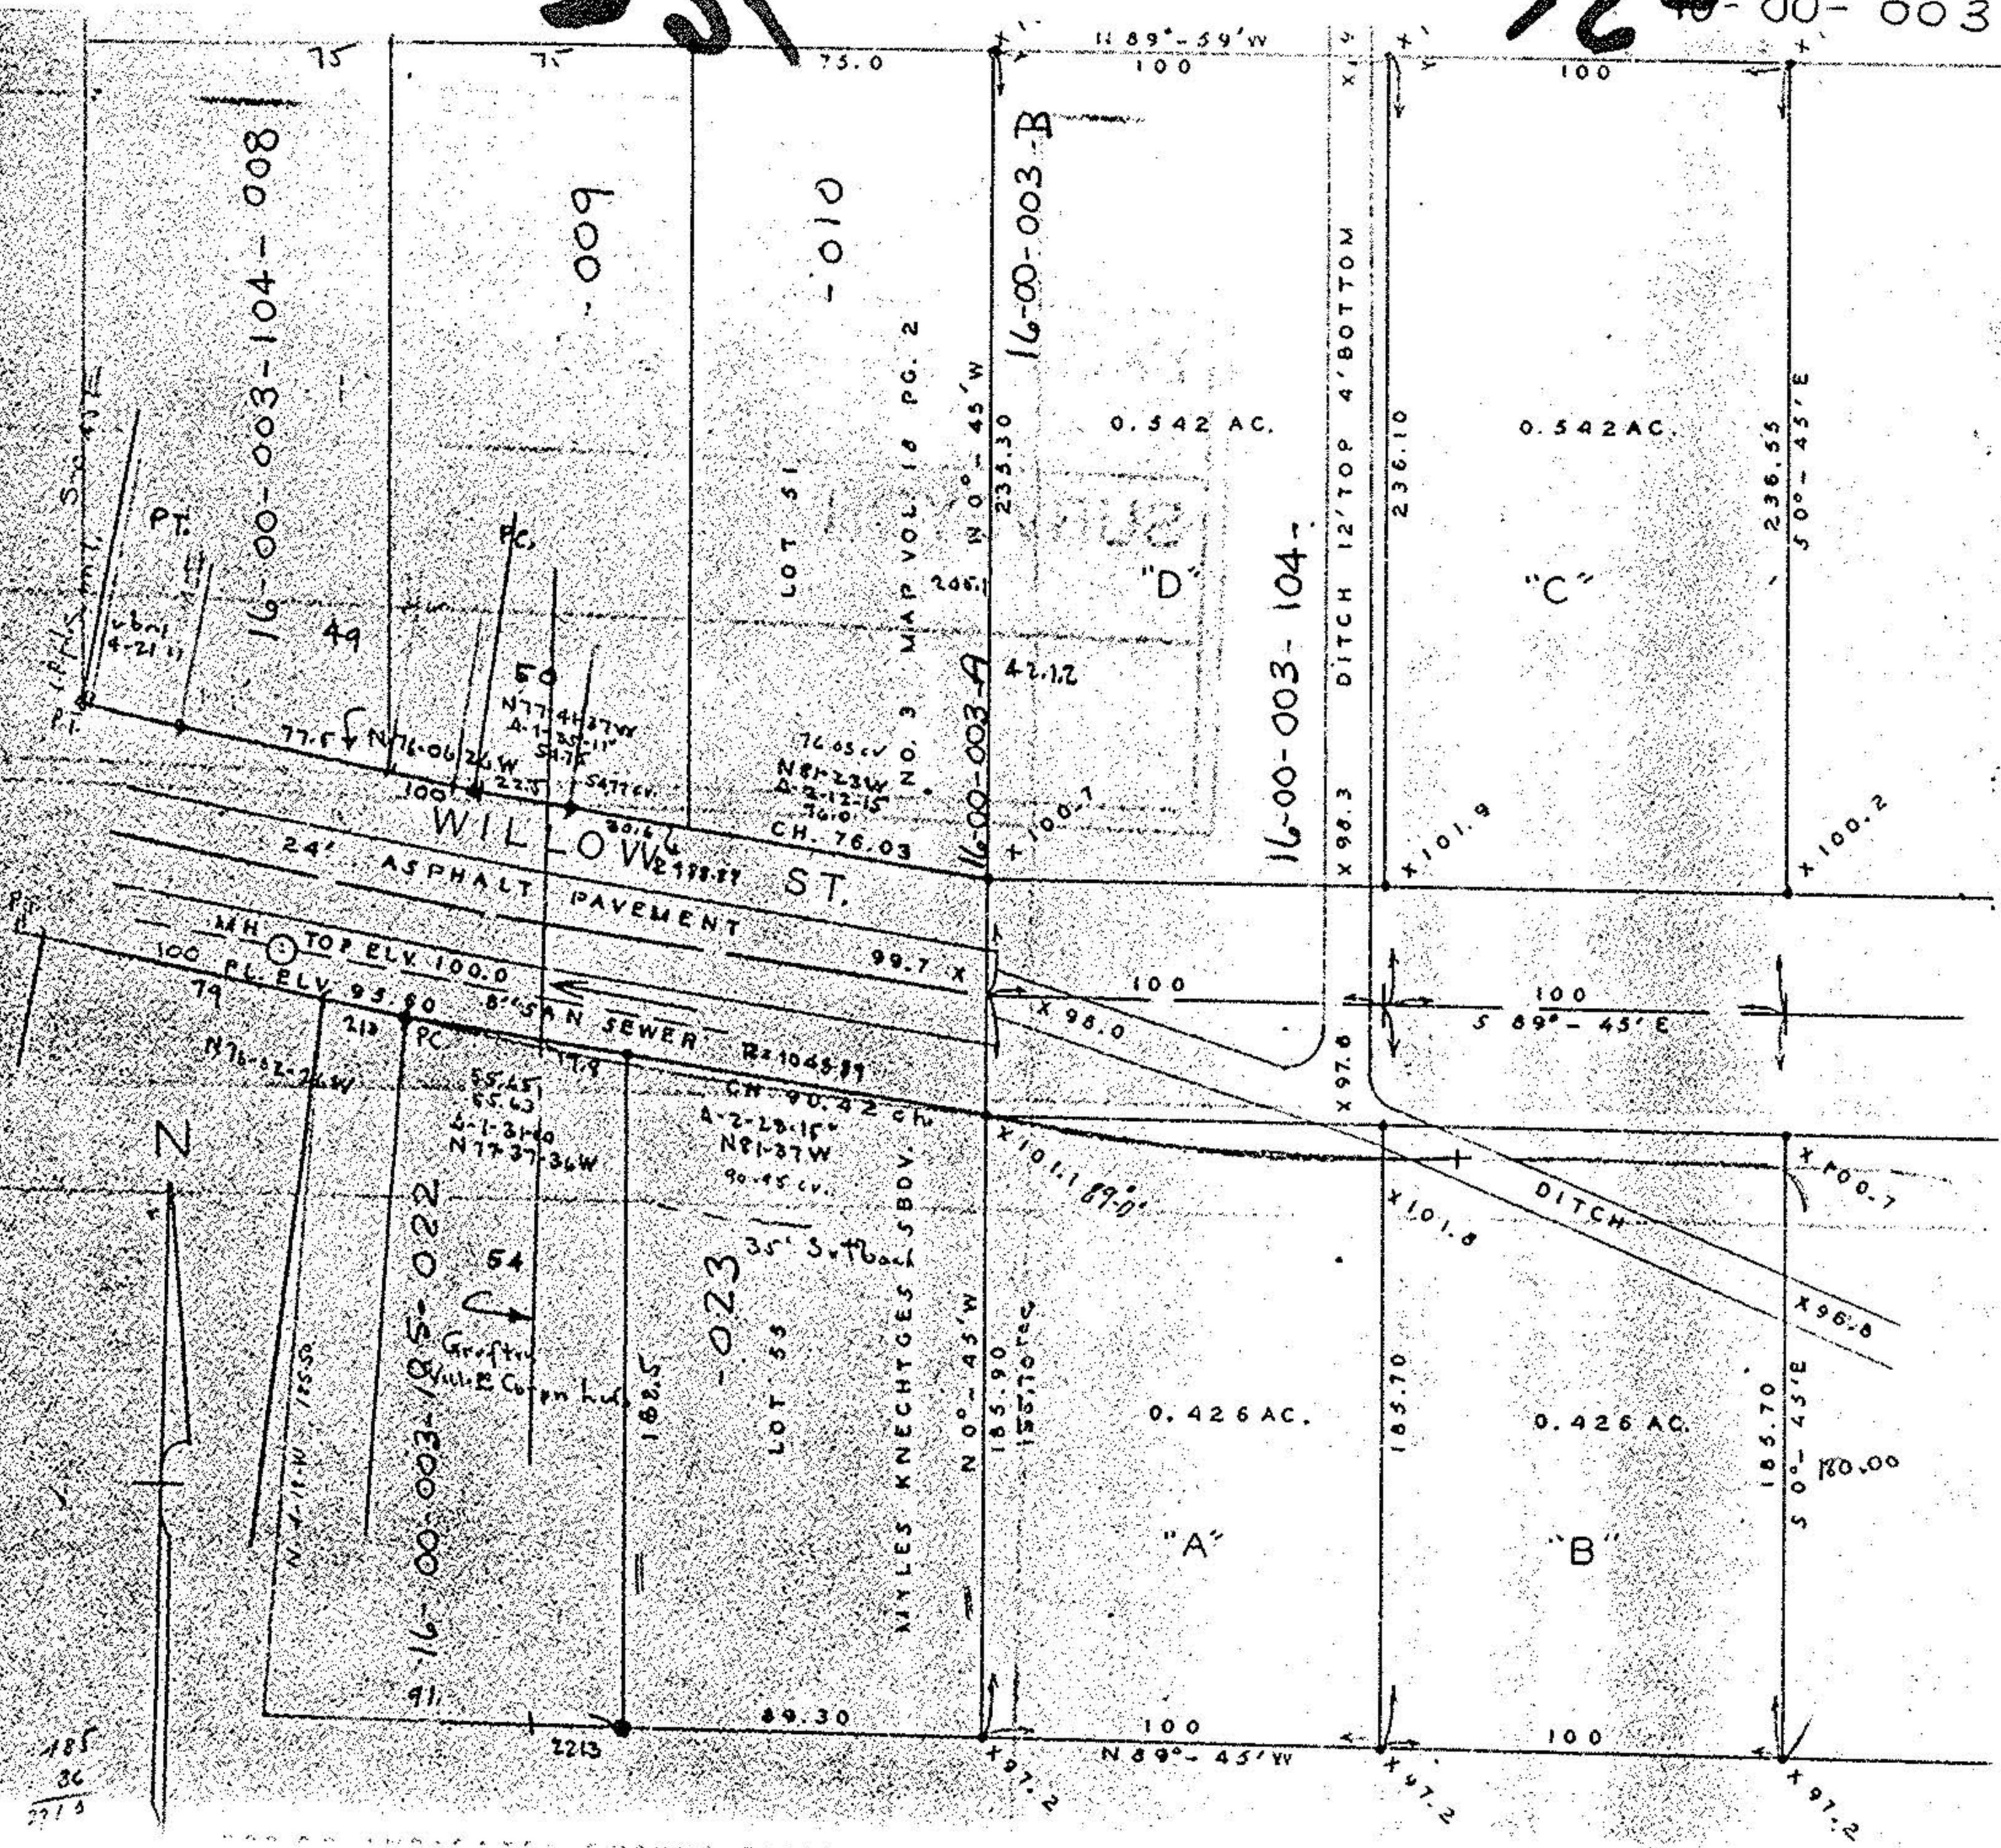

185
36
2713