16-D #13935 16-00-011-000

PLAT OF SURVEY

County of LORAIN State of Ohio
Township GRAFTON
Twp. lot 11 Tr. or Sec.
City or Village Lot
Subdivision Lot
Prop. Owner BELL
Date NOV. 1980 Scale 1"=200'

By. Charles A. Rolling
REG. OHIO SURVEYOR No. 5569

#13935

APPROVED
LORAIN CO.
MAP DEPT.
DATE 11-21-80
PAGE 16-D
BY Carolyn
VOID AFTER 13935

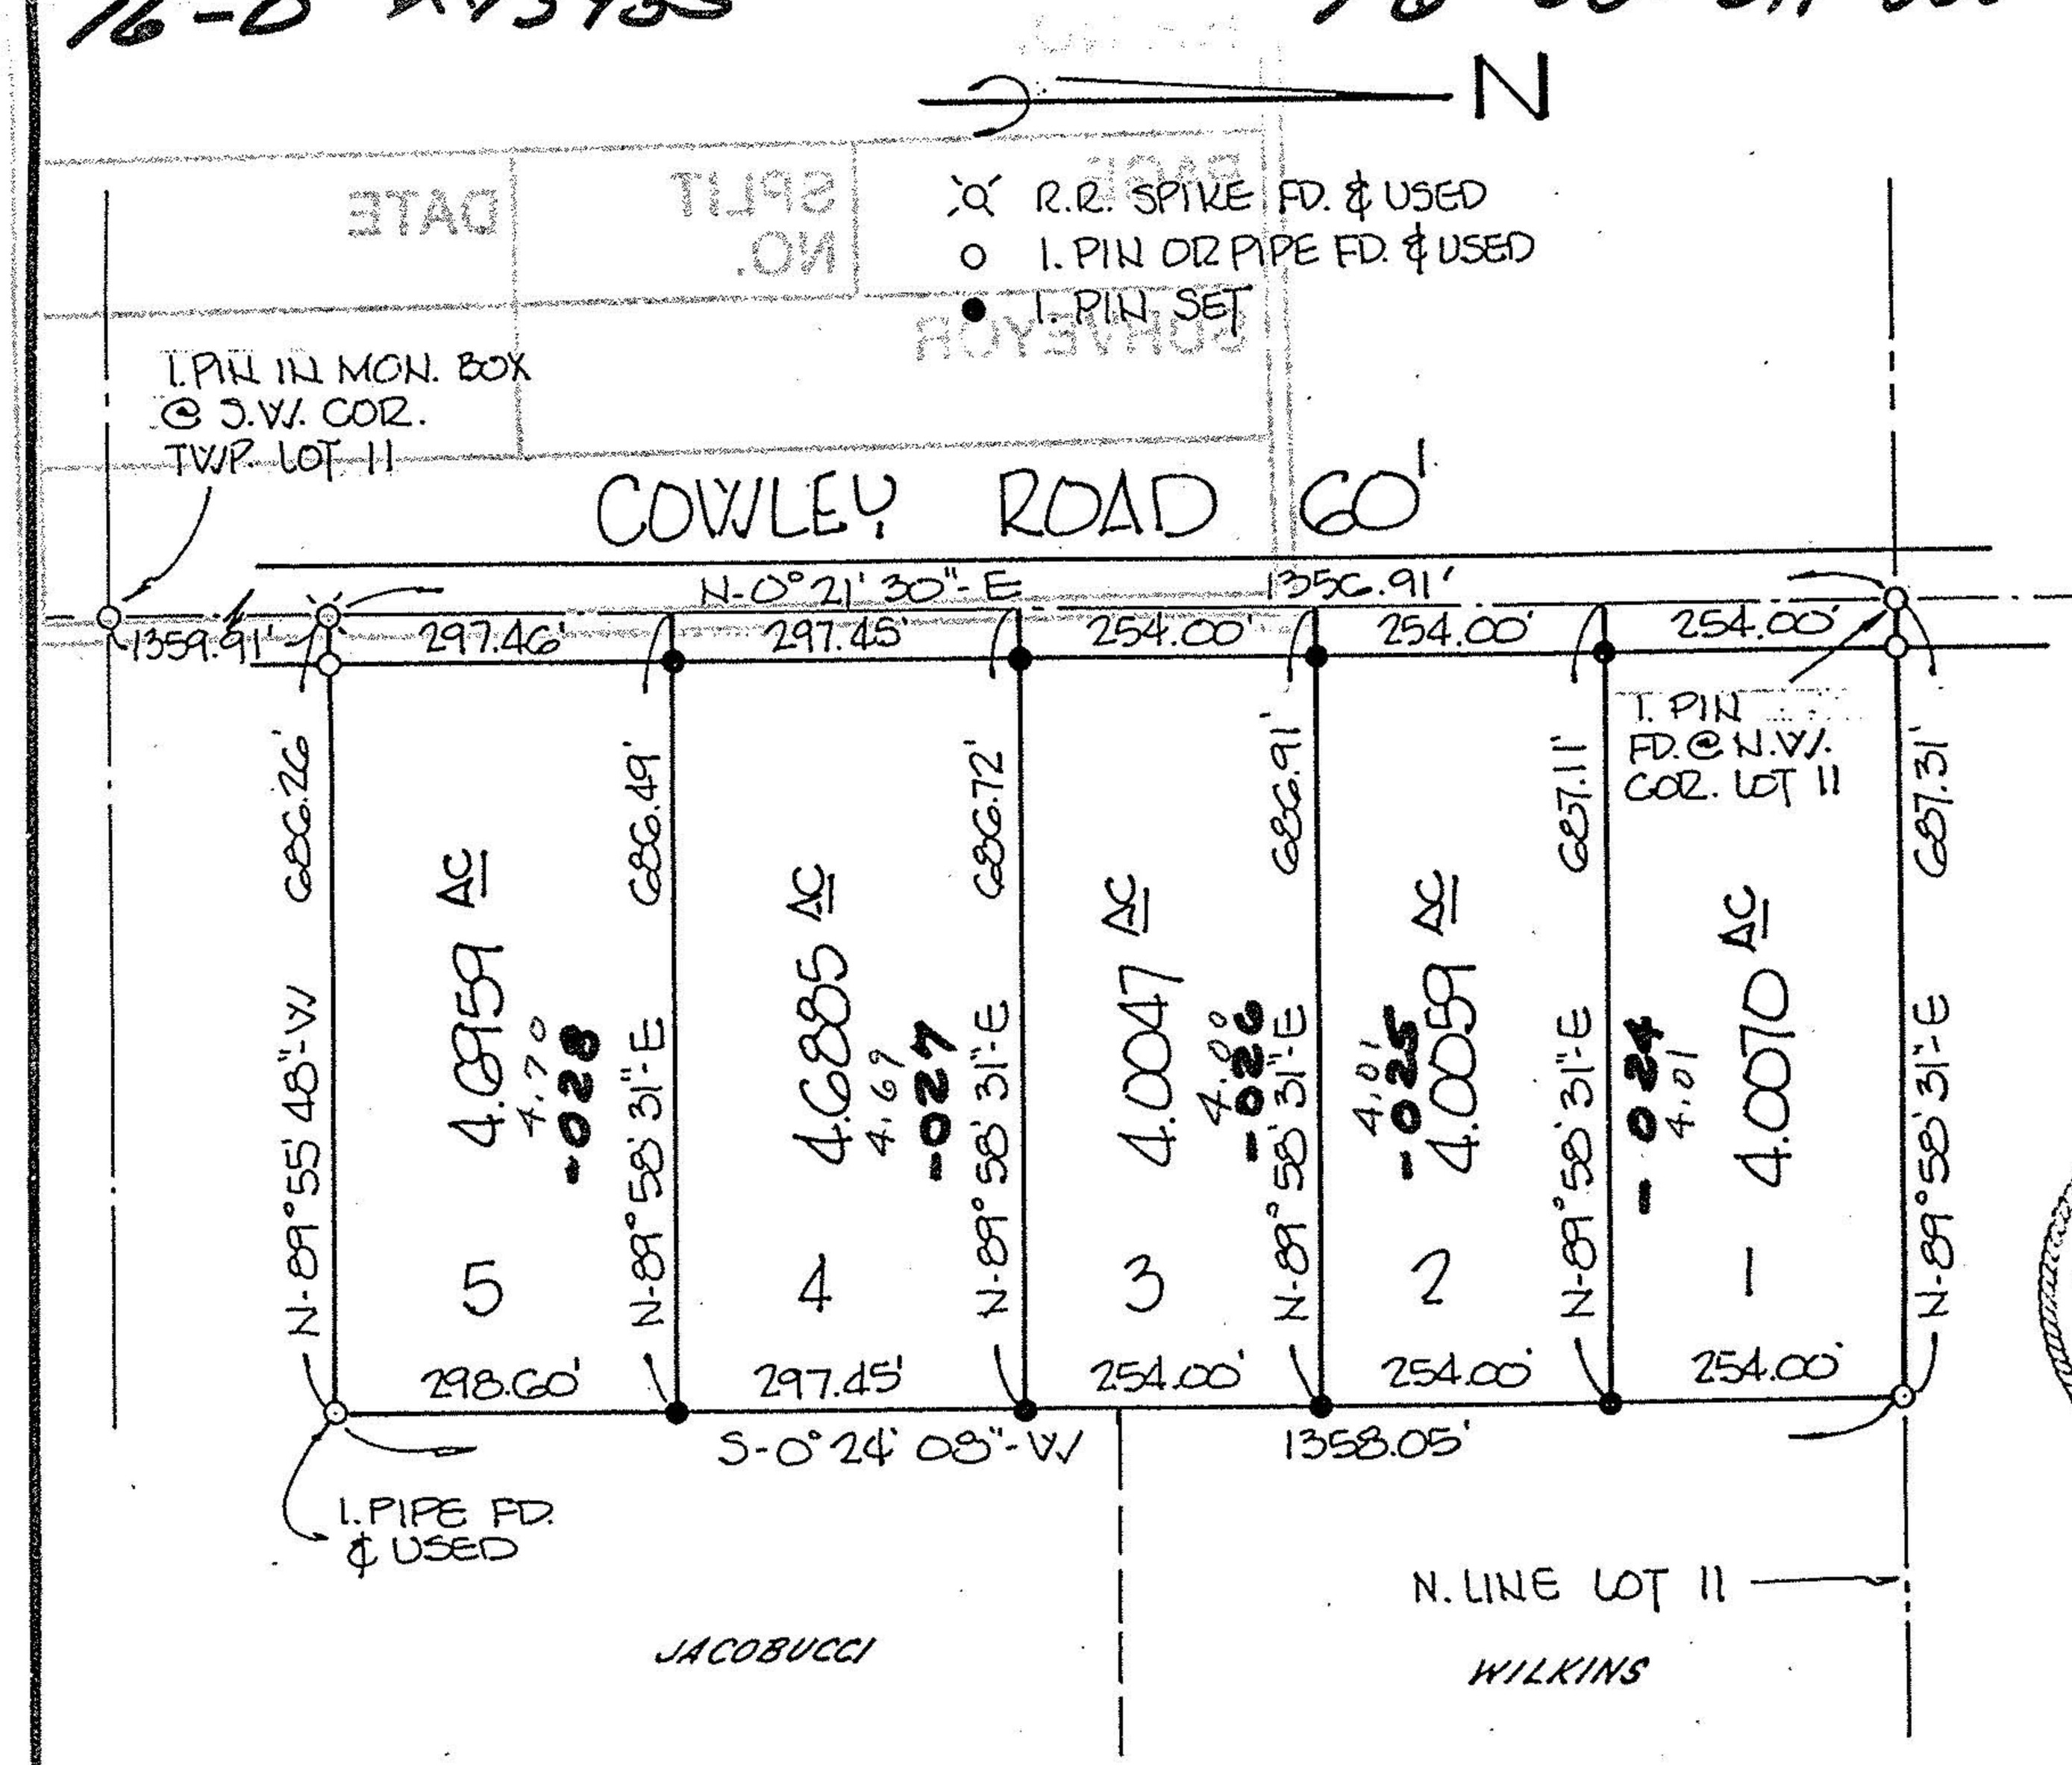

STATE OF OHIO
CHARLES A. ROLLING
5569
REGISTERED SURVEYOR

Rolling, Hocevar & Associates, Inc.
ENGINEERS SURVEYORS
MEDINA, OHIO 723 - 1828

Project No. 3334