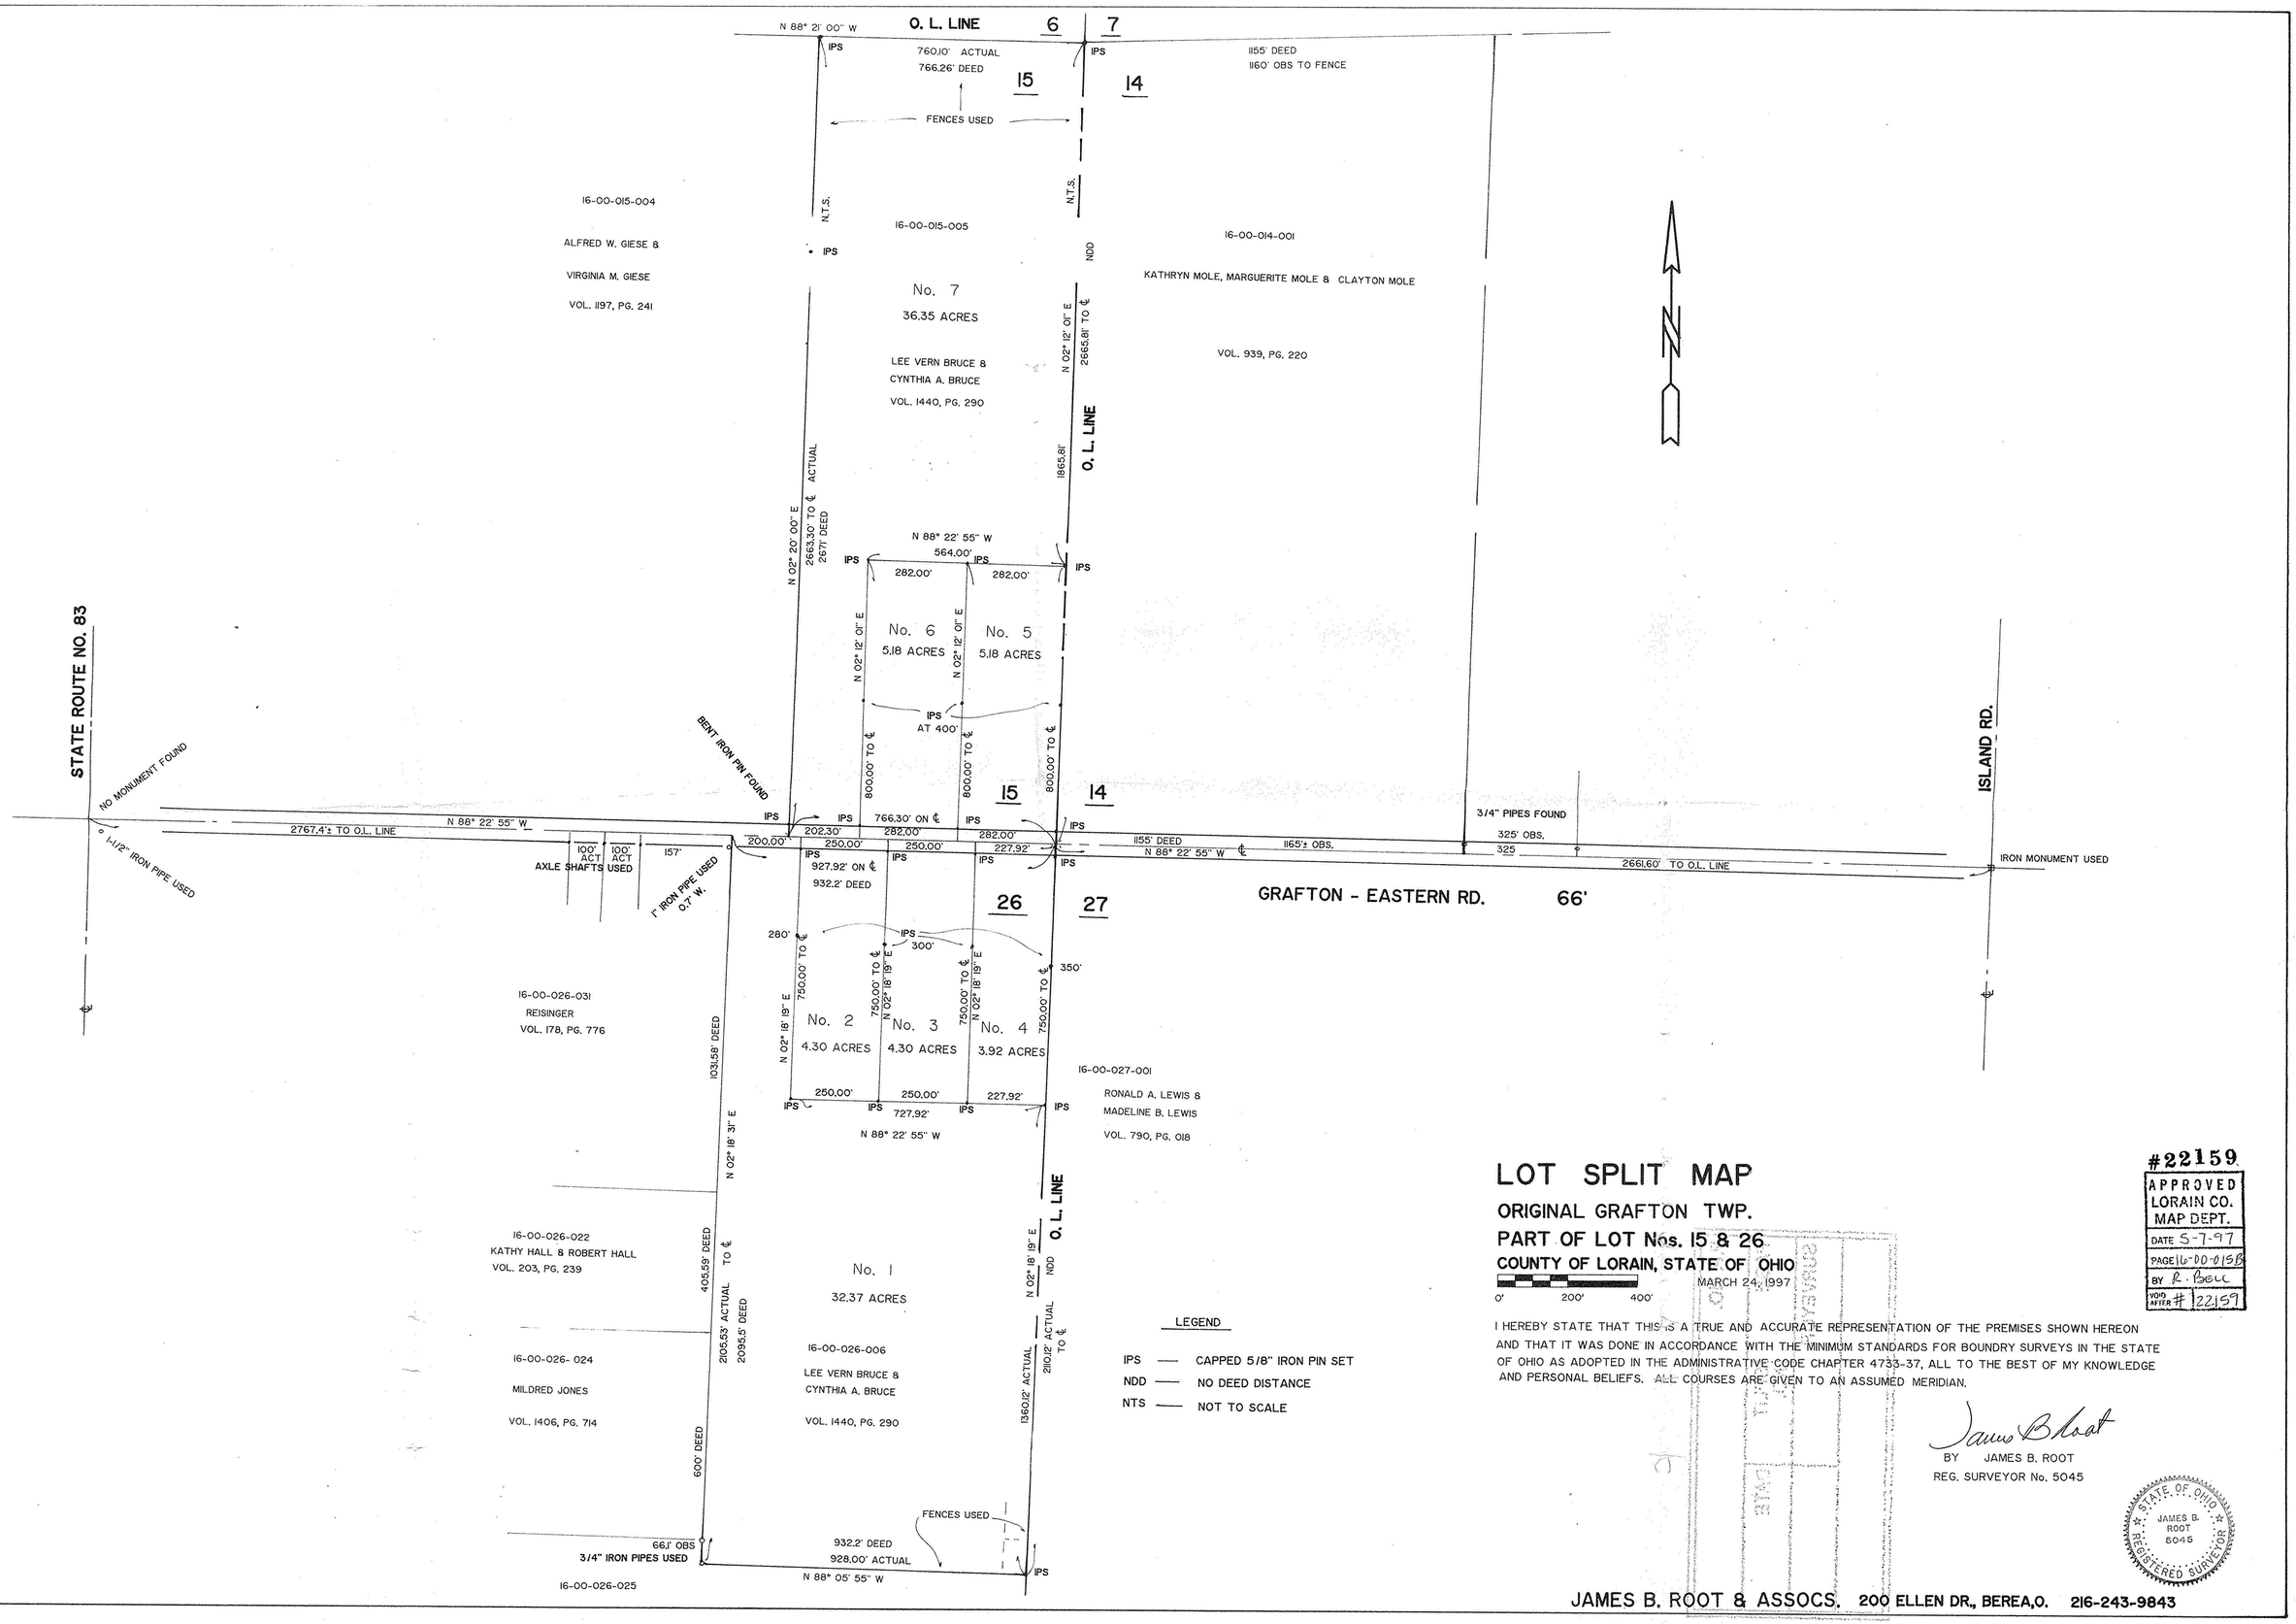

LOT SPLIT MAP

ORIGINAL GRAFTON TWP.

PART OF LOT Nos. 15 & 26

COUNTY OF LORAIN, STATE OF OHIO

MARCH 24, 1997

LEGEND

IPS — CAPPED 5/8" IRON PIN SET
NDD — NO DEED DISTANCE
NTS — NOT TO SCALE

I HEREBY STATE THAT THIS IS A TRUE AND ACCURATE REPRESENTATION OF THE PREMISES SHOWN HEREON AND THAT IT WAS DONE IN ACCORDANCE WITH THE MINIMUM STANDARDS FOR BOUNDRY SURVEYS IN THE STATE OF OHIO AS ADOPTED IN THE ADMINISTRATIVE CODE CHAPTER 4733-37, ALL TO THE BEST OF MY KNOWLEDGE AND PERSONAL BELIEFS. ALL COURSES ARE GIVEN TO AN ASSUMED MERIDIAN.

BY JAMES B. ROOT
REG. SURVEYOR No. 5045

STATE OF OHIO
JAMES B. ROOT
5045
REGISTERED SURVEYOR

#22159
APPROVED
LORAIN CO.
MAP DEPT.
DATE 5-7-97
PAGE 16-00-015B
BY R. Bell
VOID AFTER # 22159

JAMES B. ROOT & ASSOCS. 200 ELLEN DR., BEREA, O. 216-243-9843