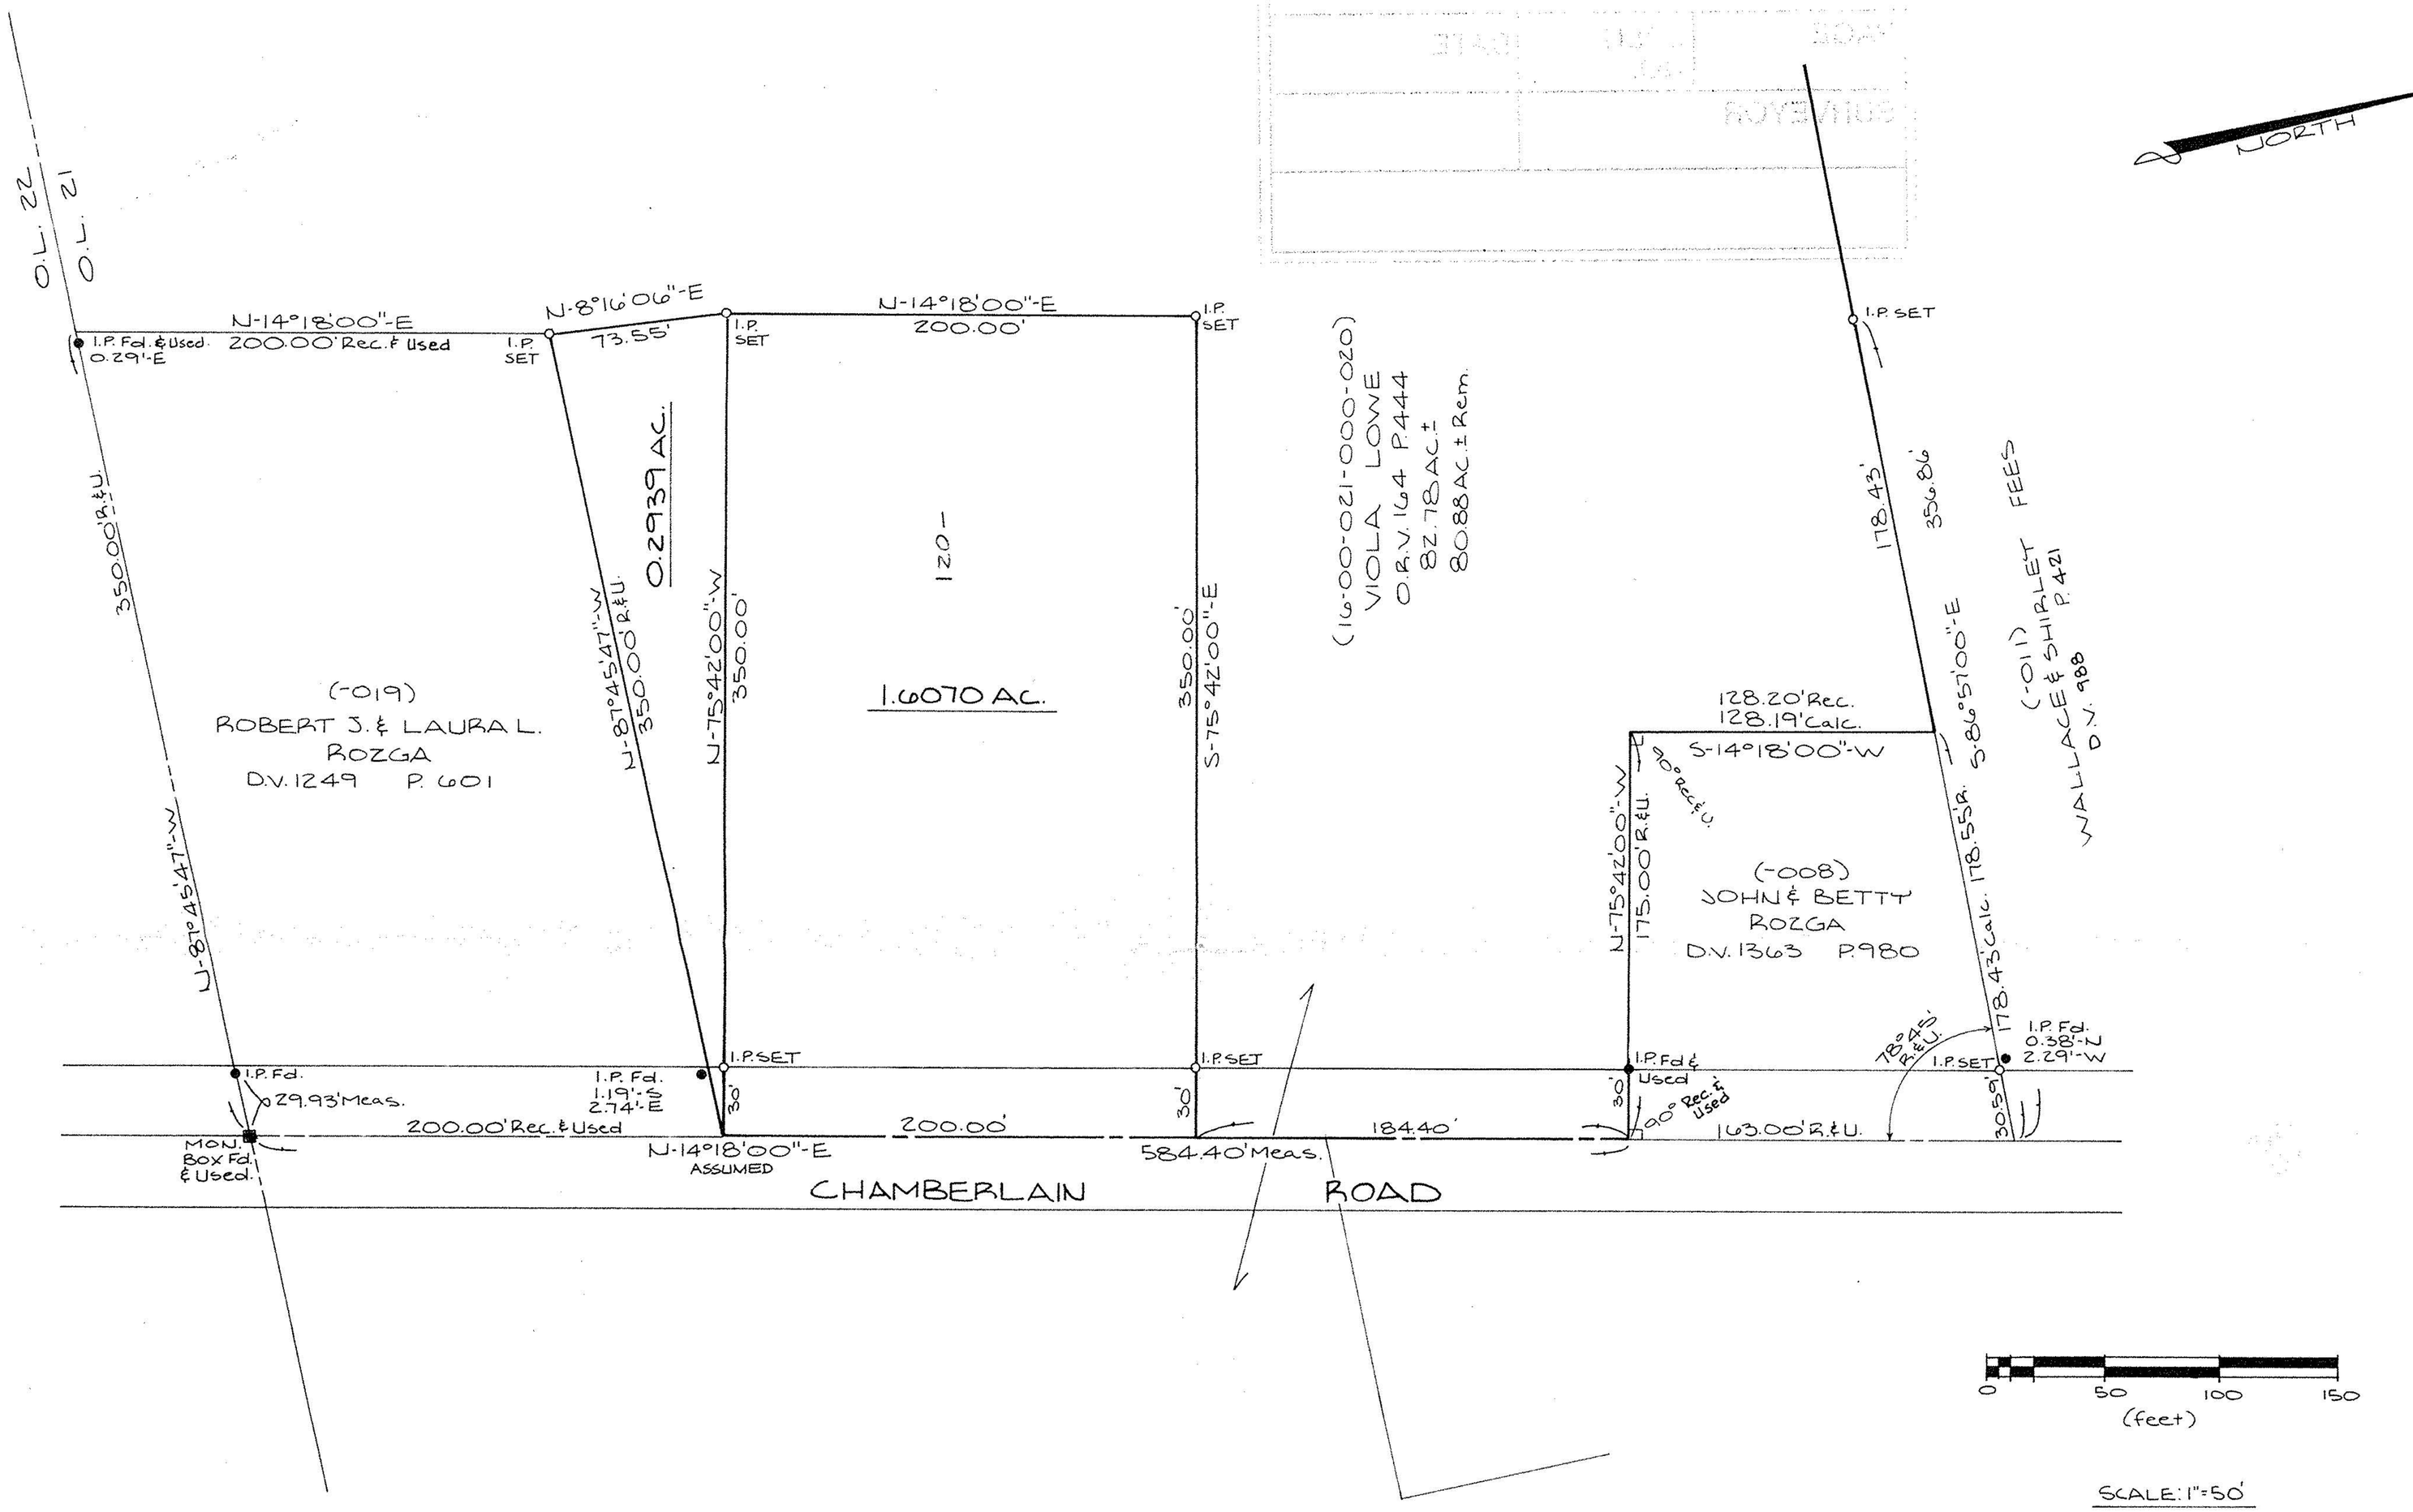


SCALE: 1" = 50'

# SURVEY MAP

PART OF GRAFTON TOWNSHIP ORIG. LOT No. 21

TOWNSHIP OF GRAFTON

COUNTY OF LORAIN — STATE OF OHIO

SEPTEMBER 16, 1993
REV. NOV. 23, 1993

SCALE: 1" = 50'

APPROVED
LORAIN CO.
MAP DEPT.
#20644
DATE 11-30-93
PAGE 16-A
BY
VOID AFTER
20644

16-00-021-000

KS ASSOCIATES INC.
ENGINEERS SURVEYORS

David L. Elwell
DAVID L. ELWELL
REG. SURVEYOR NO. 6333

STATE OF OHIO
DAVID L. ELWELL
6333
REGISTERED
SURVEYOR

93-417