KLEINOEDER · SCHMIDT and ASSOCIATES

ENGINEERS — SURVEYORS — CONSULTANTS in LAND PLANNING

ELYRIA · NORWALK · MEDINA OHIO

SURVEY

1658

Sublot(s) 16B

Subd'n

Township GRAFTON Tract

Orig. Lot(s) 24 Sec.

County of LORAIN State of Ohio

Corporation

16-00-024-000

#95-58

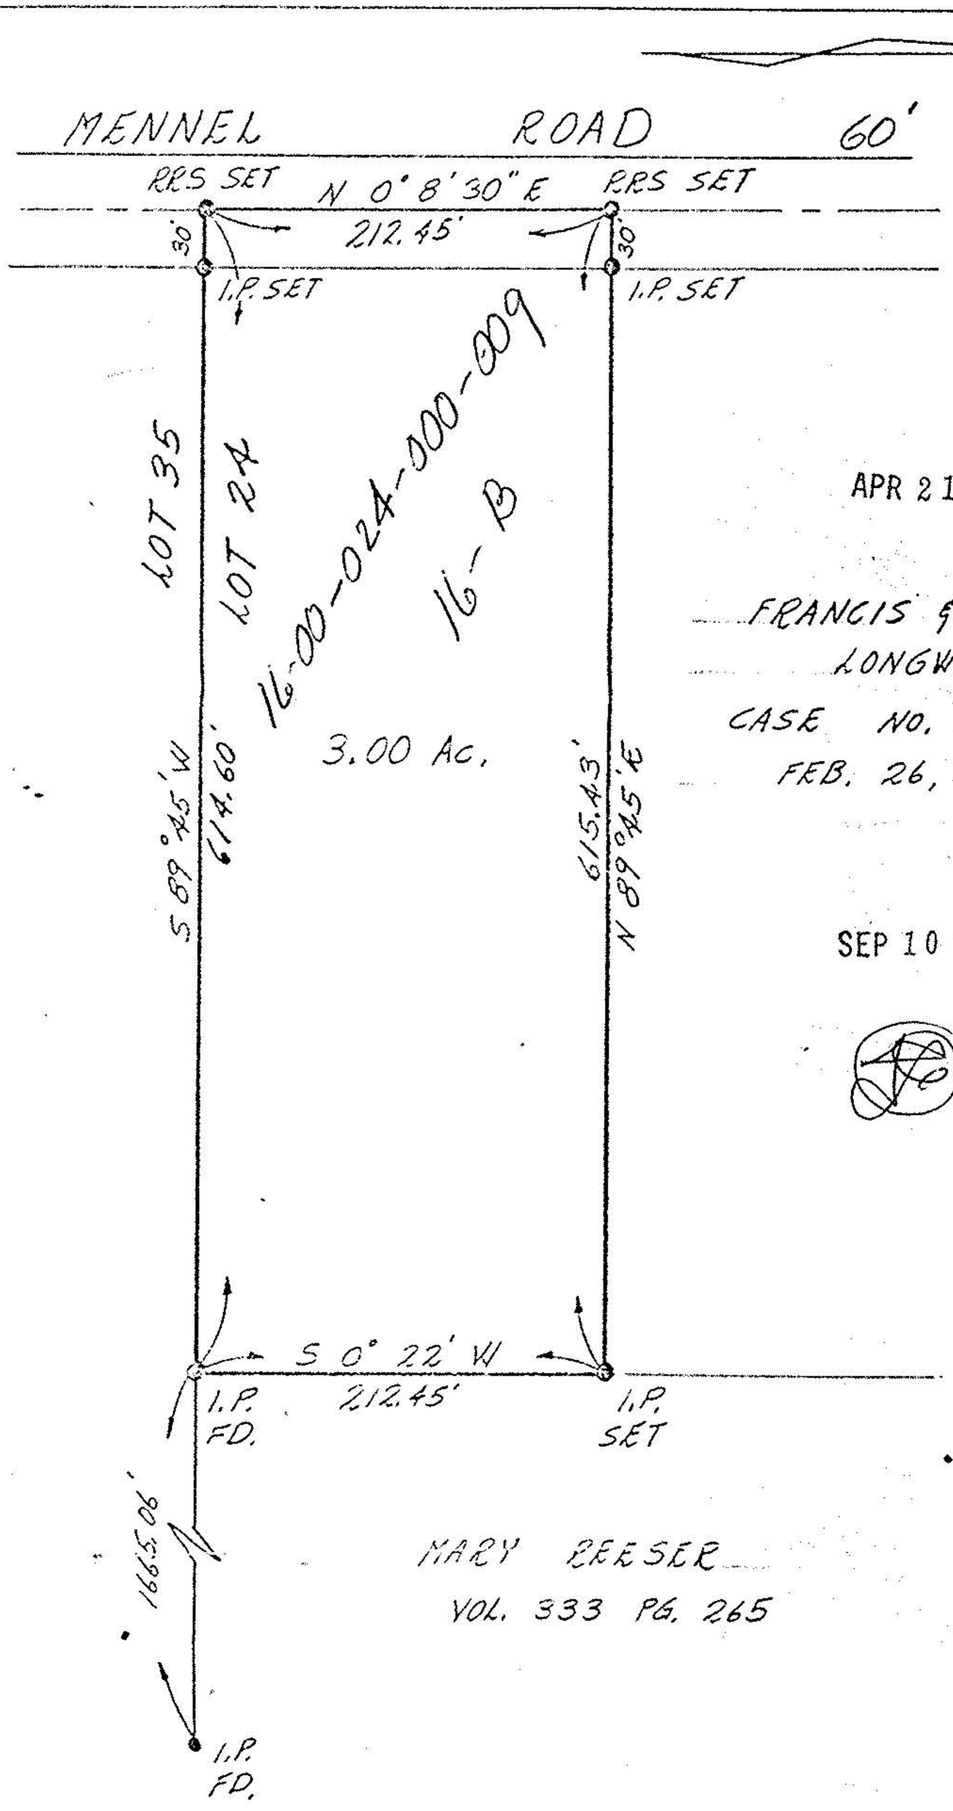

APR 21 1976

FRANCIS & FLORENCE LONGWELL

CASE NO. 23027

FEB. 26, 1945

SEP 10 1976

MARY REESER

VOL. 333 PG. 265

16-B

16-00-024-000

Prepared for L. LONGWELL · 40823 CARLISLE AVE., ELYRIA, OHIO

Date 5-15-76 | Dr. by: KPC | Job No 76-0