16-00-026-B

16-00-026-000-

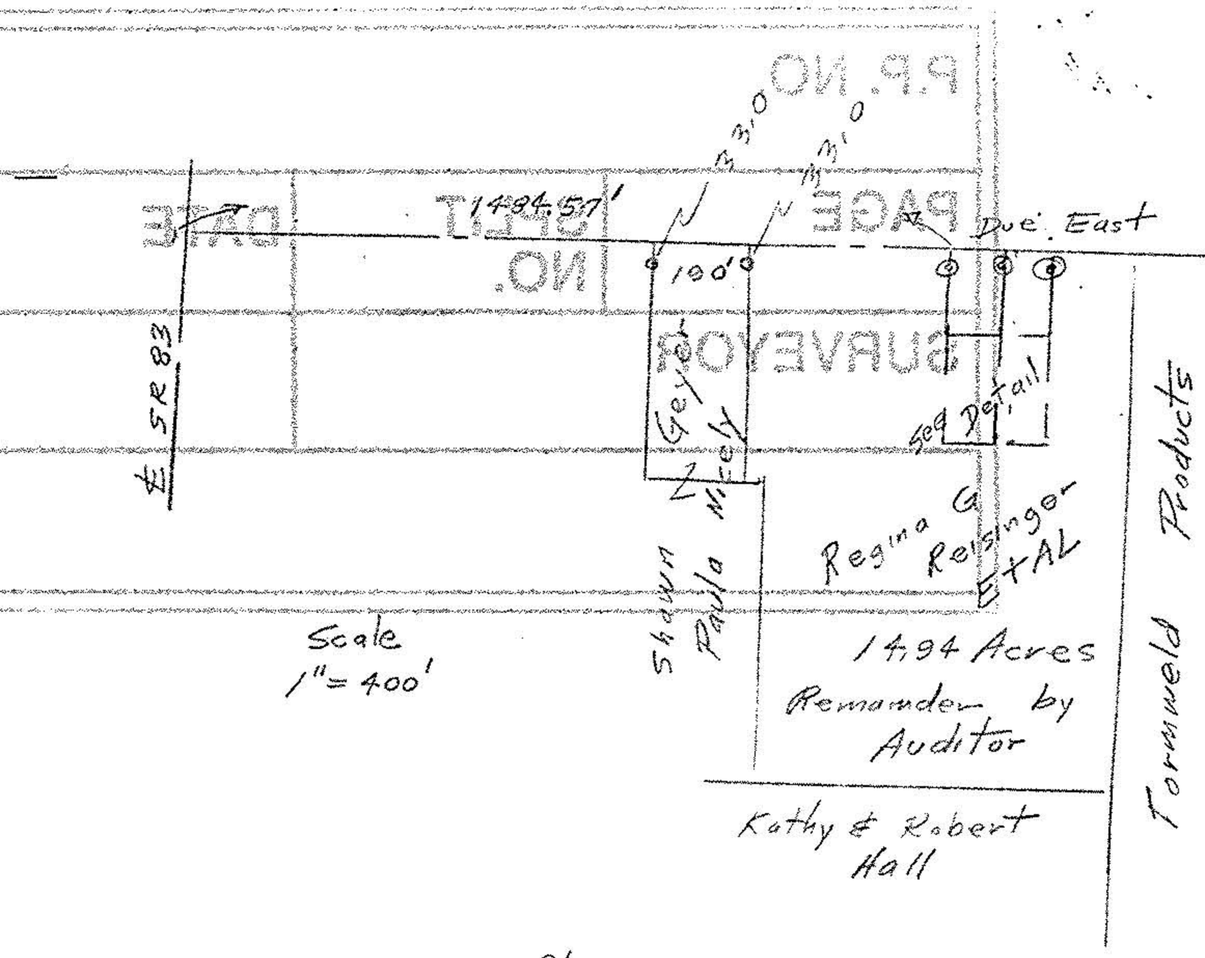

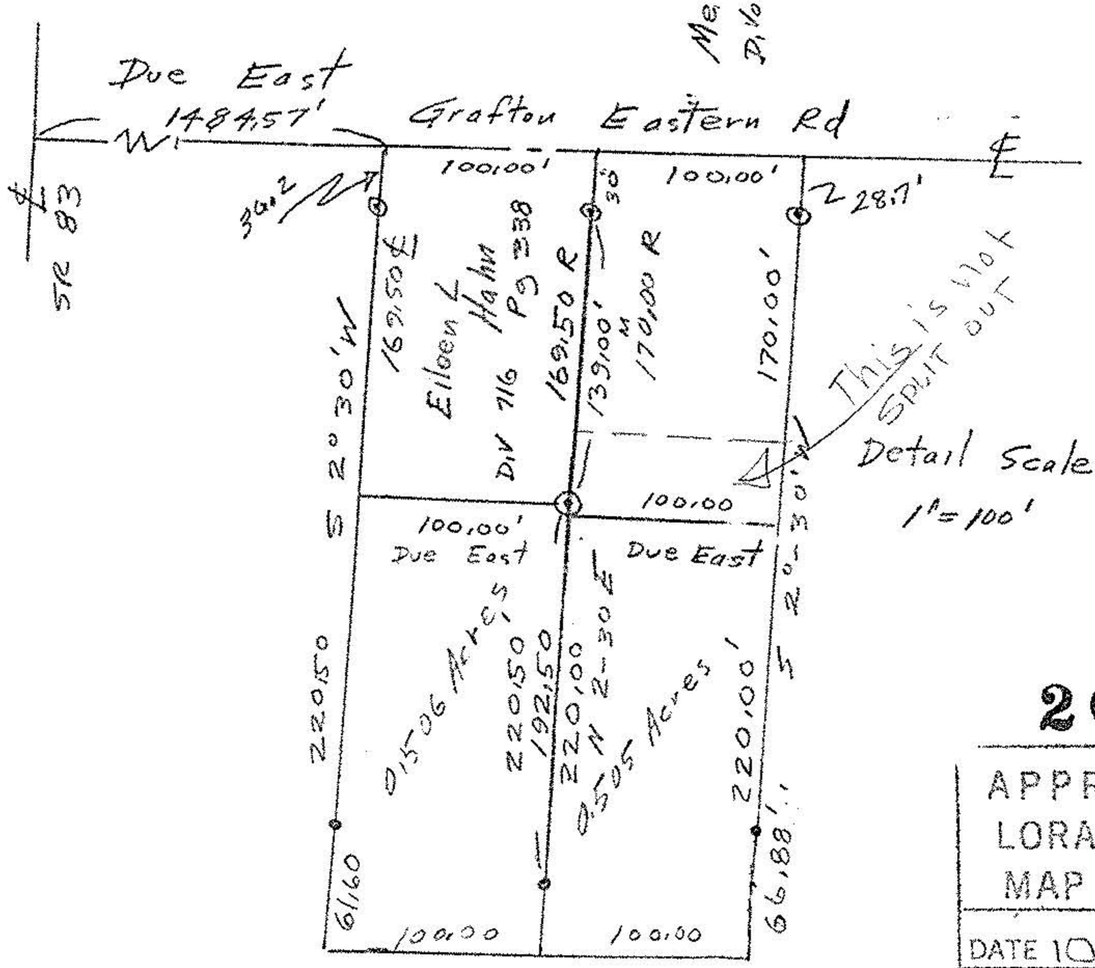

o Iron pipes fd

⊙ Model T axels fd

• ⌀5 rebar set

Bearing of Grafton Eastern Rd assumed Due East

STATE OF OHIO
JOHN POZYWAK
5292
REGISTERED
SURVEYOR

John Pozywak
Reg Surveyor
5292

20101

APPROVED
LORAIN CO.
MAP DEPT.

DATE 10-6-92

PAGE 16-00-026-A
16-00-026-B

BY CAROLYN FRANCIS

VOL Parcels

AFTER ## 20101

Parcel Split survey of two parcels
for Merle N. Reisinger
Part of Original Lot 26
Grafton Township, Lorain County Ohio
scale as noted Aug 1992