BOUNDARY SURVEY
FOR
PEARL K. DEIMLING

ORIGINAL LOT 31 GRAFTON TWP.
COUNTY OF LORAIN STATE OF OHIO

LAUNDON · SIMON · CAHL & ASSOC.
ENGINEERS SURVEYORS
110 MIDDLE AVE. ELYRIA, OHIO
(216) 322-7625

JOB NO. 94-2596
F.B. 233 P. 16 & 18

STATE OF OHIO
RODGER G. SIMON
5101
REGISTERED SURVEYOR

NORTH
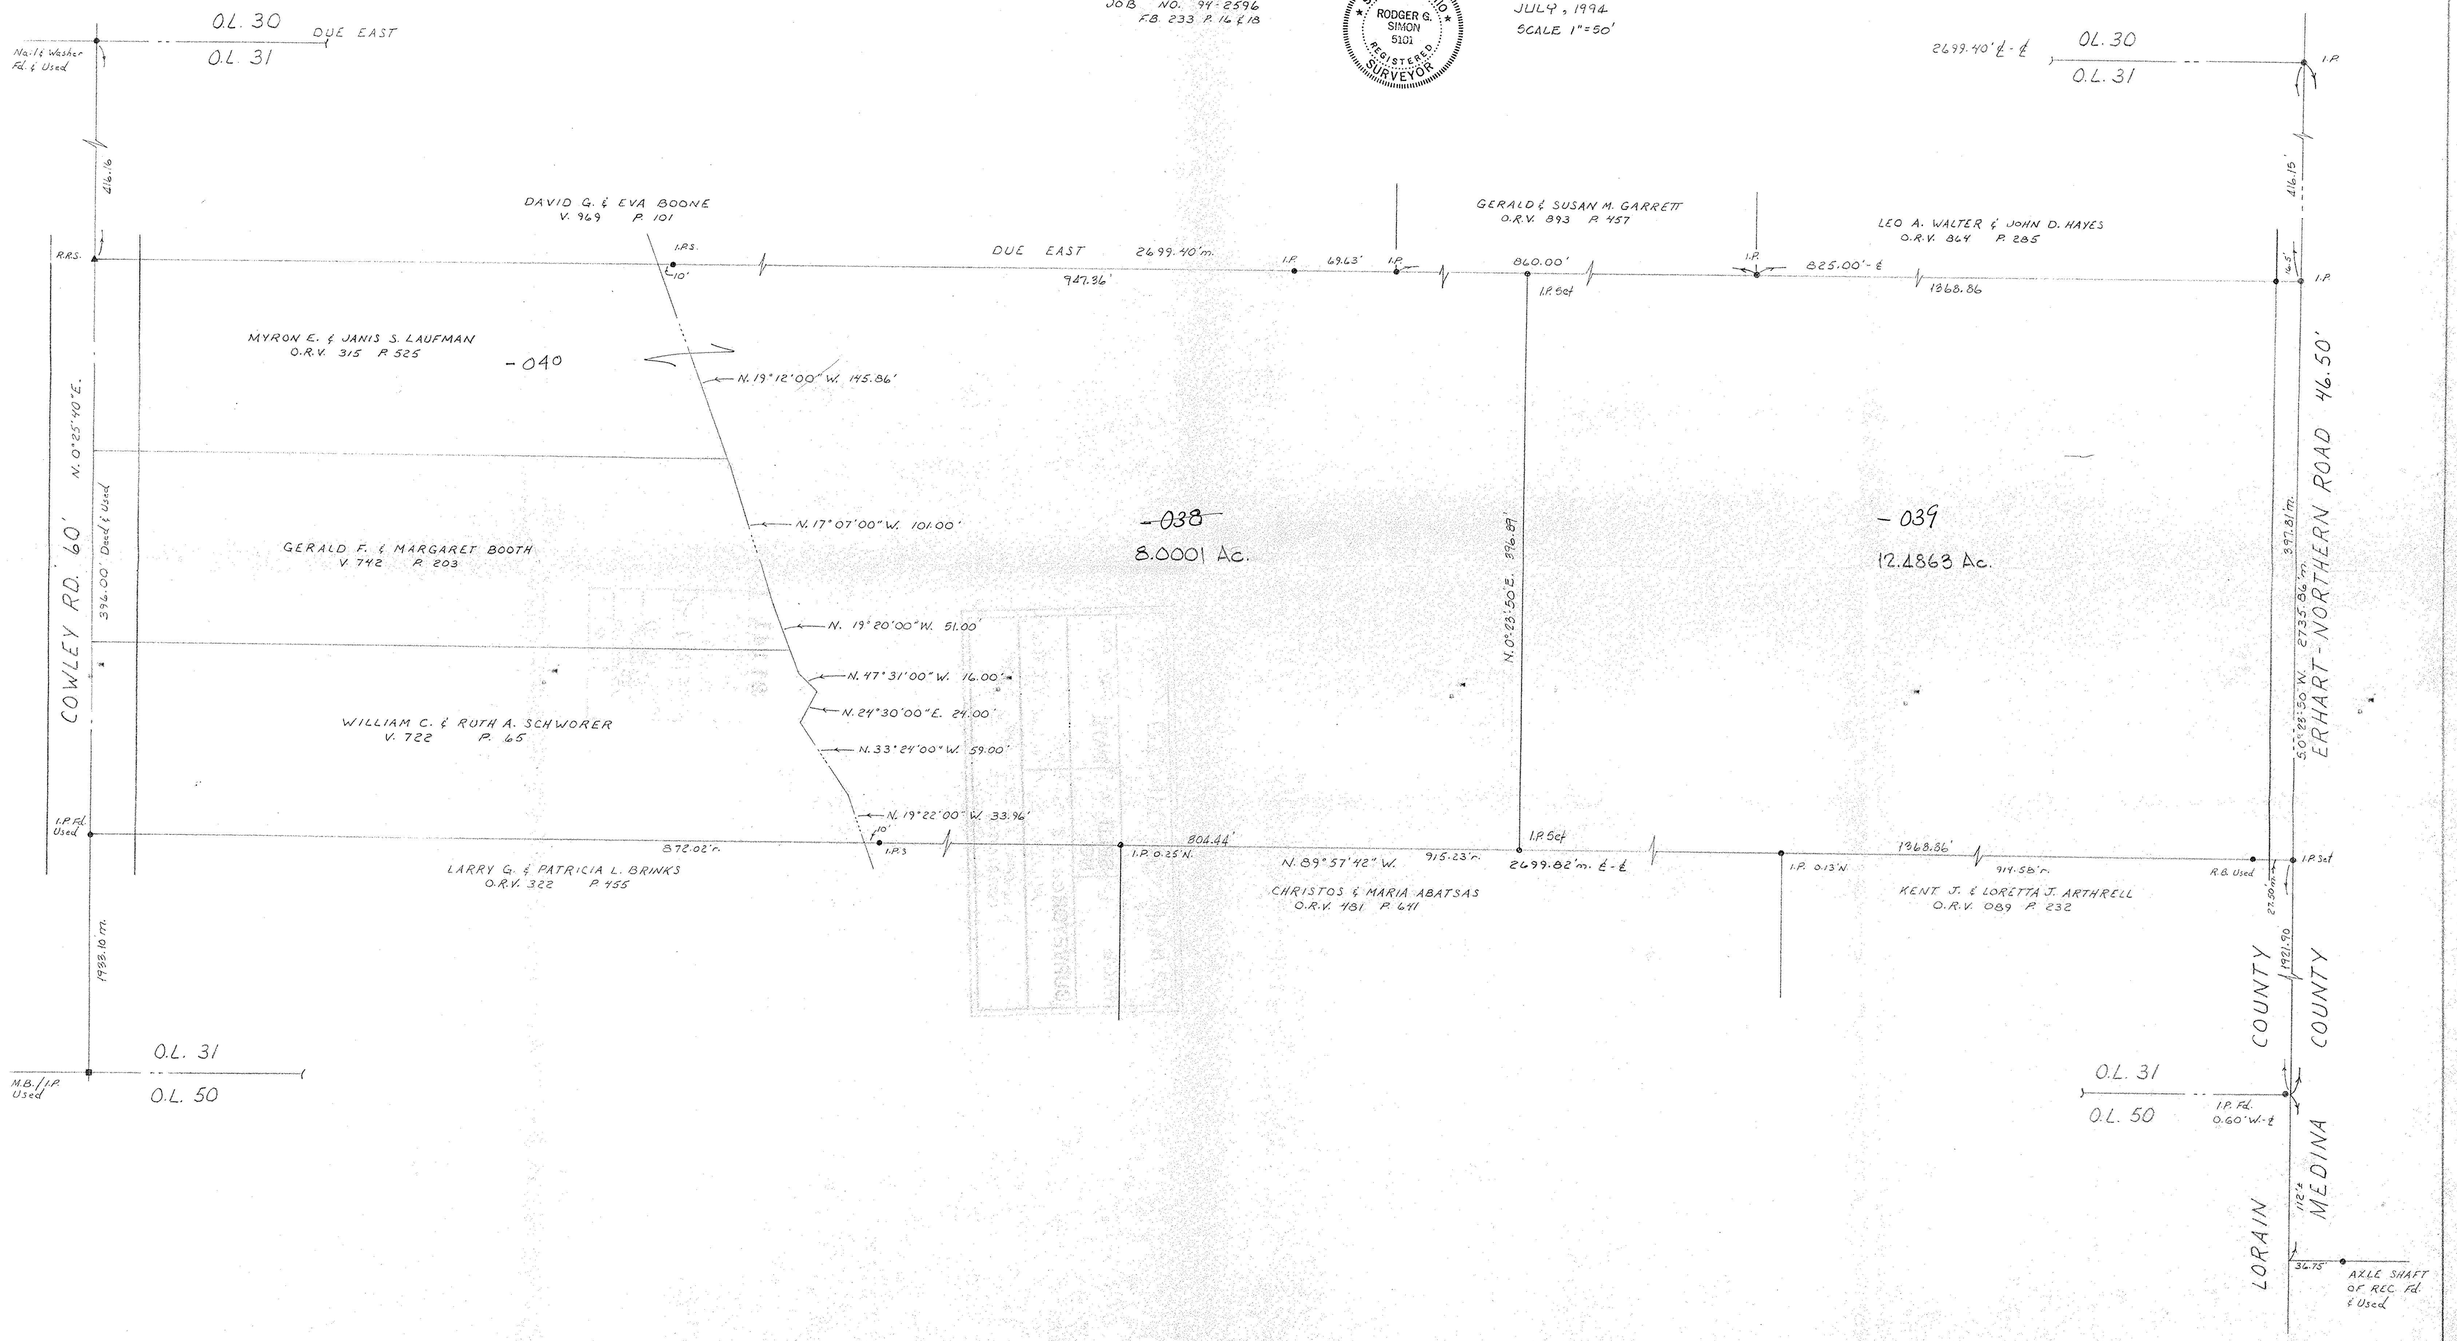
JULY, 1994
SCALE 1" = 50'