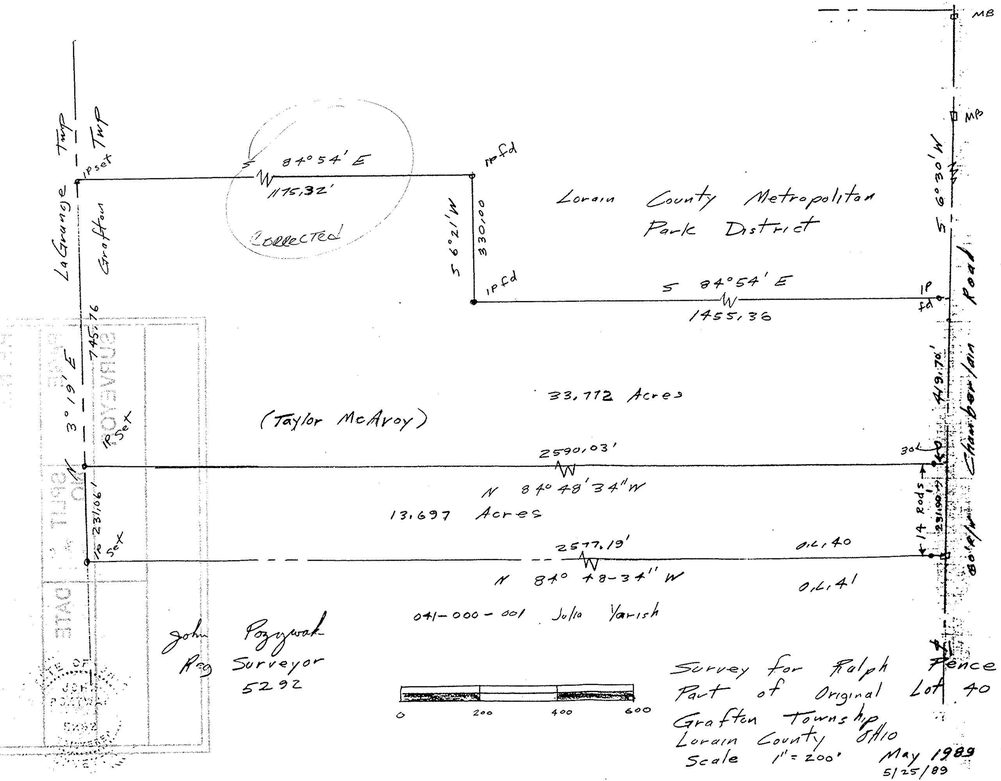

#18470

APPROVED
LORAIN CO.
MAP DEPT.
DATE 6-14-89
PAGE 16-A
BY Carolyn Francis
VOID AFTER # 18470

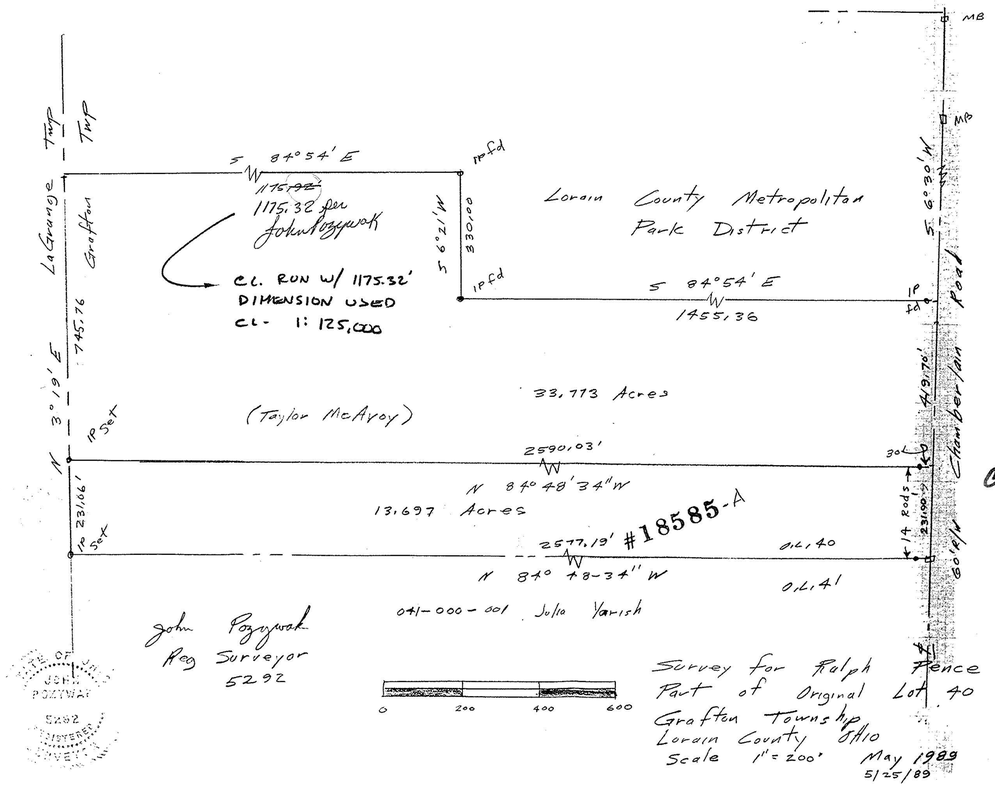

cf 8/17/89
#18585-A
#18470

APPROVED
LORAIN CO.
MAP DEPT.
DATE 6-13-89
PAGE 16-A
BY CAROLYN FRANCIS-T.
VOID AFTER # 18470