
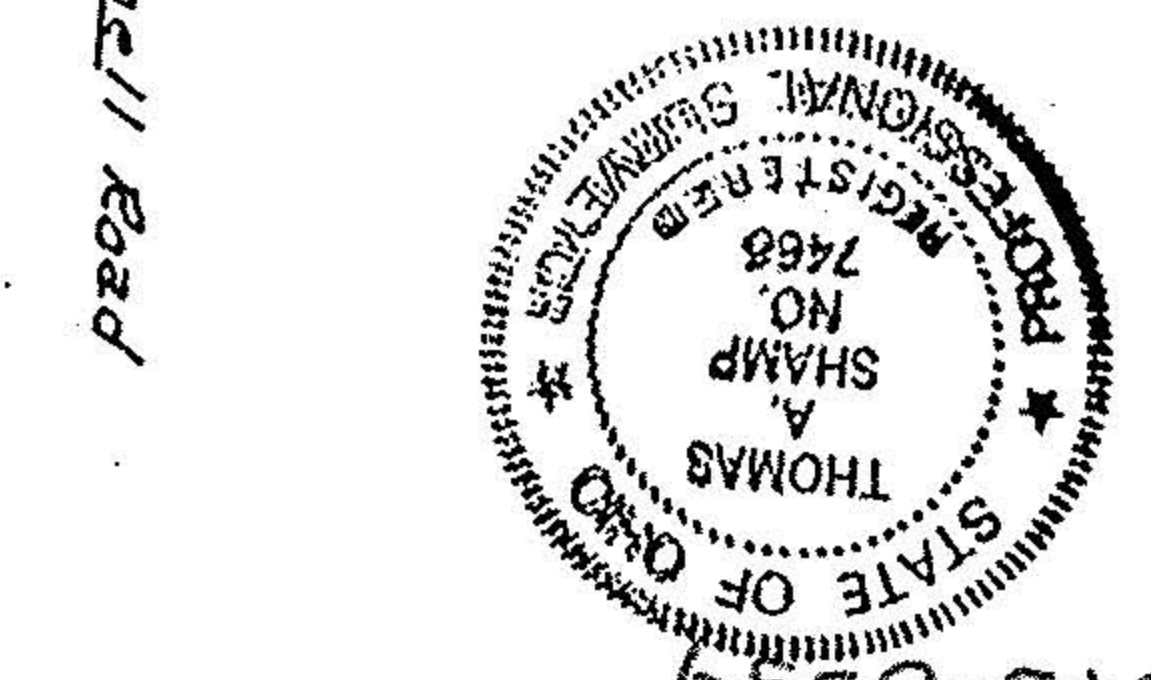
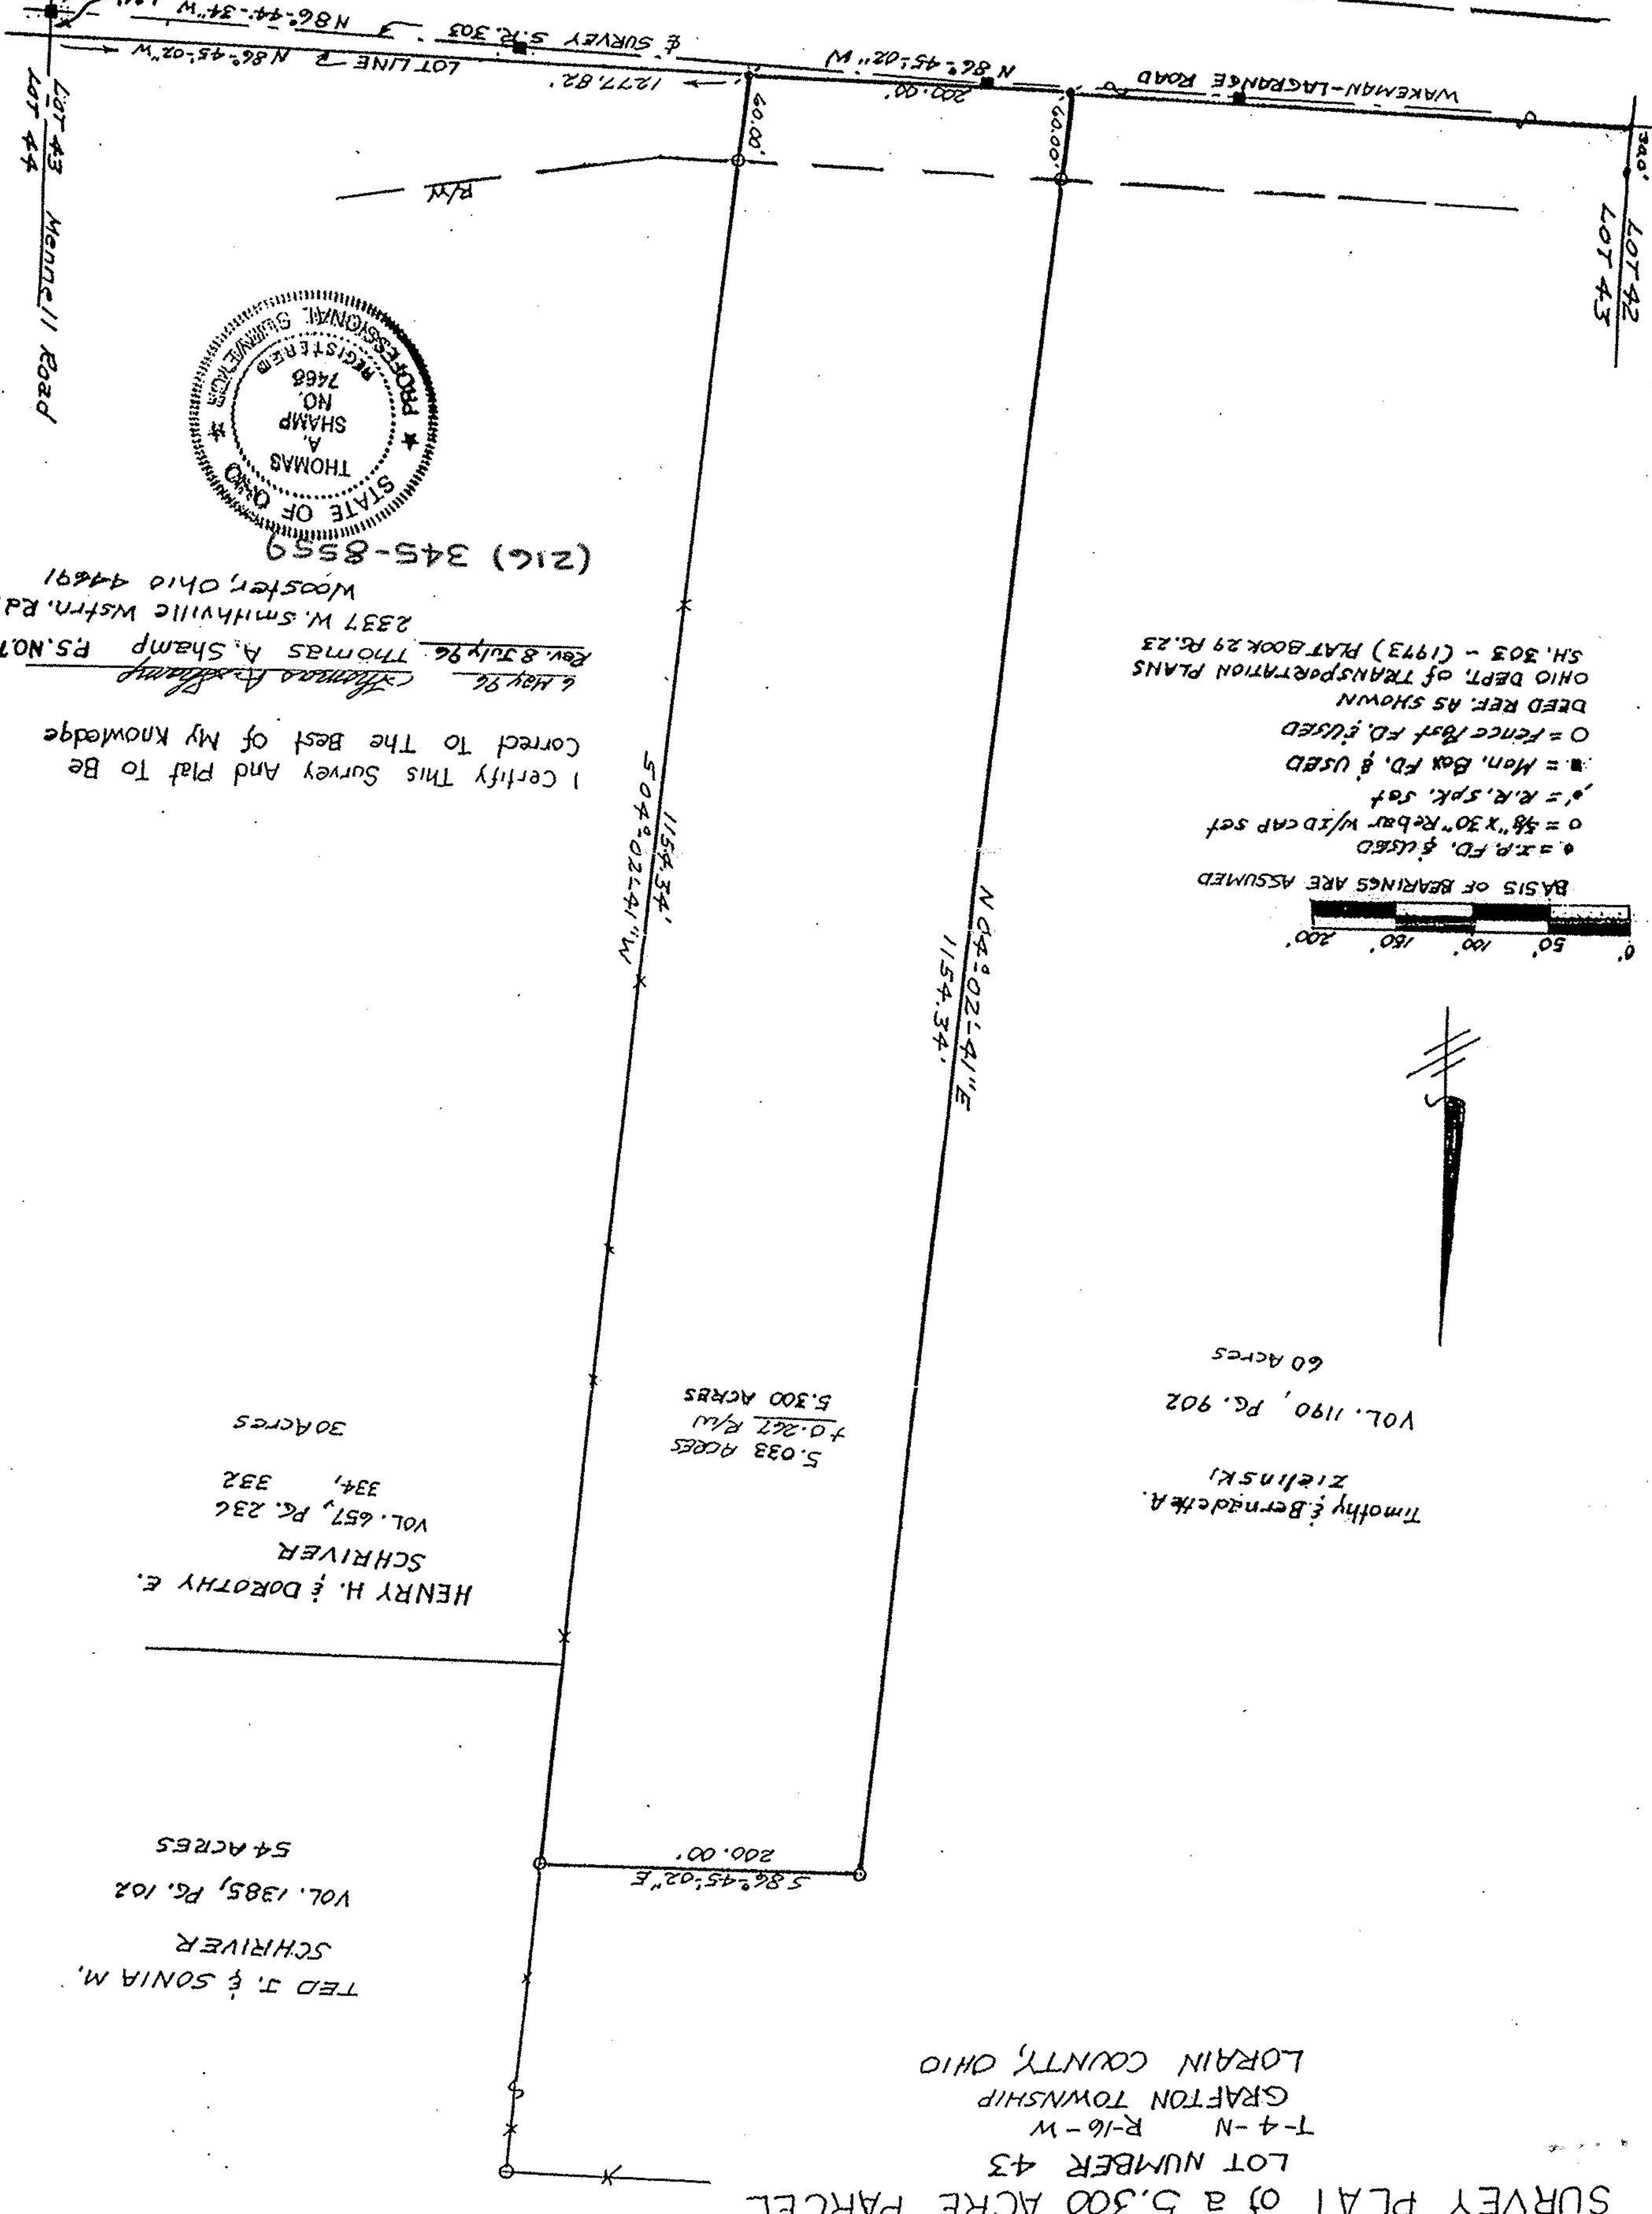


SURVEY PLAT of a 5.300 ACRE PARCEL
LOT NUMBER 43
T-4-N R-16-W
GRAFTON TOWNSHIP
LORAIN COUNTY, OHIO



APPROVED
LORAIN CO.
MAP DEPT.
DATE 7-17-96
PAGE 16-A
BY [Signature]
VOID AFTER 21804

#21804

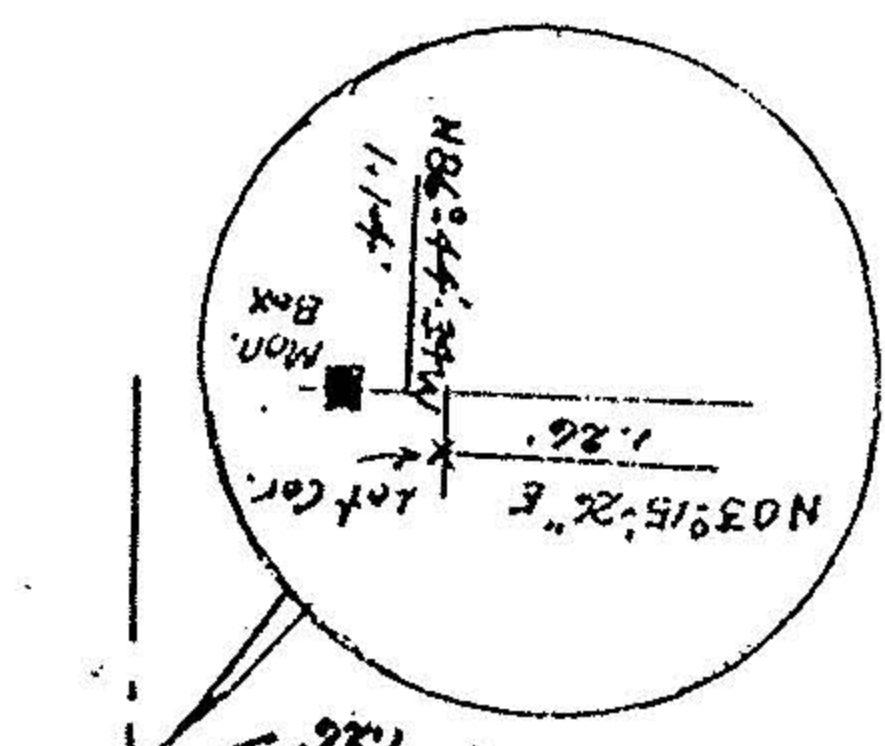

I certify This Survey And Plat To Be Correct To The Best of My Knowledge
6 May 96
Thomas A. Shamp
2337 W. Smithville Wstrn. Rd.
Wooster, Ohio 44691
(216) 345-8559

BASIS OF BEARINGS ARE ASSUMED
o = I.P. FD. & USED
o = 5/8\" X 30\" Rebar w/ID CAP set
o = R.R. Spk. set
■ = Mon. Box FD. & USED
o = Fence Post FD. & USED
DEED REF. AS SHOWN
OHIO DEPT. OF TRANSPORTATION PLANS
SH. 303 - (1973) PLAT BOOK 29 PG. 23

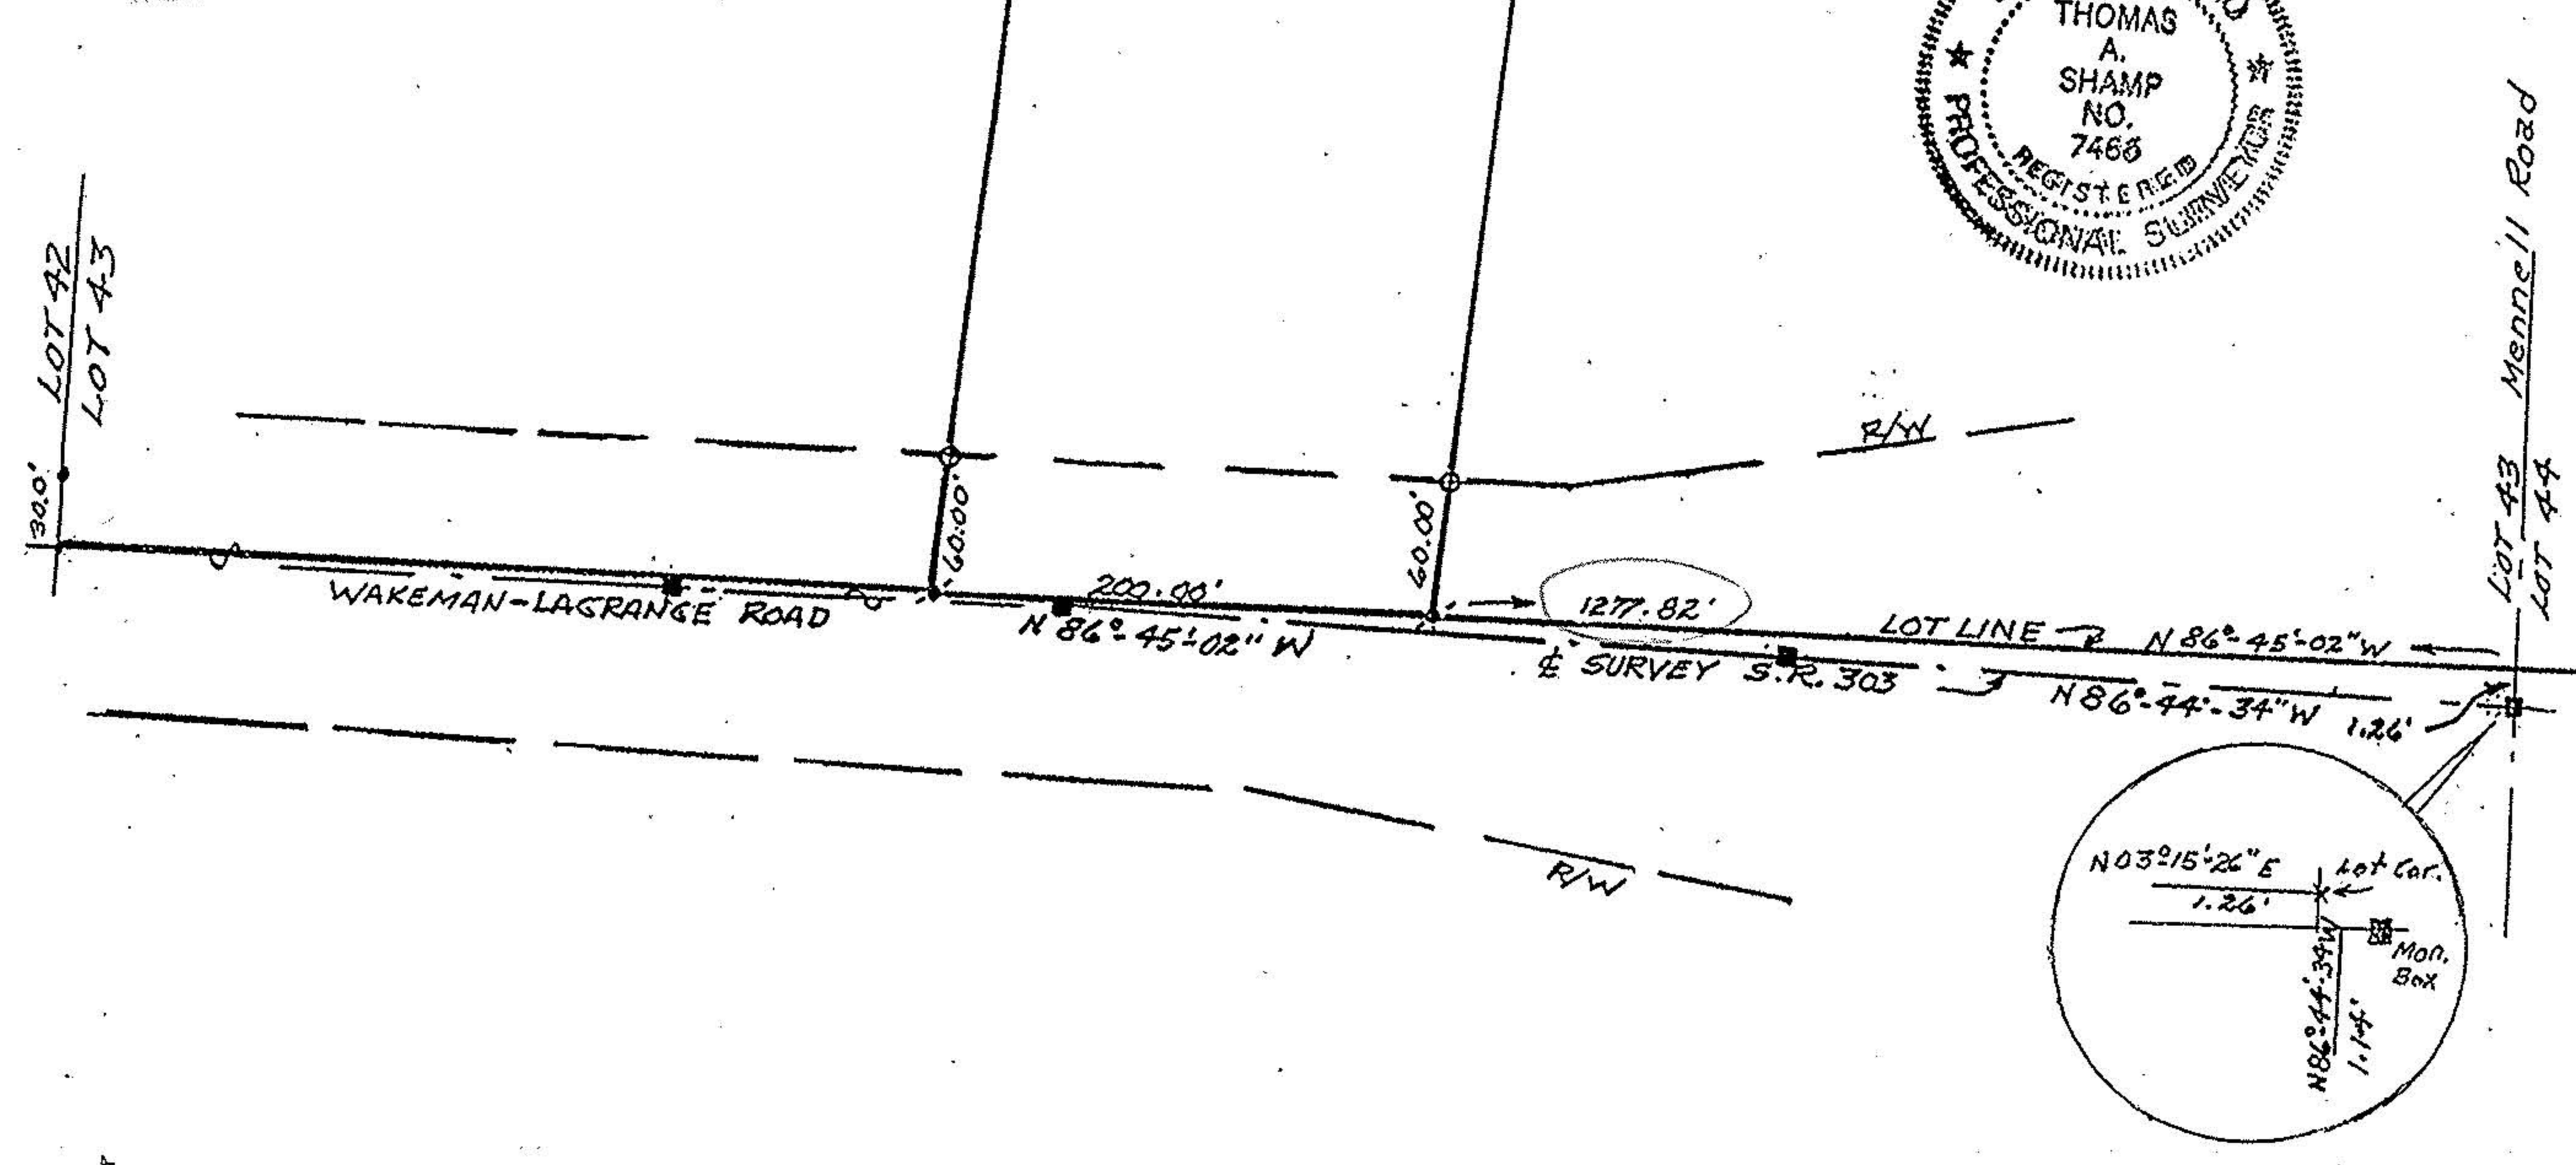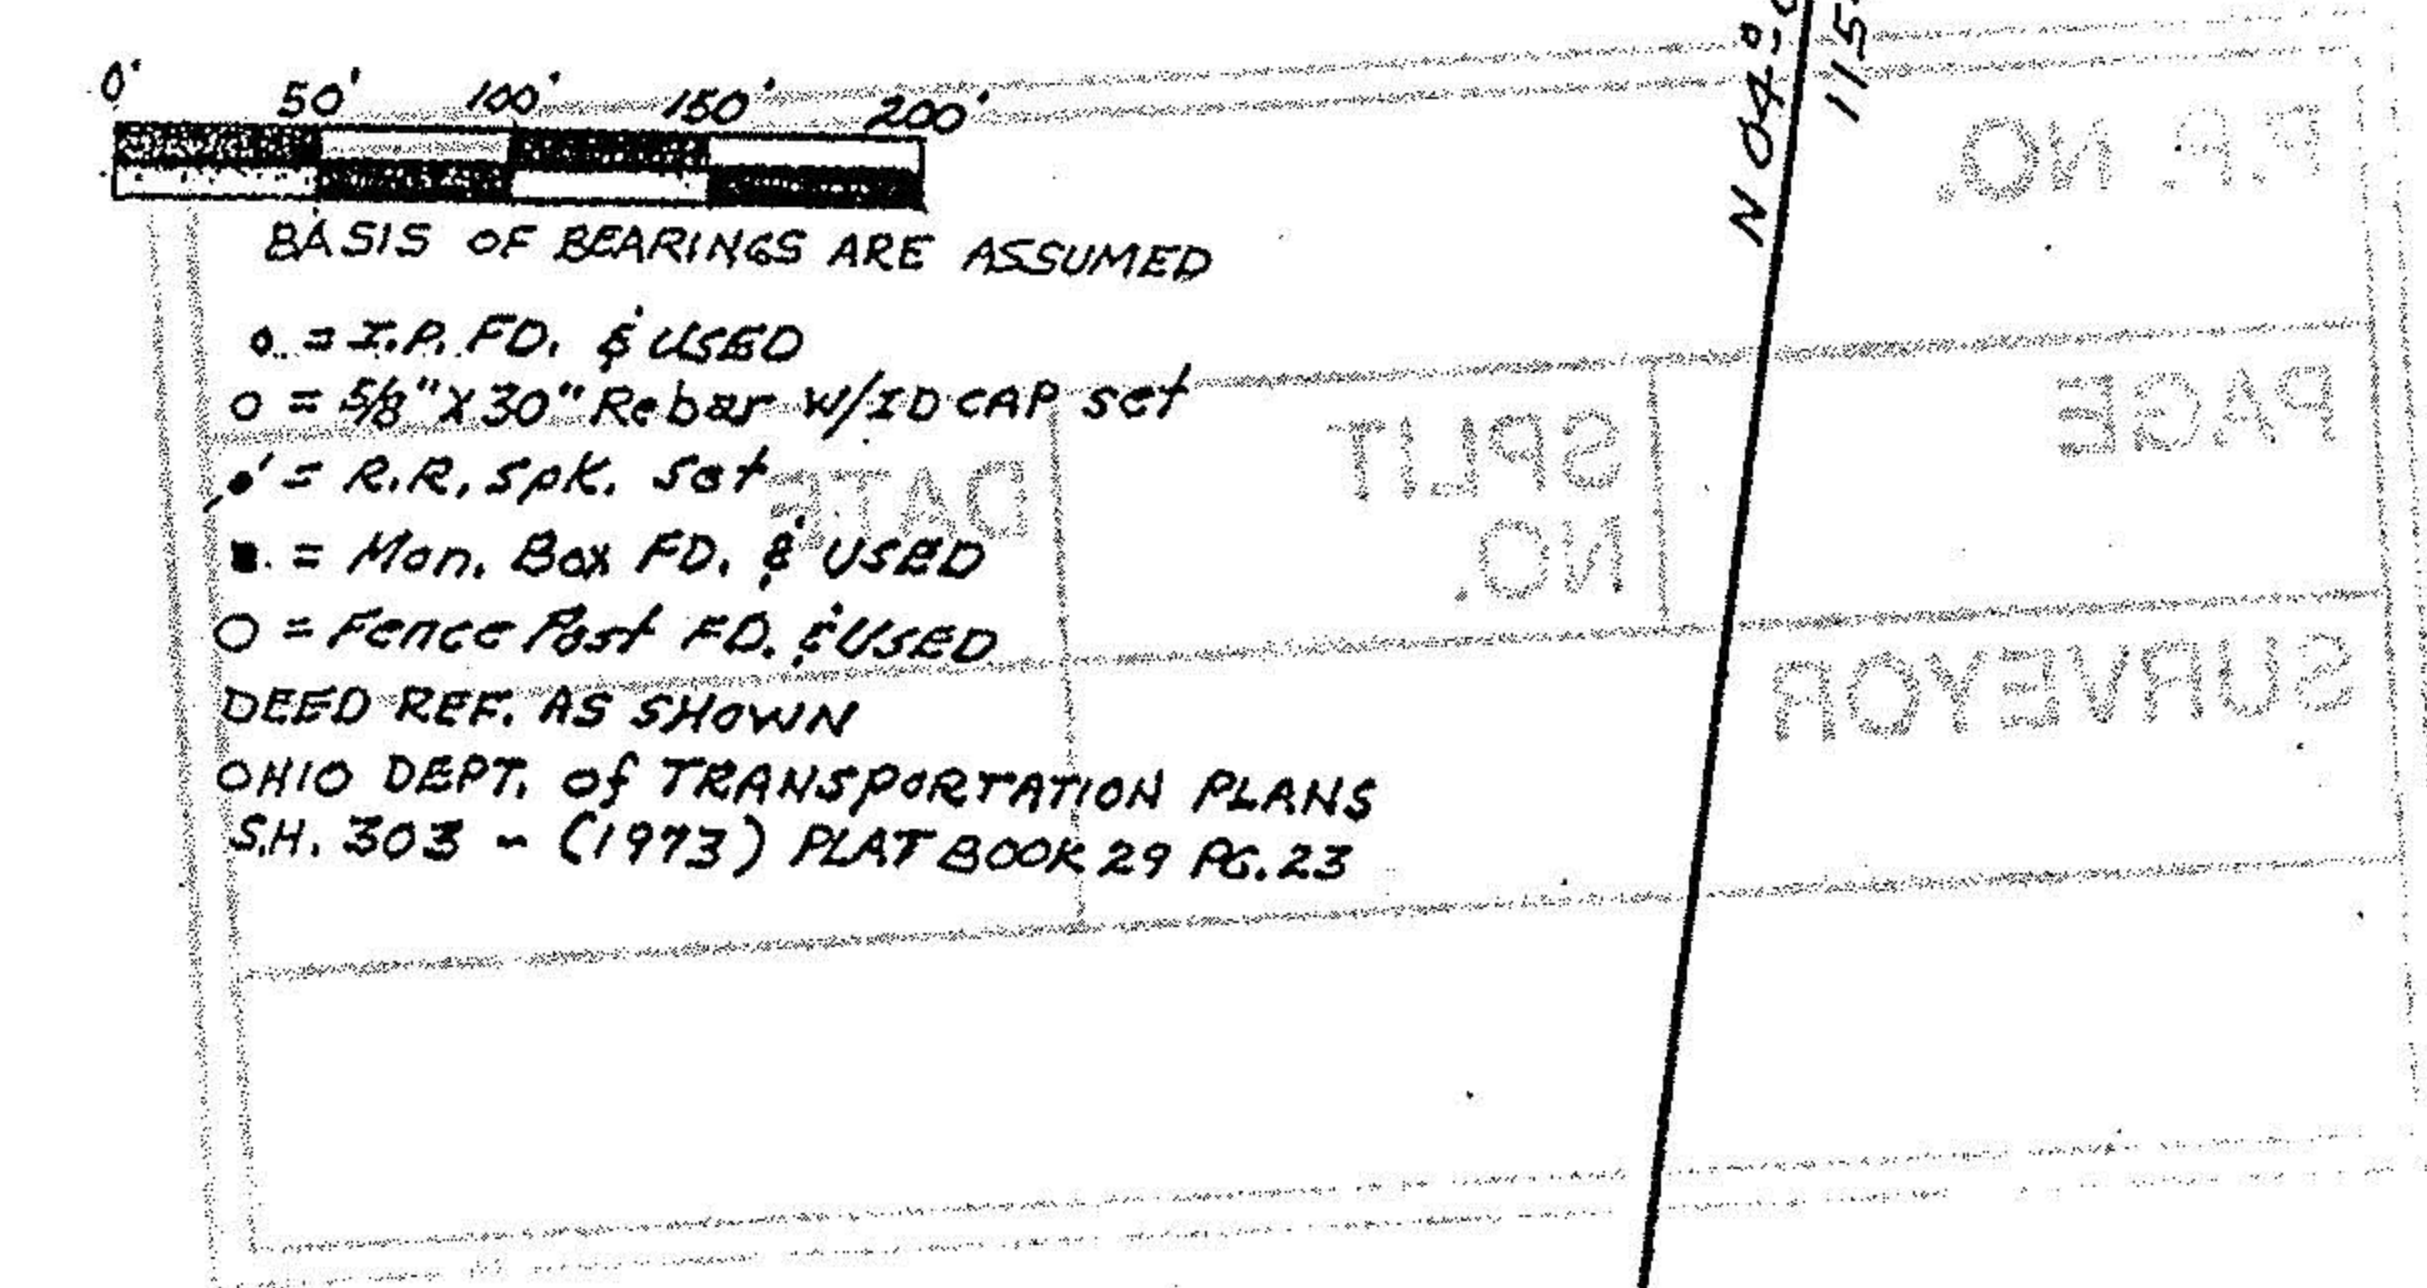

I Certify This Survey And Plat To Be Correct To The Best of My Knowledge
6 May 96
Thomas A. Shamp
2337 W. Smithville Wstrn. Rd.
Wooster, Ohio 44691
Revised 1 July 96

VOID (2)

TED J. & SONIA M. SCHRIVER
VOL. 1385, PG. 102
54 ACRES

HENRY H. & DOROTHY E. SCHRIVER
VOL. 657, PG. 236
" 334, " 332
30 ACRES

Timothy & Bernadette A. Zielinski
VOL. 1190, PG. 902
60 ACRES

5.033 ACRES
+ 0.267 RW
5.300 ACRES

HENRY H. & DOROTHY E. SCHRIVER
VOL. 657, PG. 236
" 334, " 332
30 ACRES

Timothy & Bernadette A. Zielinski
VOL. 1190, PG. 902
60 ACRES

5.033 ACRES
+ 0.267 RW
5.300 ACRES

TED J. & SONIA M. SCHRIVER
VOL. 1385, PG. 102
54 ACRES

SURVEY PLAT of a 5.300 ACRE PARCEL
LOT NUMBER 43
T-4-N R-16-W
GRAFTON TOWNSHIP
LORAIN COUNTY, OHIO