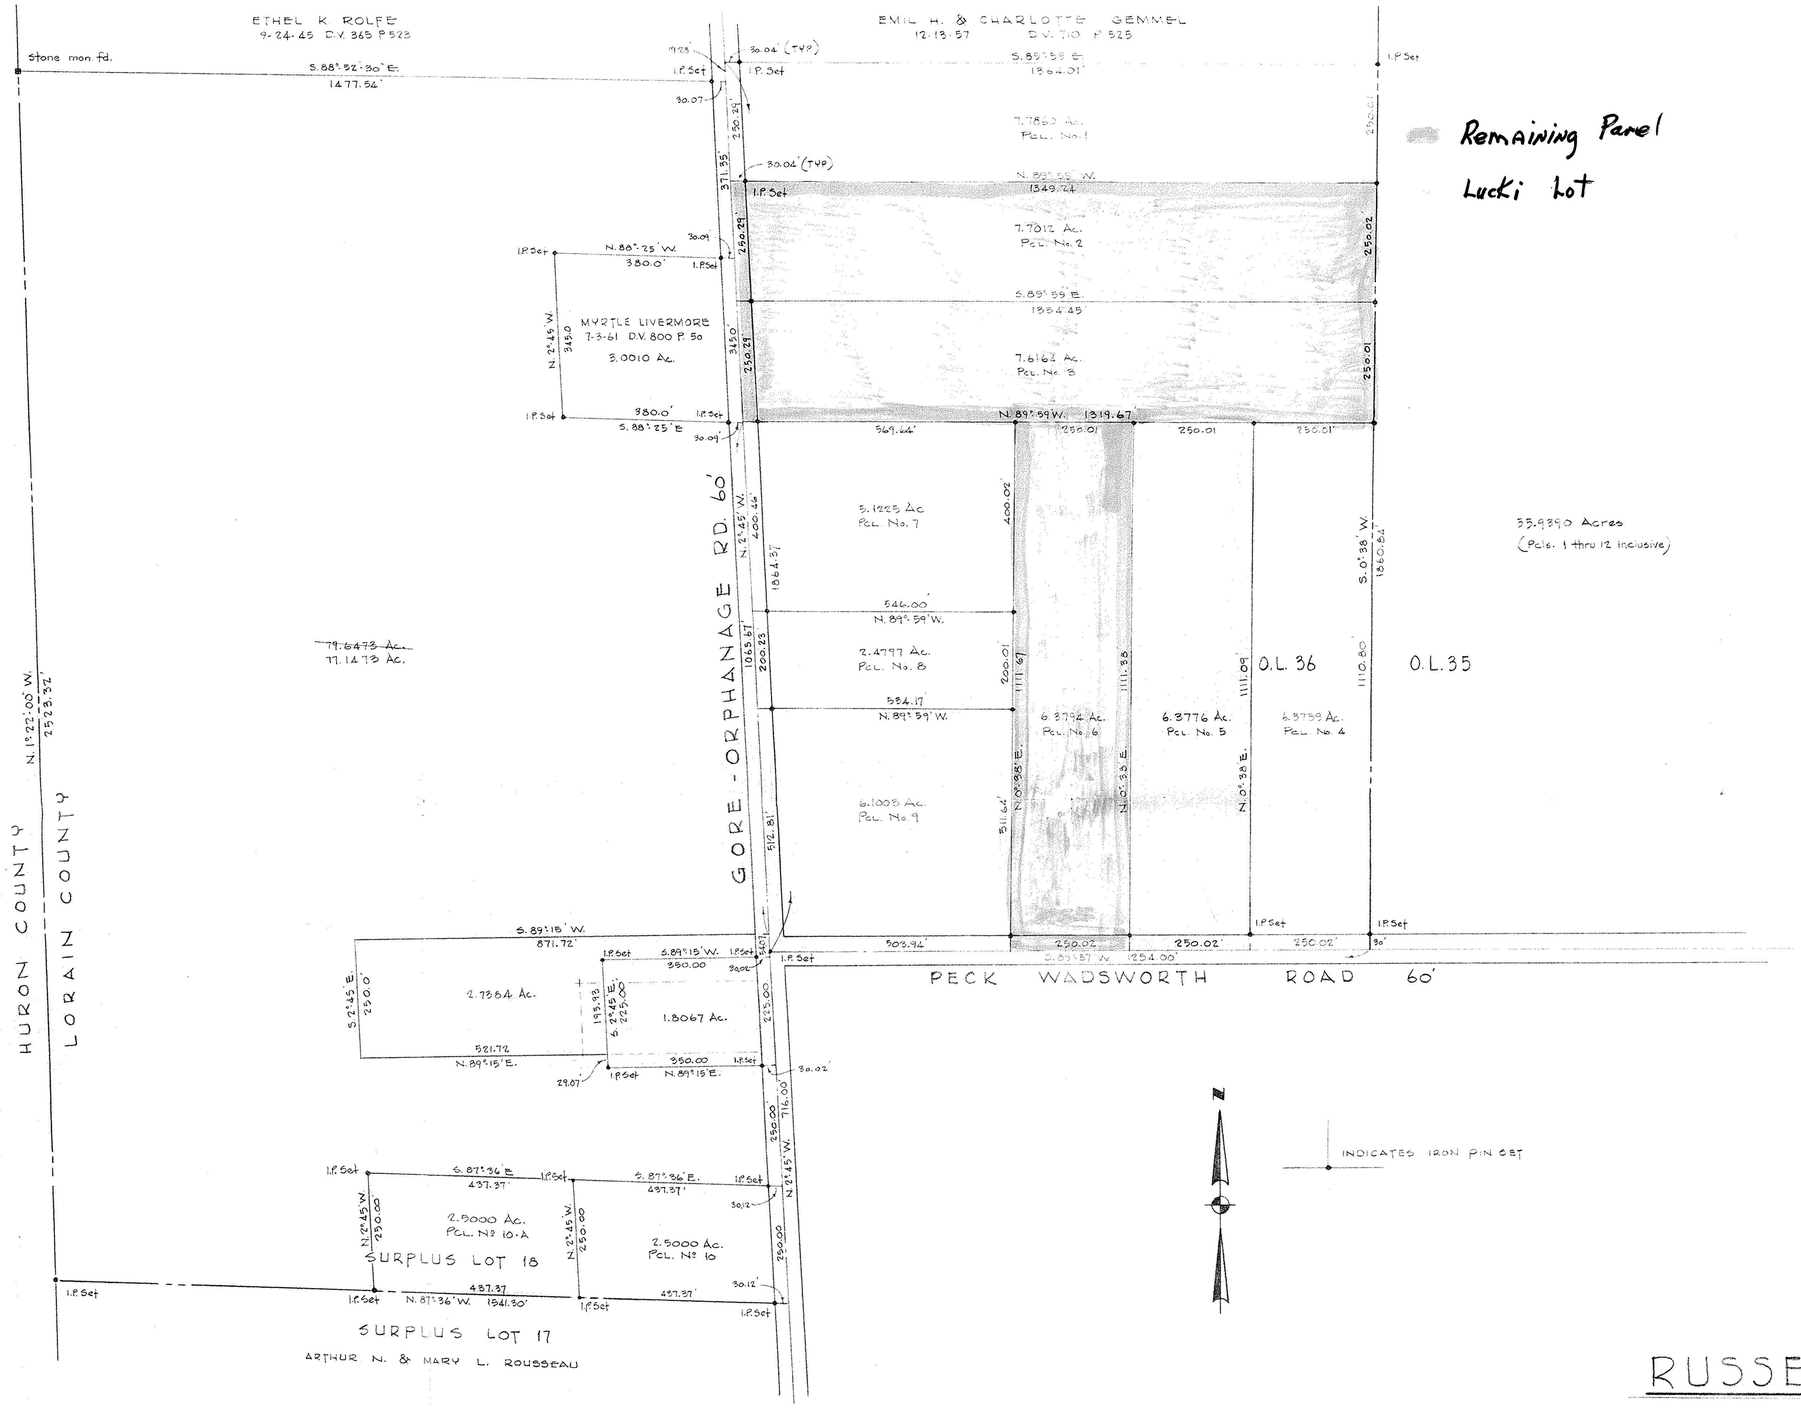

Remaining Parcel
Lucki Lot

17-08-036-000-

#18904
APPROVED
LORAIN CO.
MAP DEPT.
DATE 4-16-90
PAGE 17-A
BY CAROLYN FRANCIS
VOID AFTER # 18904

SURVEY FOR

RUSSEL L. SWORD

PART OF SURPLUS LOT 18 OF THE GORE STRIP AND ORIG. LOT 36
BRIGHTON TWP. LORAIN COUNTY OHIO
SCALE 1"=150 JULY, 1978

LANDON • SIMON • CAHL & ASSOC.
ENGINEERS SURVEYORS

STATE OF OHIO
RODGER G. SIMON
5101
REGISTERED
SURVEYOR

Job No. 76-549 F.B. 180 P. 51 Oct. '78
Job No. 78-769 F.B. 180 P 60 July '78
Job No. 79-924 No Field Book Oct. '79

REVISED 11-22-78 ADDN. of Pcls 2,3,5,6,7,8,9,10,11 & 12 R.G.S.
REVISED 10-15-79 HEGMAN PCL. (79-924)
REVISED 5-16-88 Deletion of Pcls 7 thru 12 Add Pcls 7, 8 & 9 R.G.S.

REVISED 5-16-88 ADDN. of PCL. No 10 RGS

98