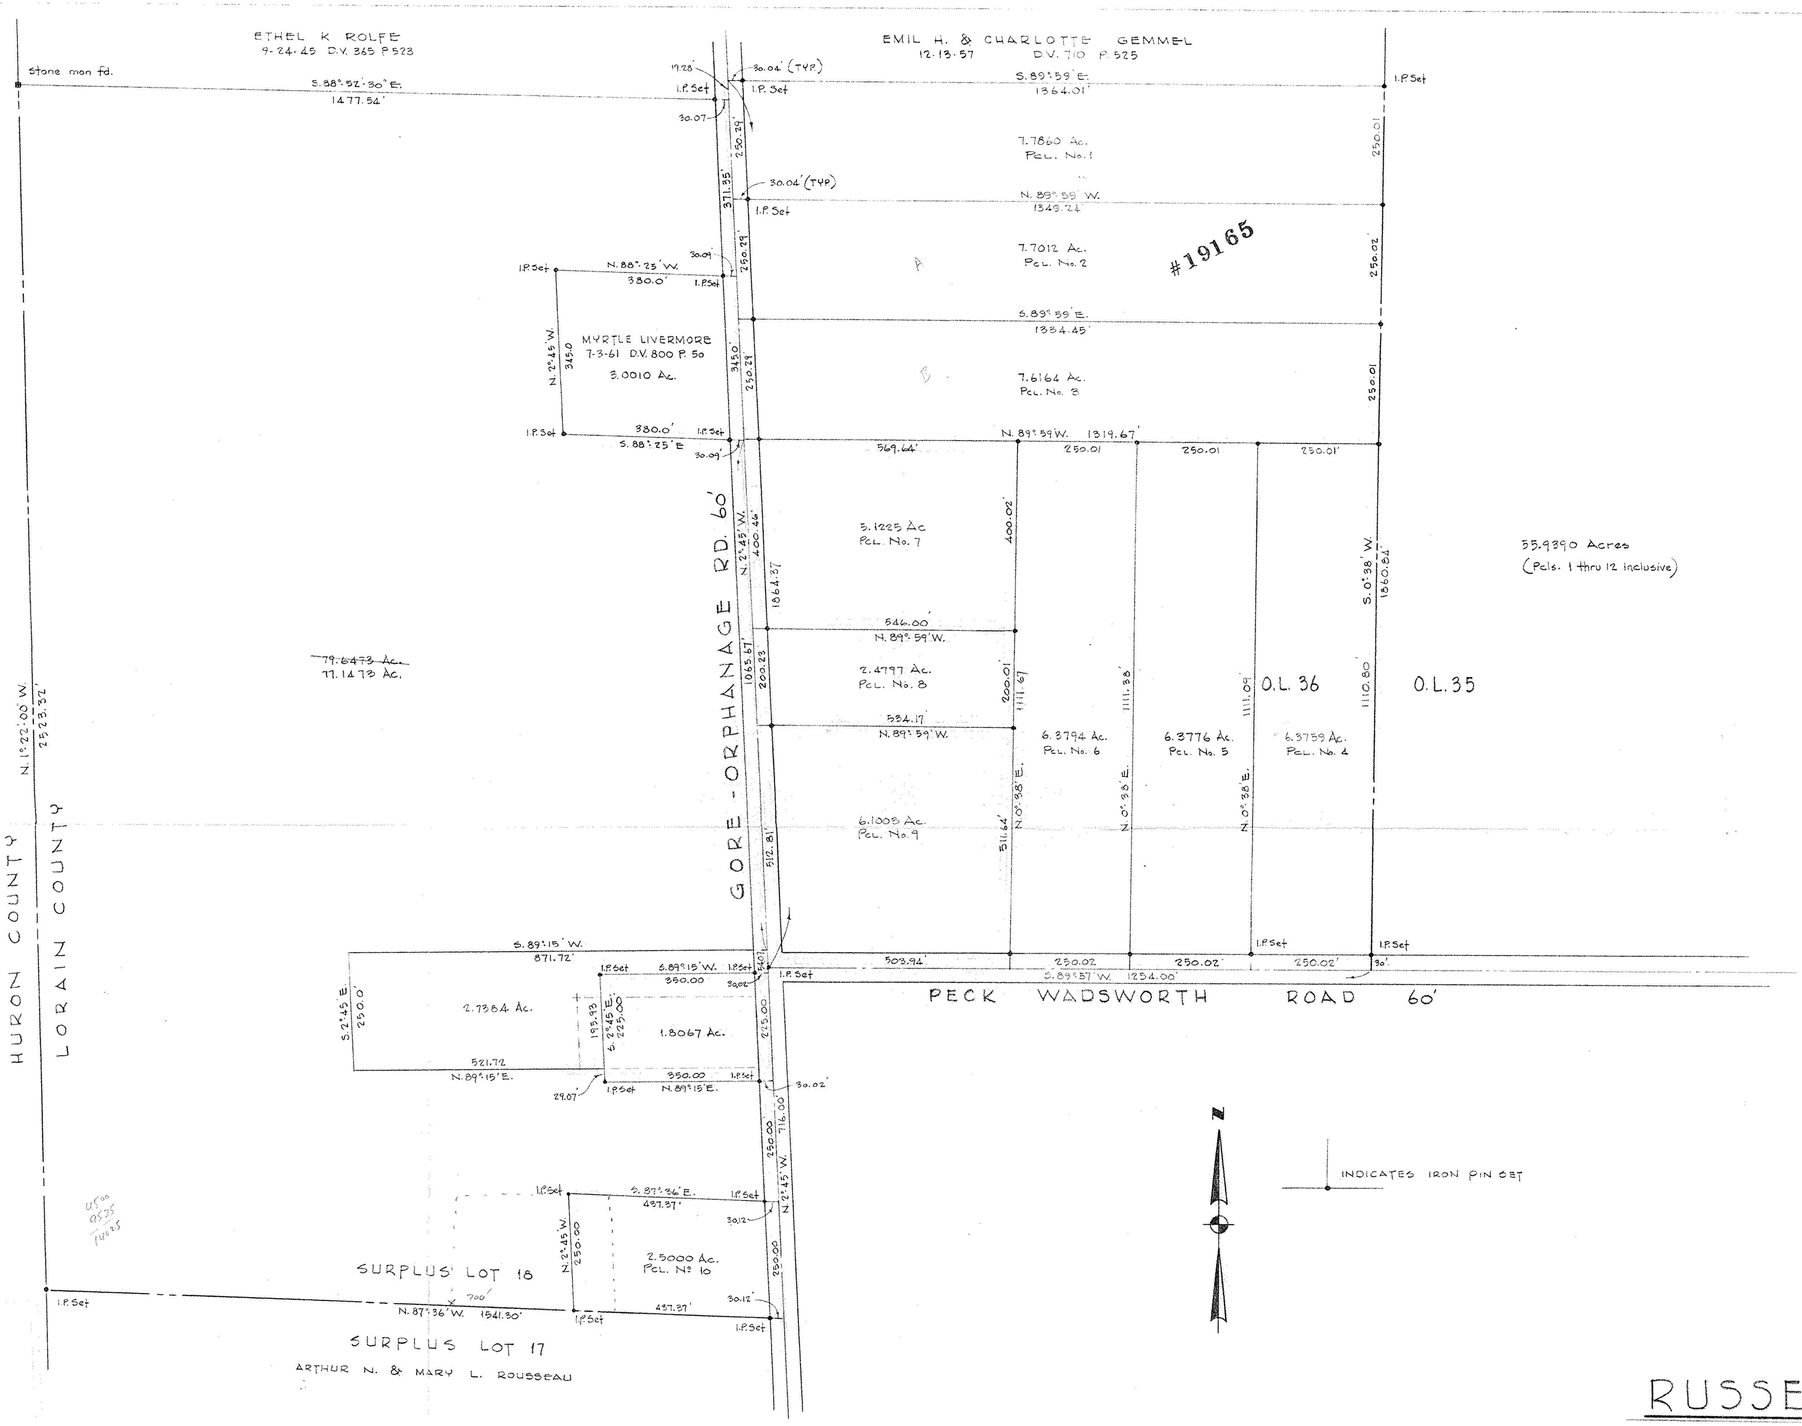

#19165

APPROVED
LORAIN CO.
MAP DEPT.
DATE 10-11-90
PAGE 17-A
BY CAROLYN FRANCIS
VOID AFTER #19165

17-08-036-000-

SURVEY FOR

RUSSEL L. SWORD

PART OF SURPLUS LOT 18 OF THE GORE STRIP AND ORIG. LOT 36
BRIGHTON TWP. LORAIN COUNTY OHIO
SCALE 1"=150' JULY, 1978

LAUNDON • SIMON • CAHL & ASSOC.
ENGINEERS SURVEYORS

Job No. 76-549 F.B. 180 P. 51 Oct. '78
Job No. 78-769 F.B. 180 P 60 July '78
Job No. 79-924 No Field Book Oct. '79

STATE OF OHIO
RODGER G. SIMON
5101
REGISTERED SURVEYOR

MAY 16 1988

REVISED 11-22-78 ADDN. of Pcls 2,3,5,6,7,8,9,10,11&12
REVISED 10-15-79 HEGMAN PCL. (79-924)
REVISED 5-16-88 Deletion of Pcls 7 thru 12 'A'

REVISED 5-16-88 ADDN. of PCL. No 10 RGS