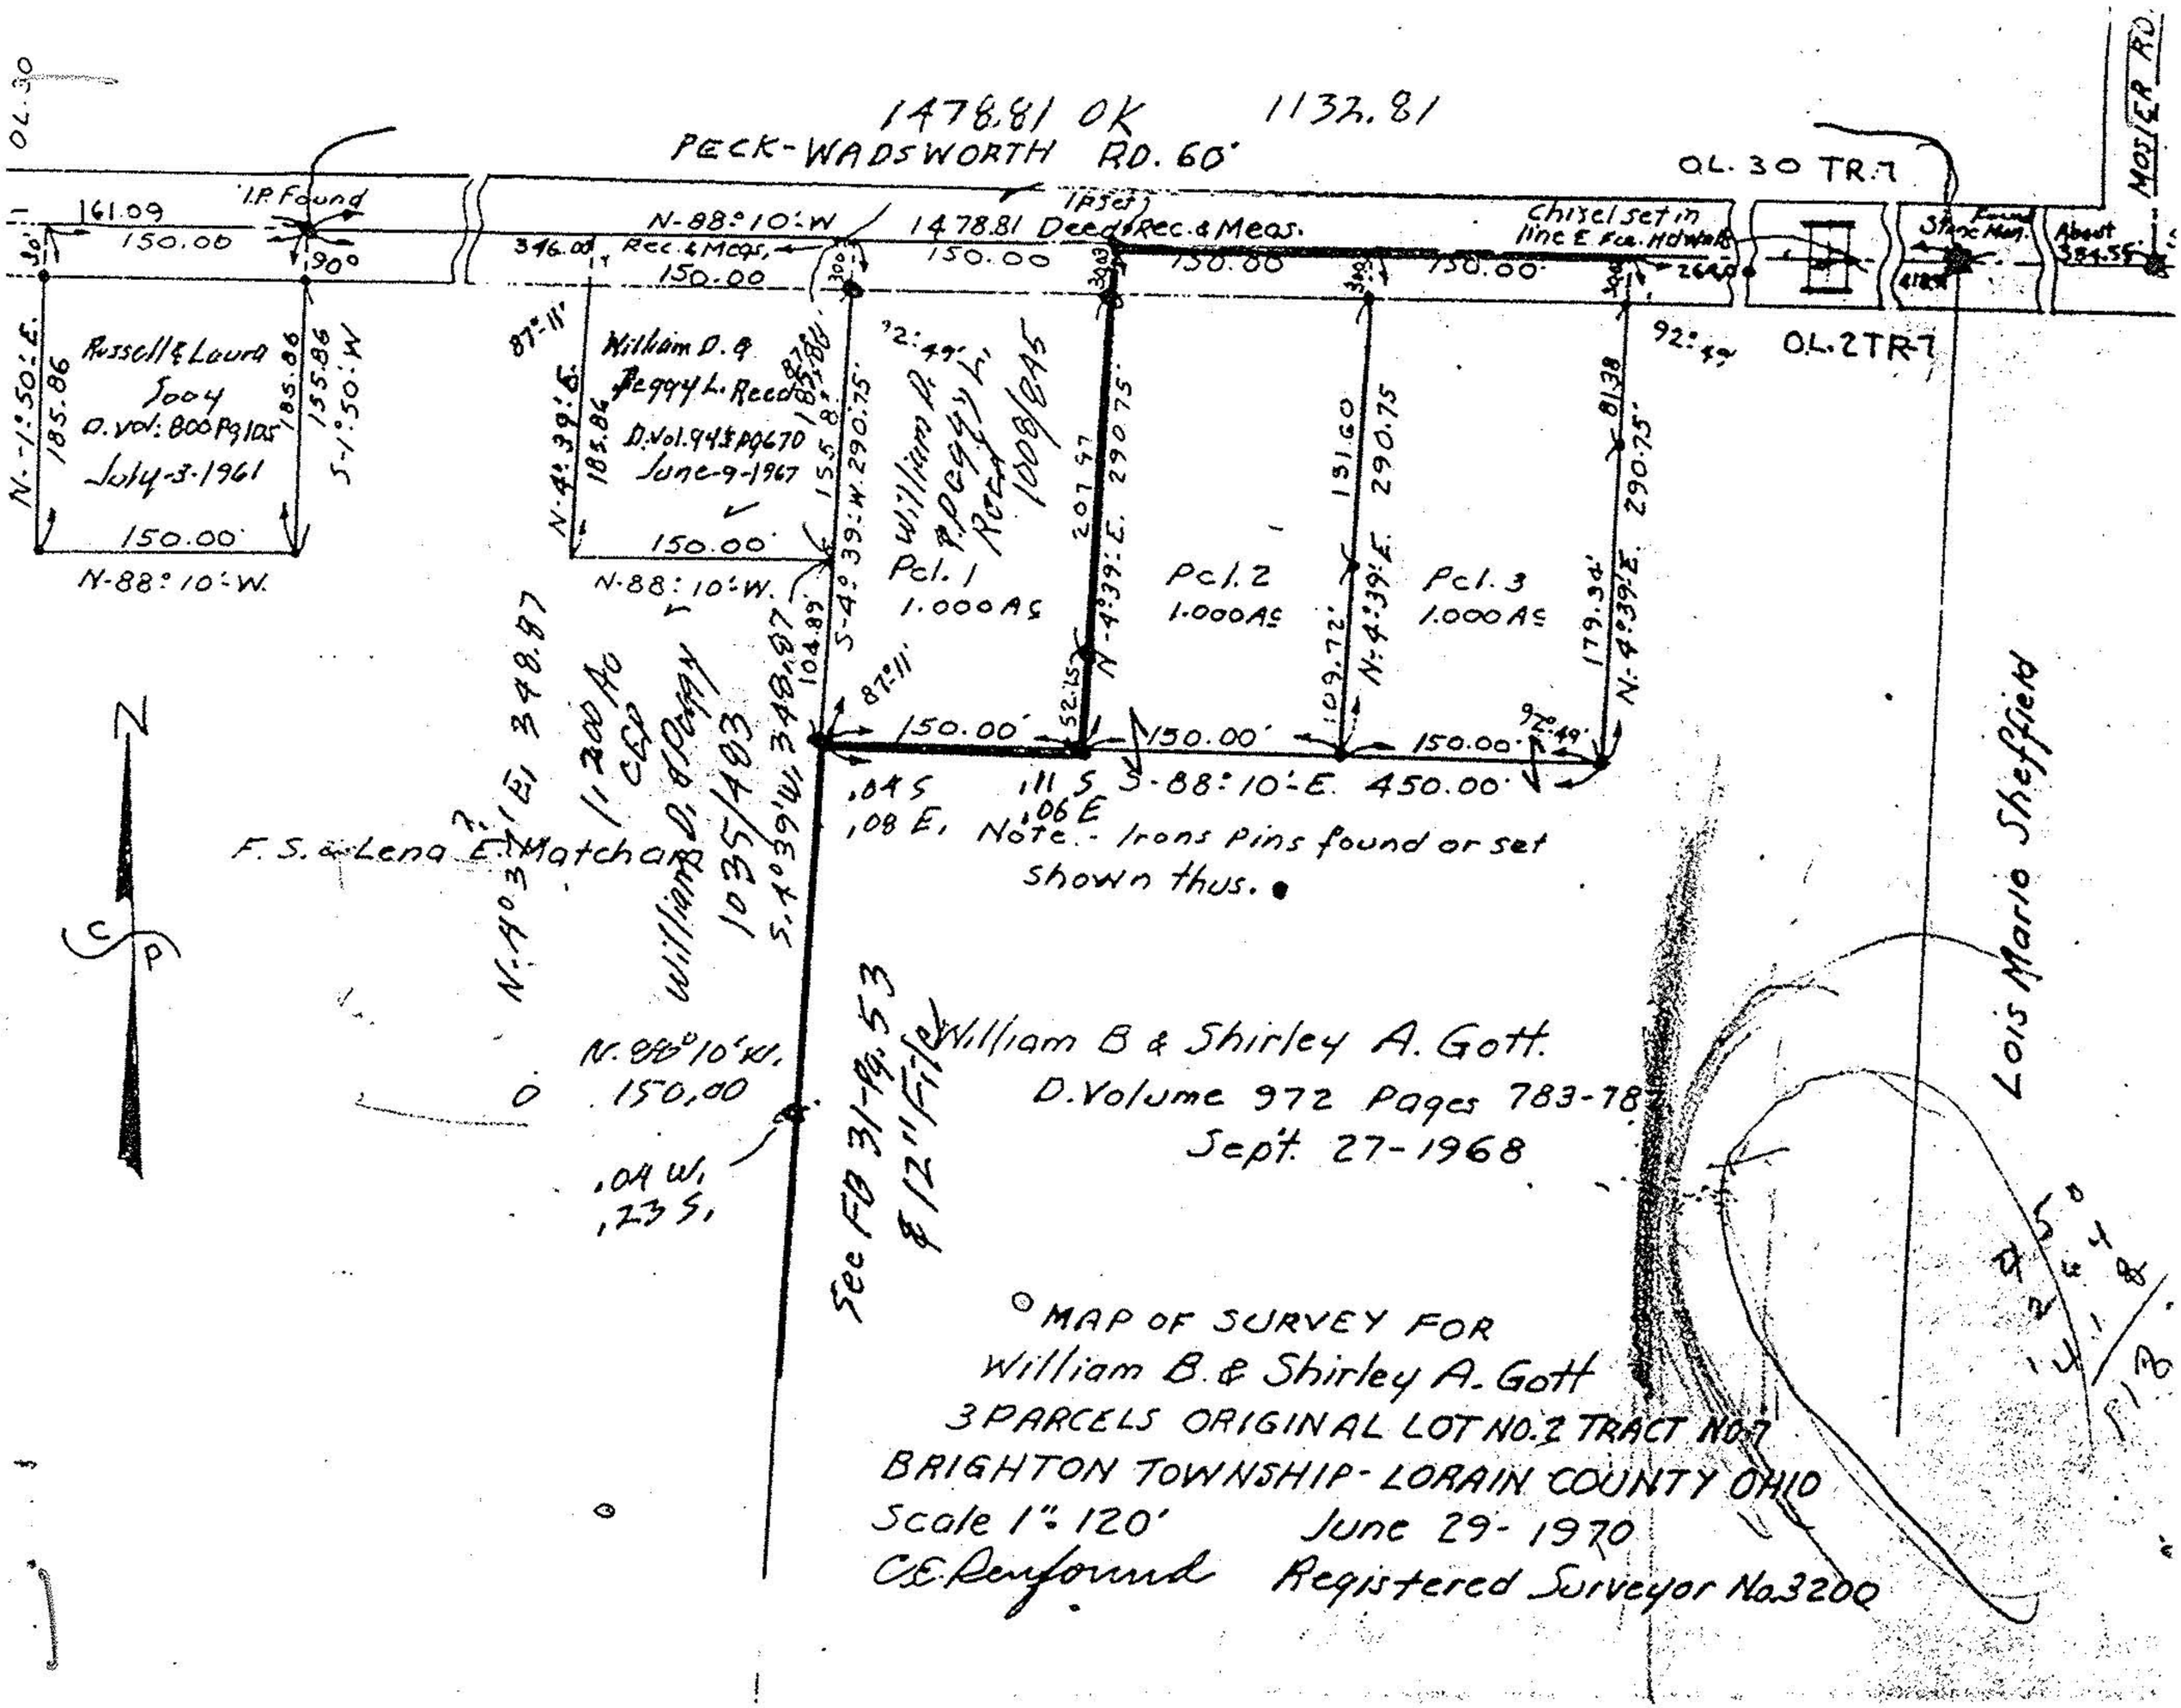
1478.81 OK 1132.81
PECK-WADSWORTH RD. 60'
OL. 30 TR. 7
OL. 2 TR. 7
MOSIER RD.
I.P. Found
161.09
150.00
90°
N-88°10'-W
346.00
Rec. & Meas.
150.00
1478.81 Deed Rec. & Meas.
150.00
150.00
150.00
Chisel set in line E Fce. Hdwalk
264.0
Stone Mon.
About 384.55
92°49'
Russell & Laura Jooy
D. Vol: 800 Pg 105
July-3-1961
185.86
155.86
N-1°50'-E.
S-1°50'-W
150.00
N-88°10'-W.
William D. & Peggy L. Reed
D. Vol. 943 Pg 670
June-9-1967
87°11'
N-4°39'-E.
185.86
155.8
S-4°39'-W. 290.75
92°49'
William D. & Peggy L. Reed
1008/845
Pcl. 1
1.000 AC
207.97
N-4°39'-E. 290.75
Pcl. 2
1.000 AC
131.60
N-4°39'-E. 290.75
Pcl. 3
1.000 AC
81.38
N-4°39'-E. 290.75
179.34
N-4°39'-E.
104.89
87°11'
52.15
109.72
92°49'
150.00
150.00
150.00
S-88°10'-E. 450.00
.04 S
.08 E.
.11 S
.06 E
Note.- Irons Pins found or set shown thus.
N-4°37'-E. 348.87
1.200 Ac CEP
William D. & Peggy
1035/483
S-4°39'-W. 348.87
F. S. & Lena E. Matcham
N
C
P
N. 88°10'-W.
150.00
.04 W.
.23 S.
See FB 31-Pg. 53 & 12" File
William B & Shirley A. Gott.
D. Volume 972 Pages 783-787
Sept. 27-1968
Lois Marie Sheffield
MAP OF SURVEY FOR
William B. & Shirley A. Gott
3 PARCELS ORIGINAL LOT NO. 2 TRACT NO. 7
BRIGHTON TOWNSHIP - LORAIN COUNTY OHIO
Scale 1" = 120'
June 29-1970
C.E. Renfound
Registered Surveyor No. 3200