O L 2+3
17-C
17-D

PART OF O.L. 2&3 TRACT 7, BRIGHTON TWP.
LORAIN, COUNTY, OHIO
SCALE: 1"=100 FT.

OCT. 11, 1976

17-07-002-000
17-07-003-000

MAR 11 1977

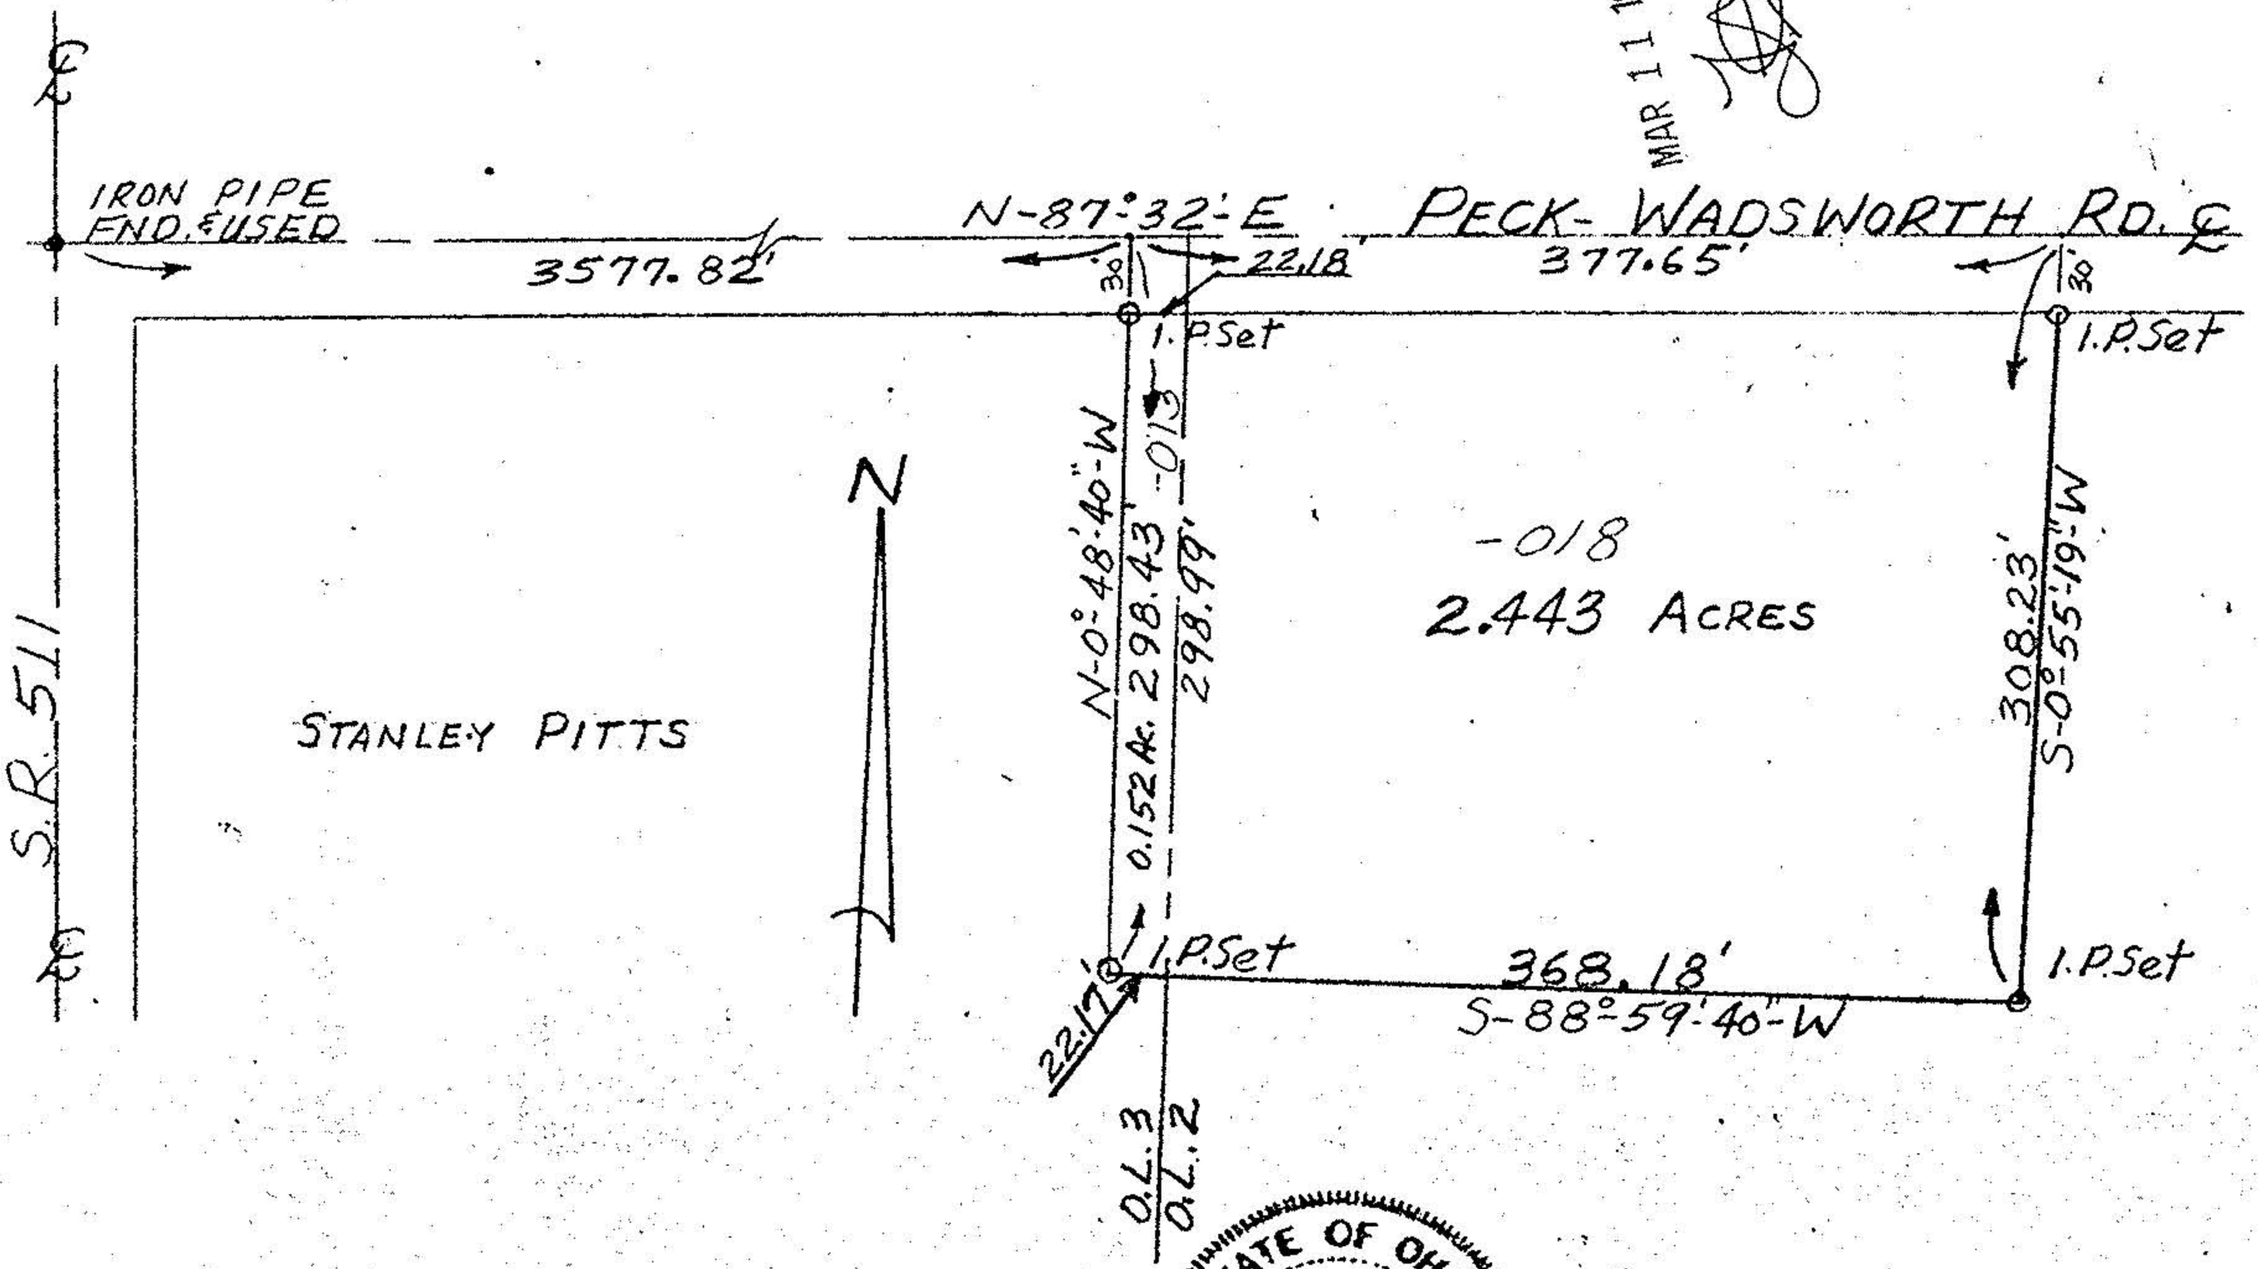

STATE OF OHIO
WILLIAM L. FOX 5878
REGISTERED PROFESSIONAL SURVEYOR

William L. Fox
WILLIAM L. FOX, SURVEYOR
REGISTRATION NO. 5878