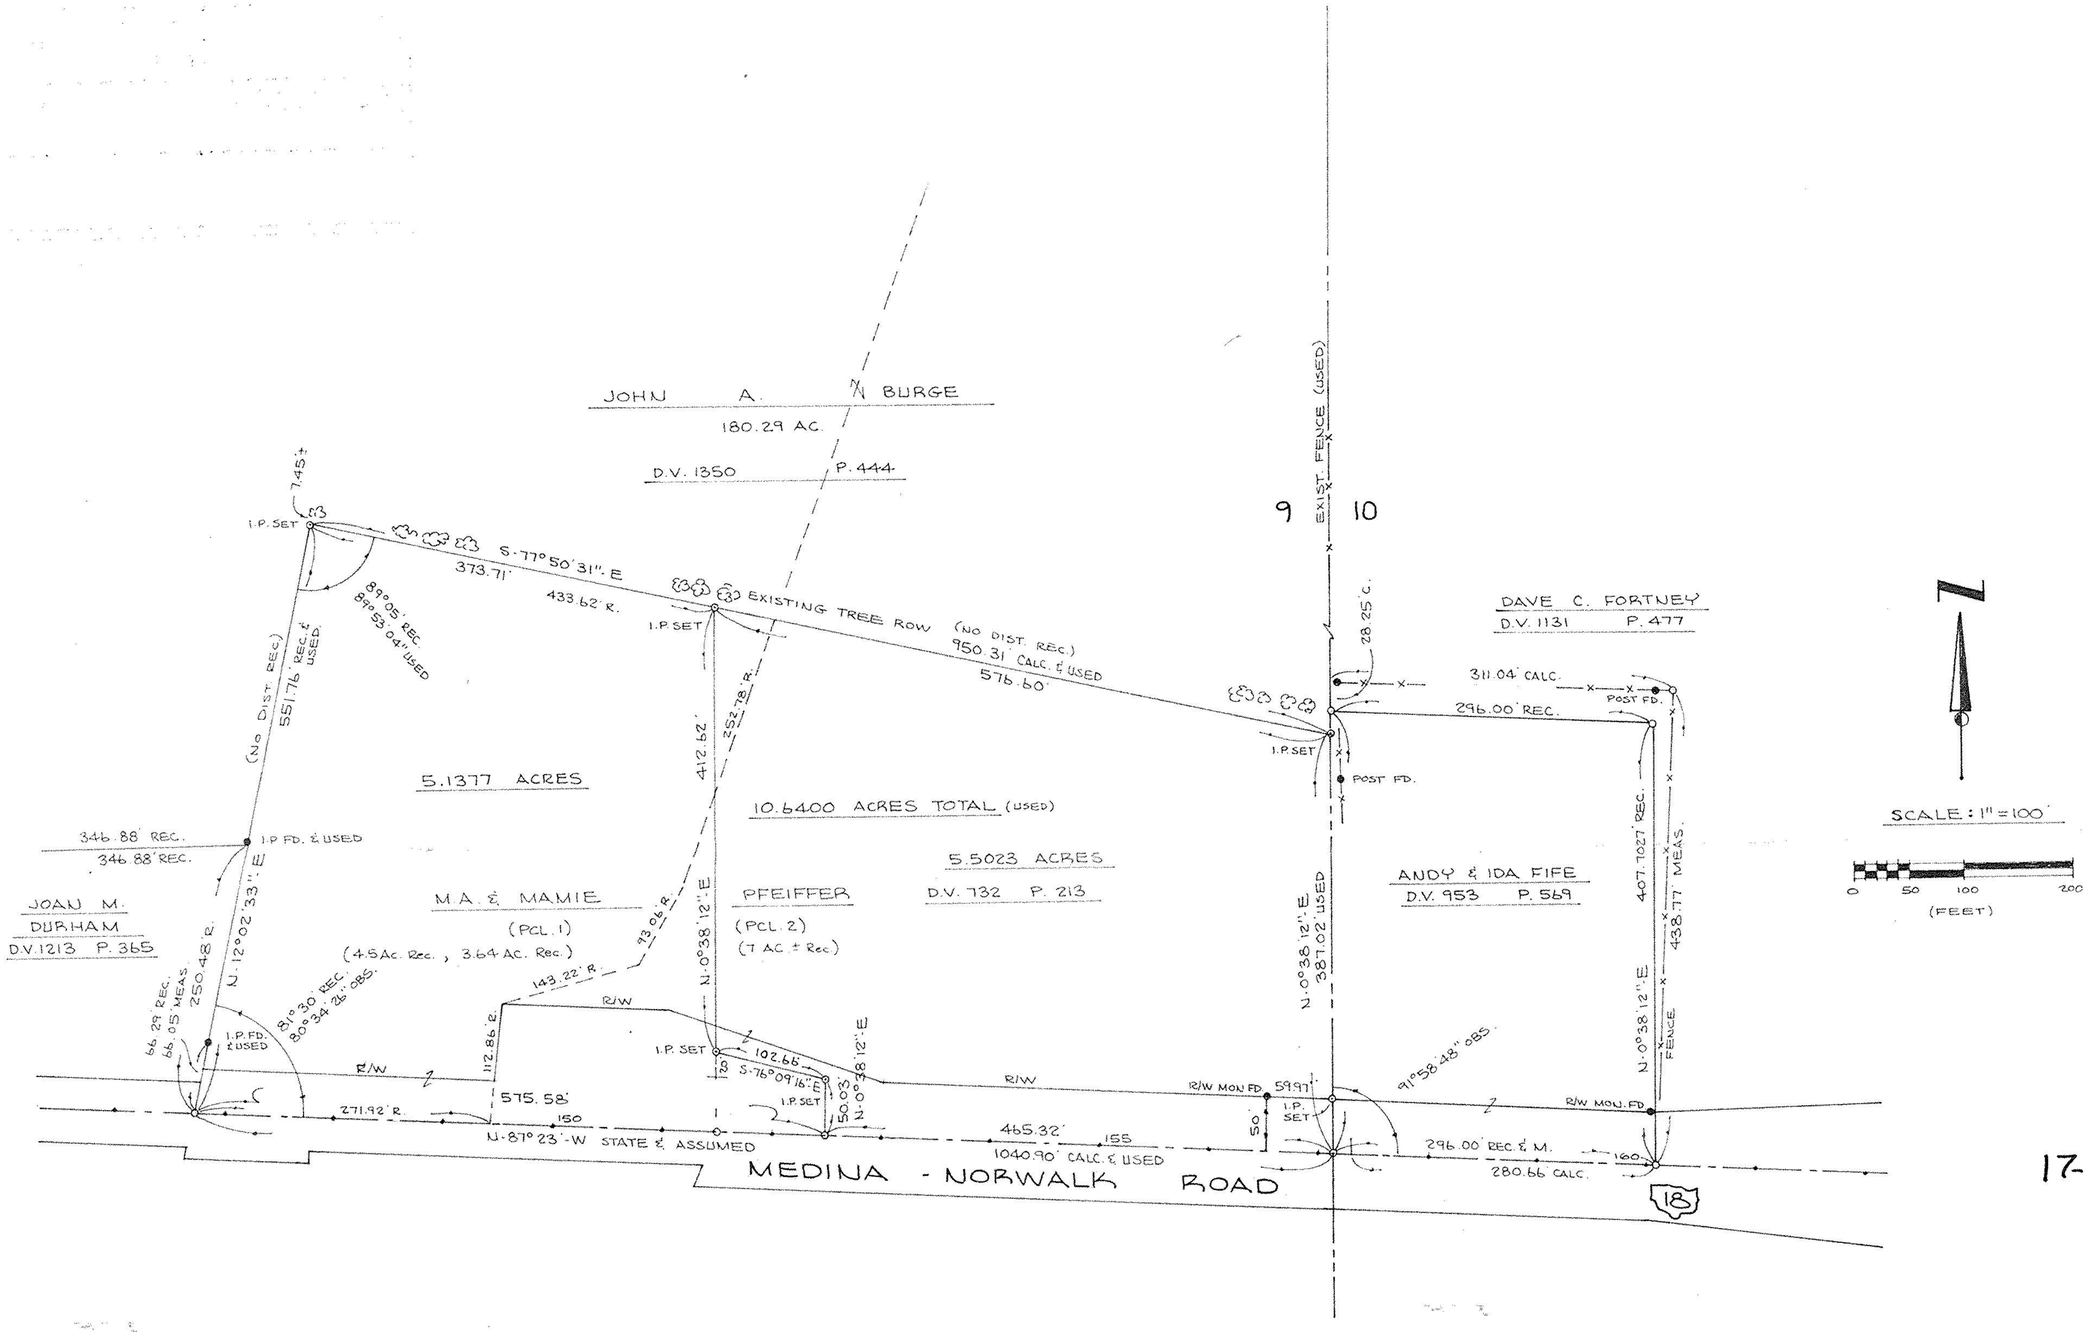

17-07-009-000

BOUNDARY SURVEY

PART OF BRIGHTON TOWNSHIP
ORIGINAL LOT 9 TRACT 7
TOWNSHIP OF BRIGHTON
COUNTY OF LORAIN
STATE OF OHIO

PREPARED BY KS ASSOCIATES INC.
ENGINEERS SURVEYORS
APRIL 10, 1989

STATE OF OHIO
DAVID L. ELWELL
6333
REGISTERED SURVEYOR

David L. Elwell
REG. SURVEYOR NO. 6333

#18425
APPROVED
LORAIN CO.
MAP DEPT.
DATE 5-18-89
PAGE [redacted] 17 D
BY C. Francis
VOID AFTER # 18425