


WILLIAM B. BARTON  
 Reg. Land Surveyor No. 4438  
 188 PARKWOOD AVENUE  
 AVON LAKE, OHIO 44012  
 TELEPHONE (216) 933-6662

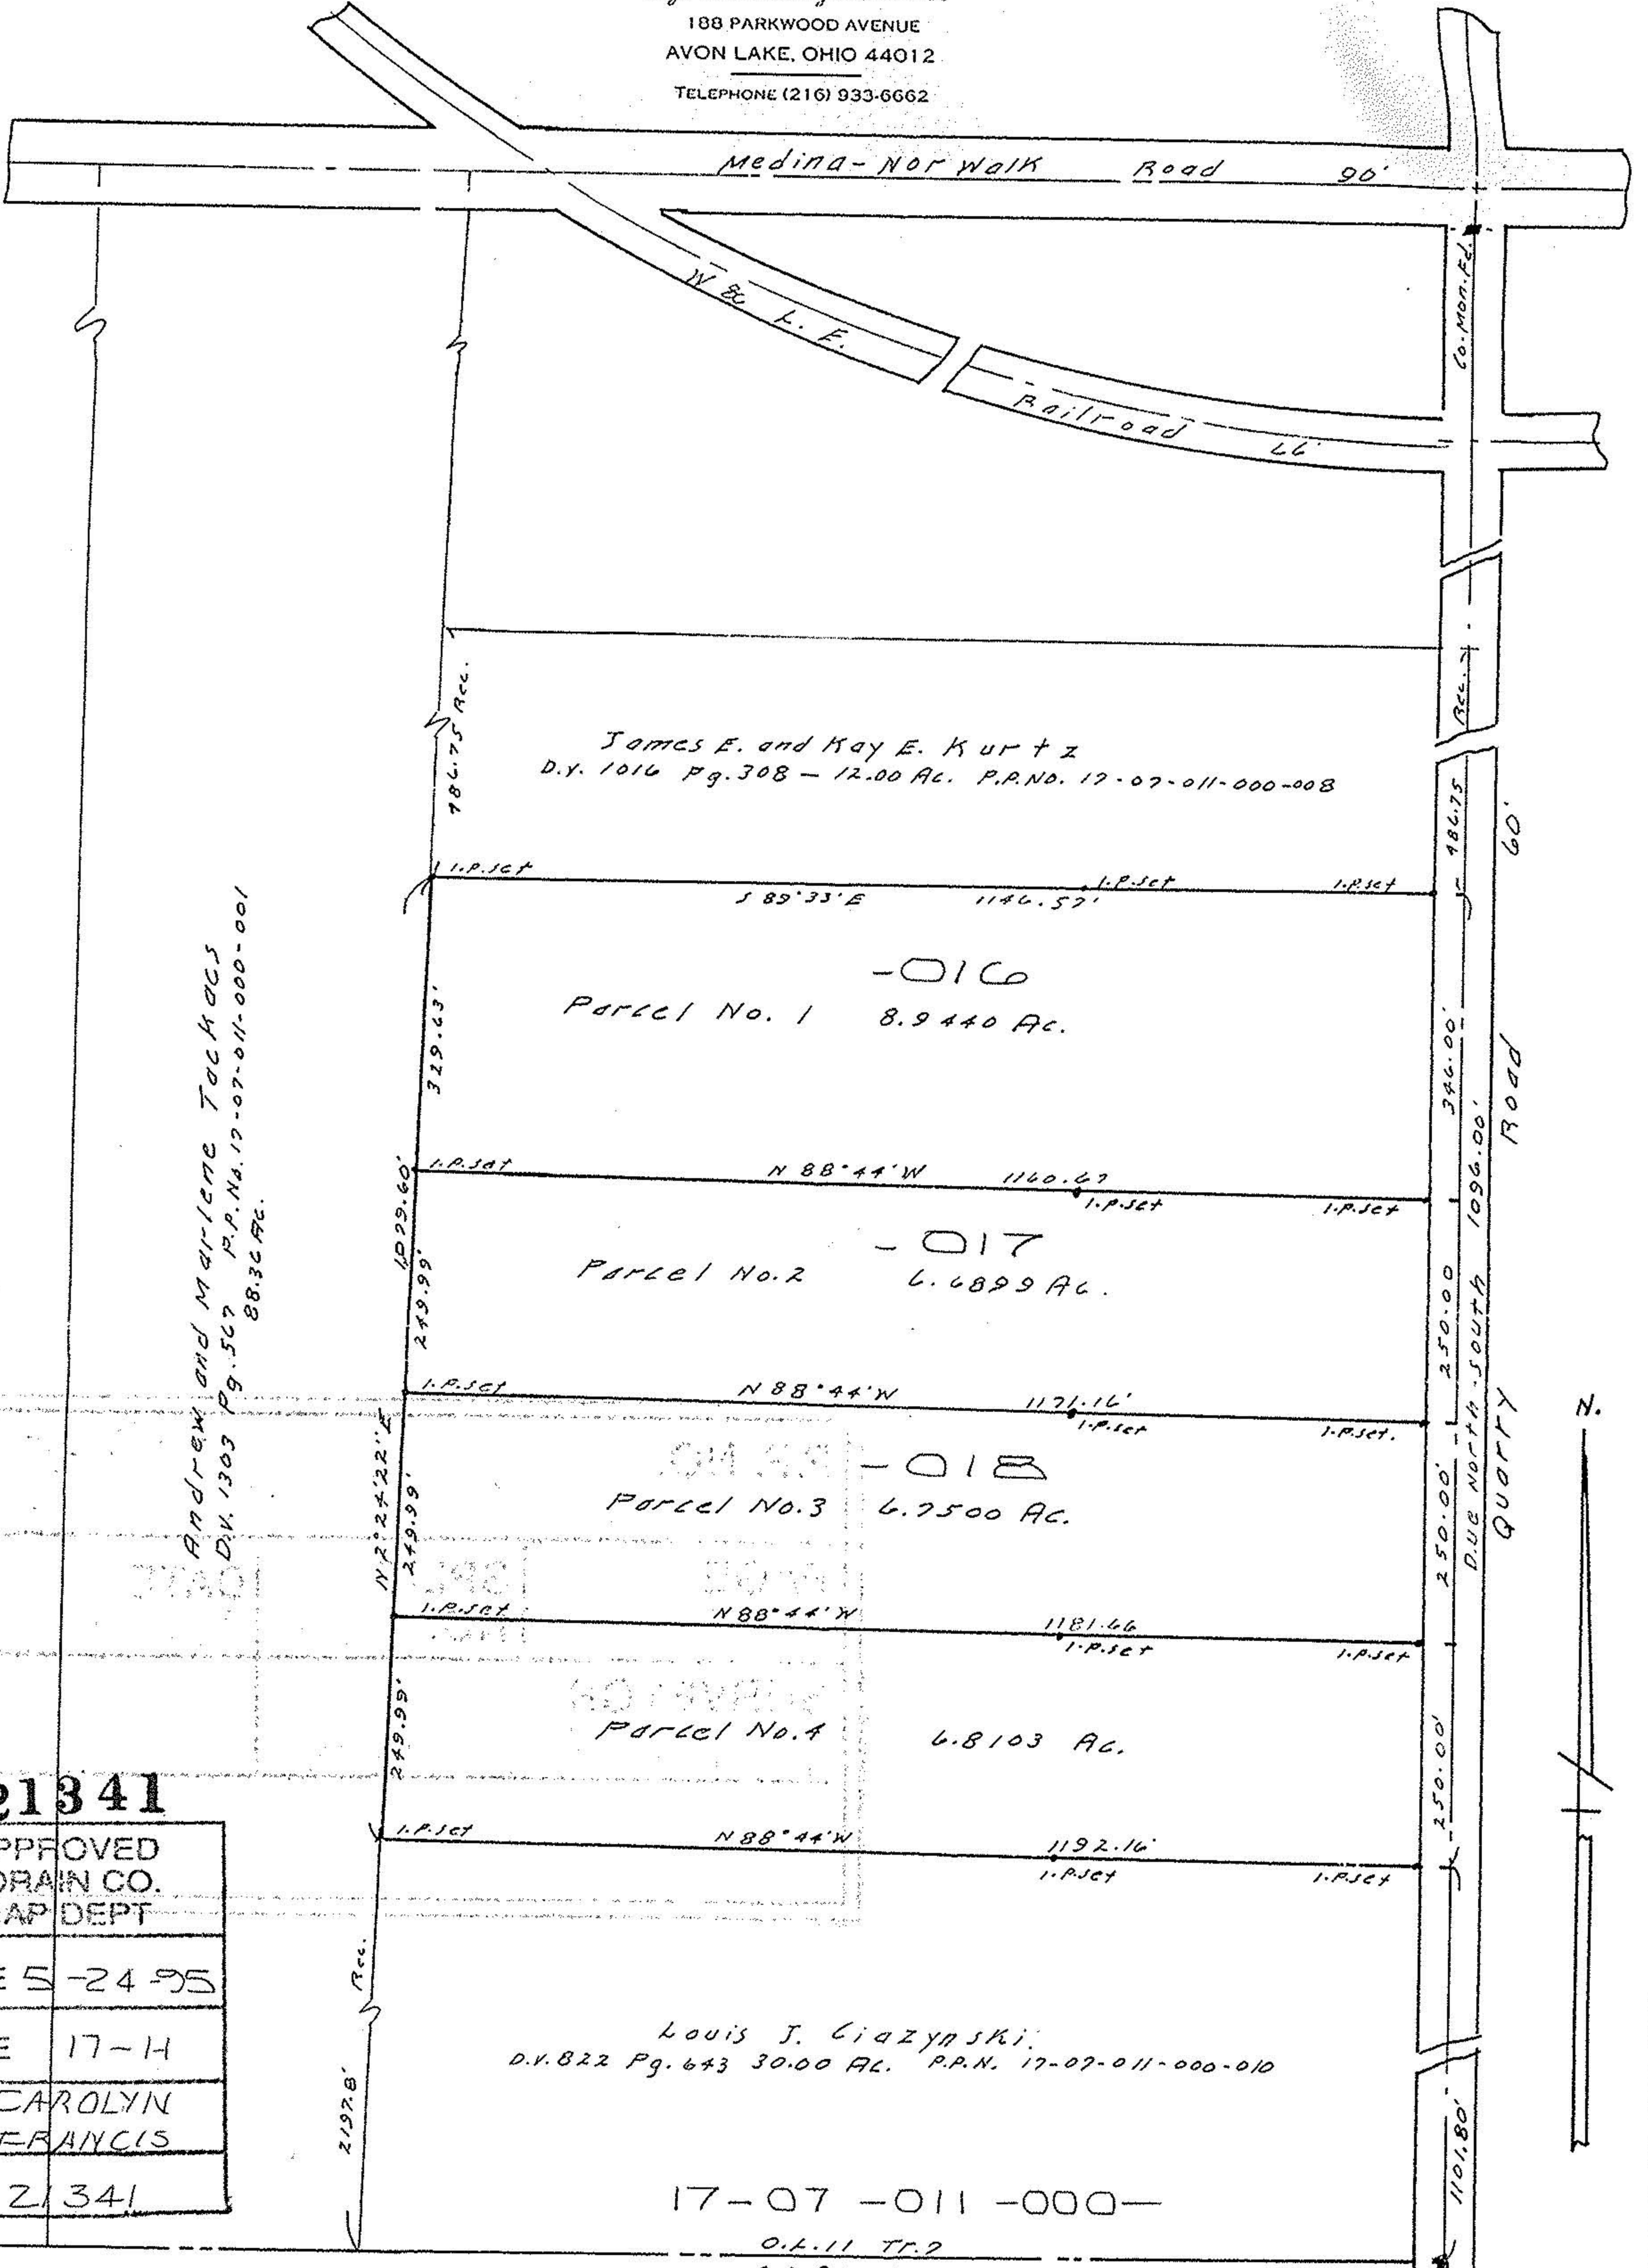

Andrew and Marlene Tackacs  
 D.V. 1303 Pg. 567 P.P. No. 17-07-011-000-001  
 88.32 Ac.

21341	
APPROVED	LORAIN CO.
MAP DEPT	
DATE	5-24-95
PAGE	17-14
BY	CAROLYN FRANCIS
	21341

Louis J. Ciazynski  
 D.V. 822 Pg. 643 30.00 AC. P.P. No. 17-07-011-000-010

17-07-011-000-  
 O.L. 11 Tr. 2  
 O.L. 30 Tr. 6

SURVEY  
 of  
 Part of Original Lot No. 11, Tract No. 7,  
 Brighton Township, Lorain Co., Ohio.  
 Scale 1"=200' March 17, 1988.



Brighton Twp. Co. Mon. Rd.  
 Wellington Twp.