17-07-015
17-G

Map of Part of Tract 7 Lot 15 Brighton Twp Lorain Co Ohio
Scale 1" = 100' June 9-1977
By A.F. Koepp. Registered Surveyor No 4306

#10652
2-2-78
17-G

17-G

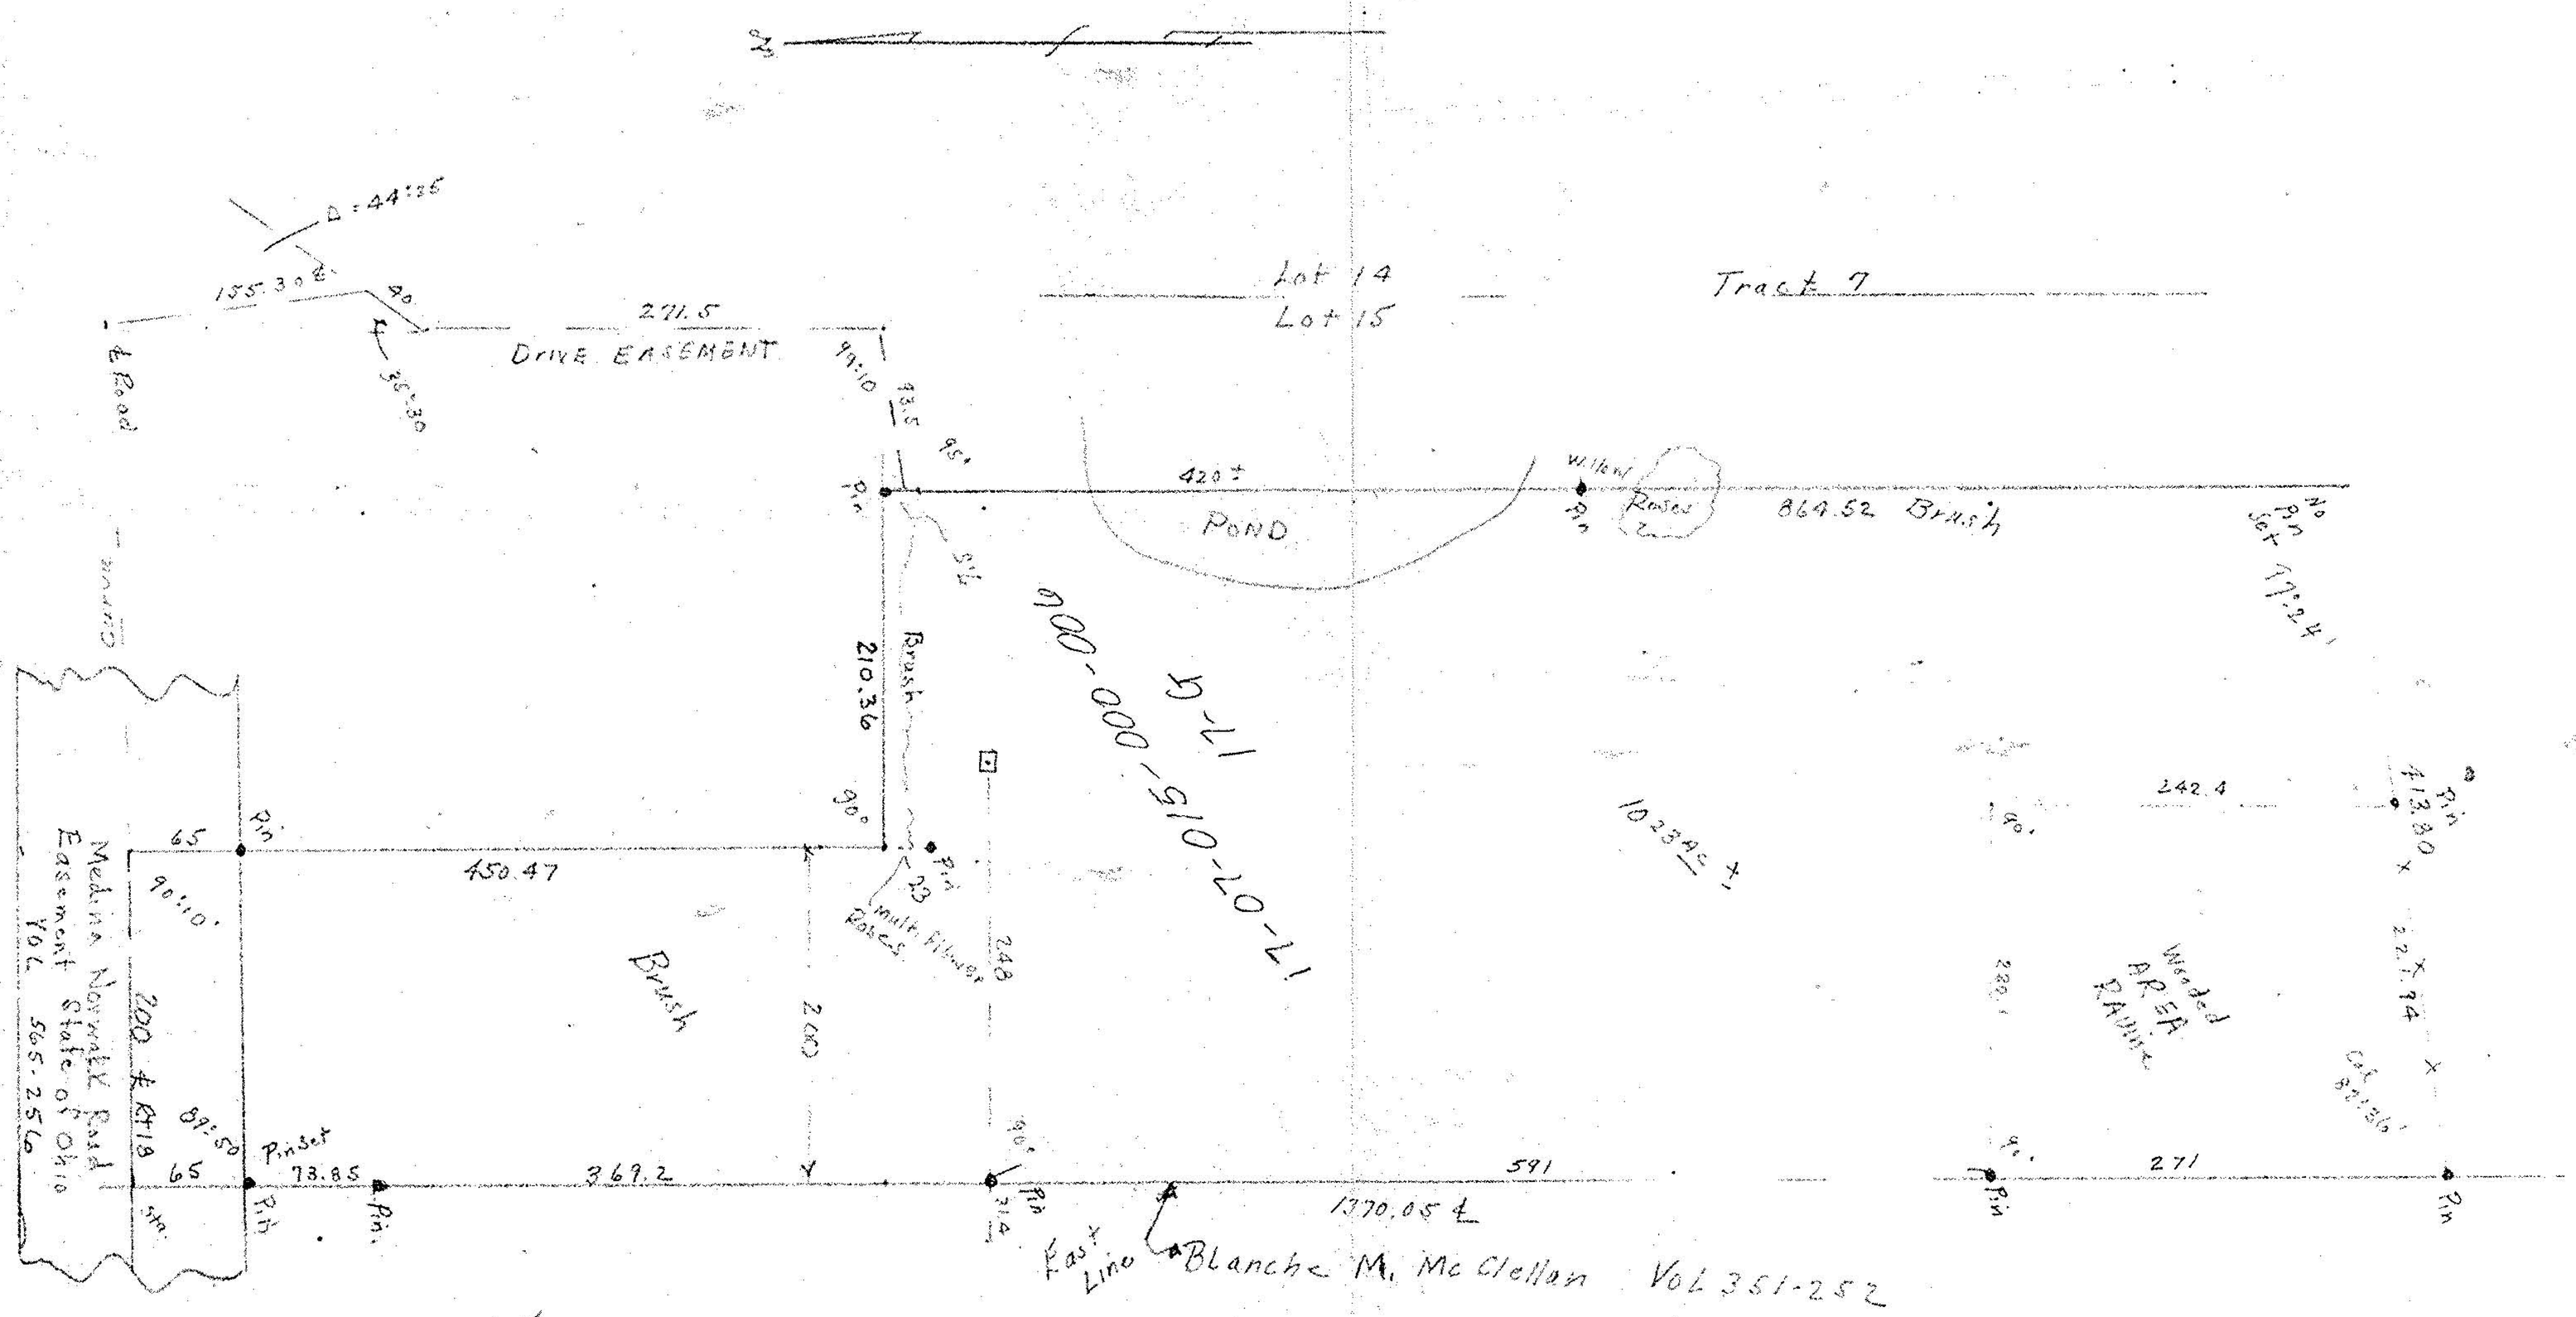


17-07-015