


Jessie Everson Moore D. Vol. 713 Pg. 449

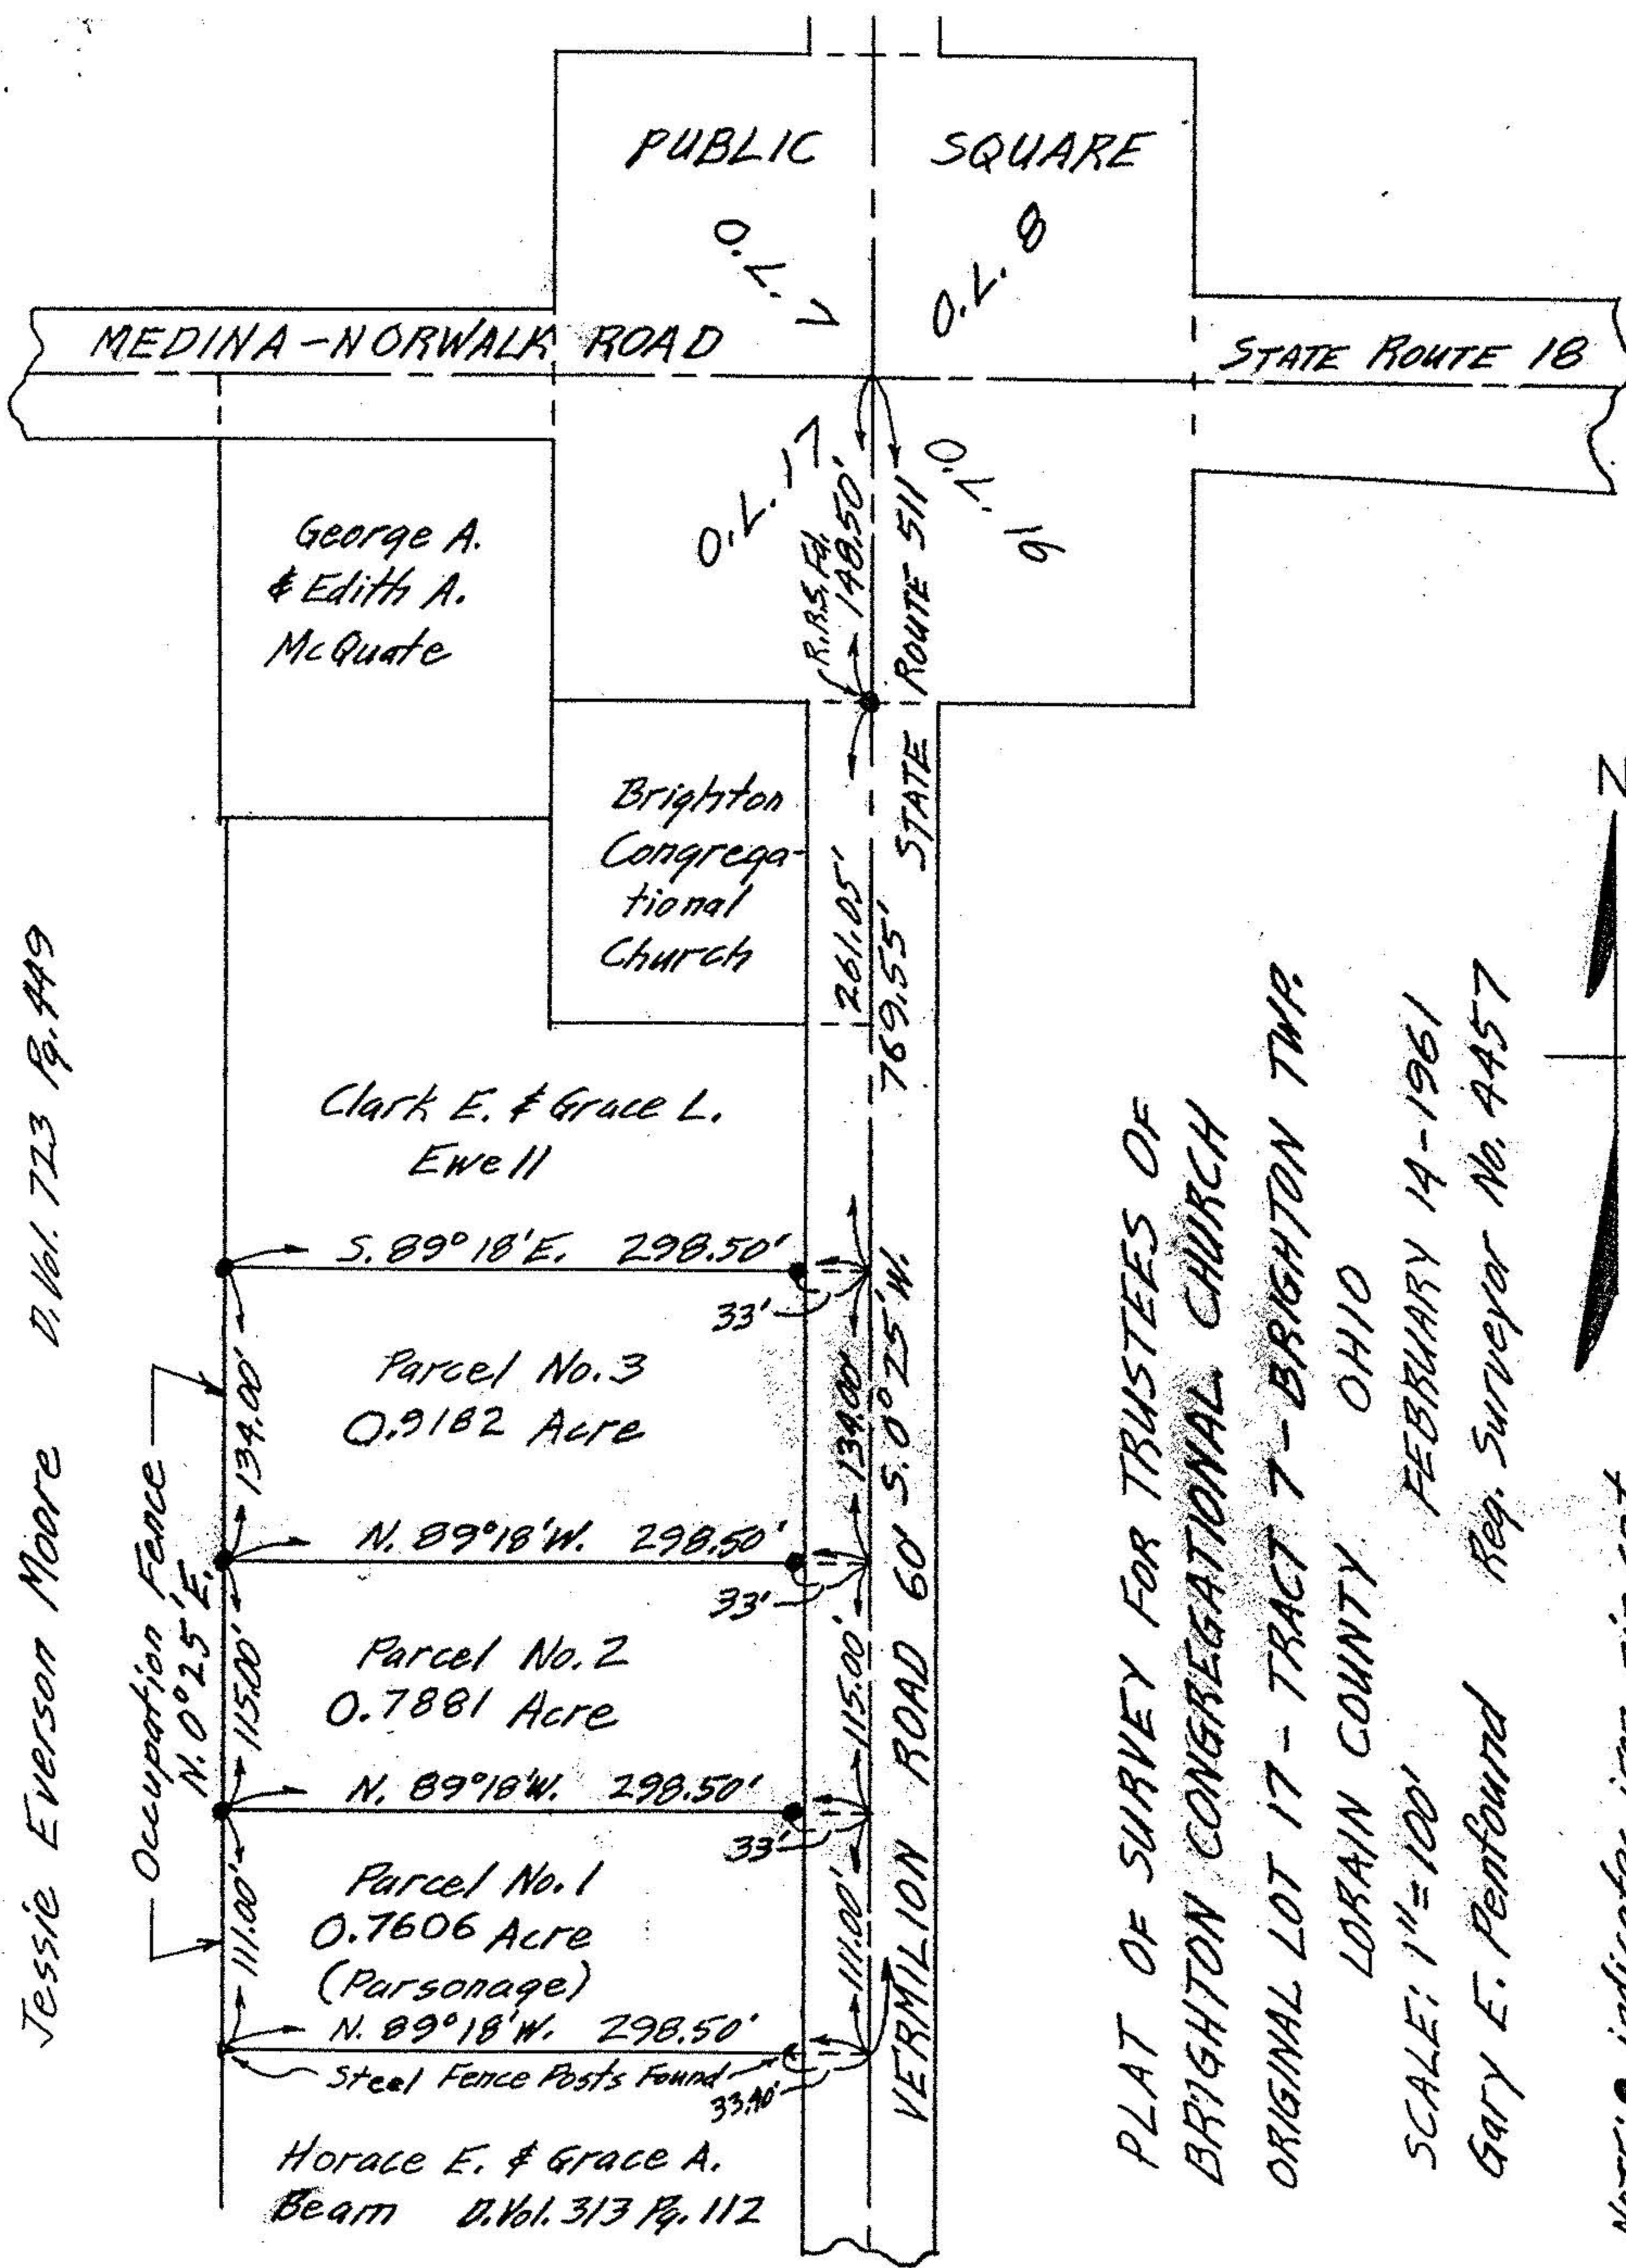

PLAT OF SURVEY FOR TRUSTEES OF
 BRIGHTON CONGREGATIONAL CHURCH
 ORIGINAL LOT 17 - TRACT 7 - BRIGHTON TWP.
 LORAIN COUNTY OHIO
 SCALE: 1"=100'
 FEBRUARY 14-1961
 Gary E. Penfound Reg. Surveyor No. 4457



NOTE: ● indicates iron pin set
 unless otherwise designated.