


327-1833

327-1033

CARDINAL SURVEYS  
PLAT OF SURVEY  
PREPARED FOR BOB HOWSHOF SKY

BRIGHTON TOWNSHIP; PART OF ORIGINAL LOT NO. 20 IN  
TRACT NO. 7, H. 3429 ACRE SPLIT FROM 30 ACRE  
PARCEL PER DEED, RECORDED IN VOL. 1350 PG. 488, 25,6571 REMAINDER

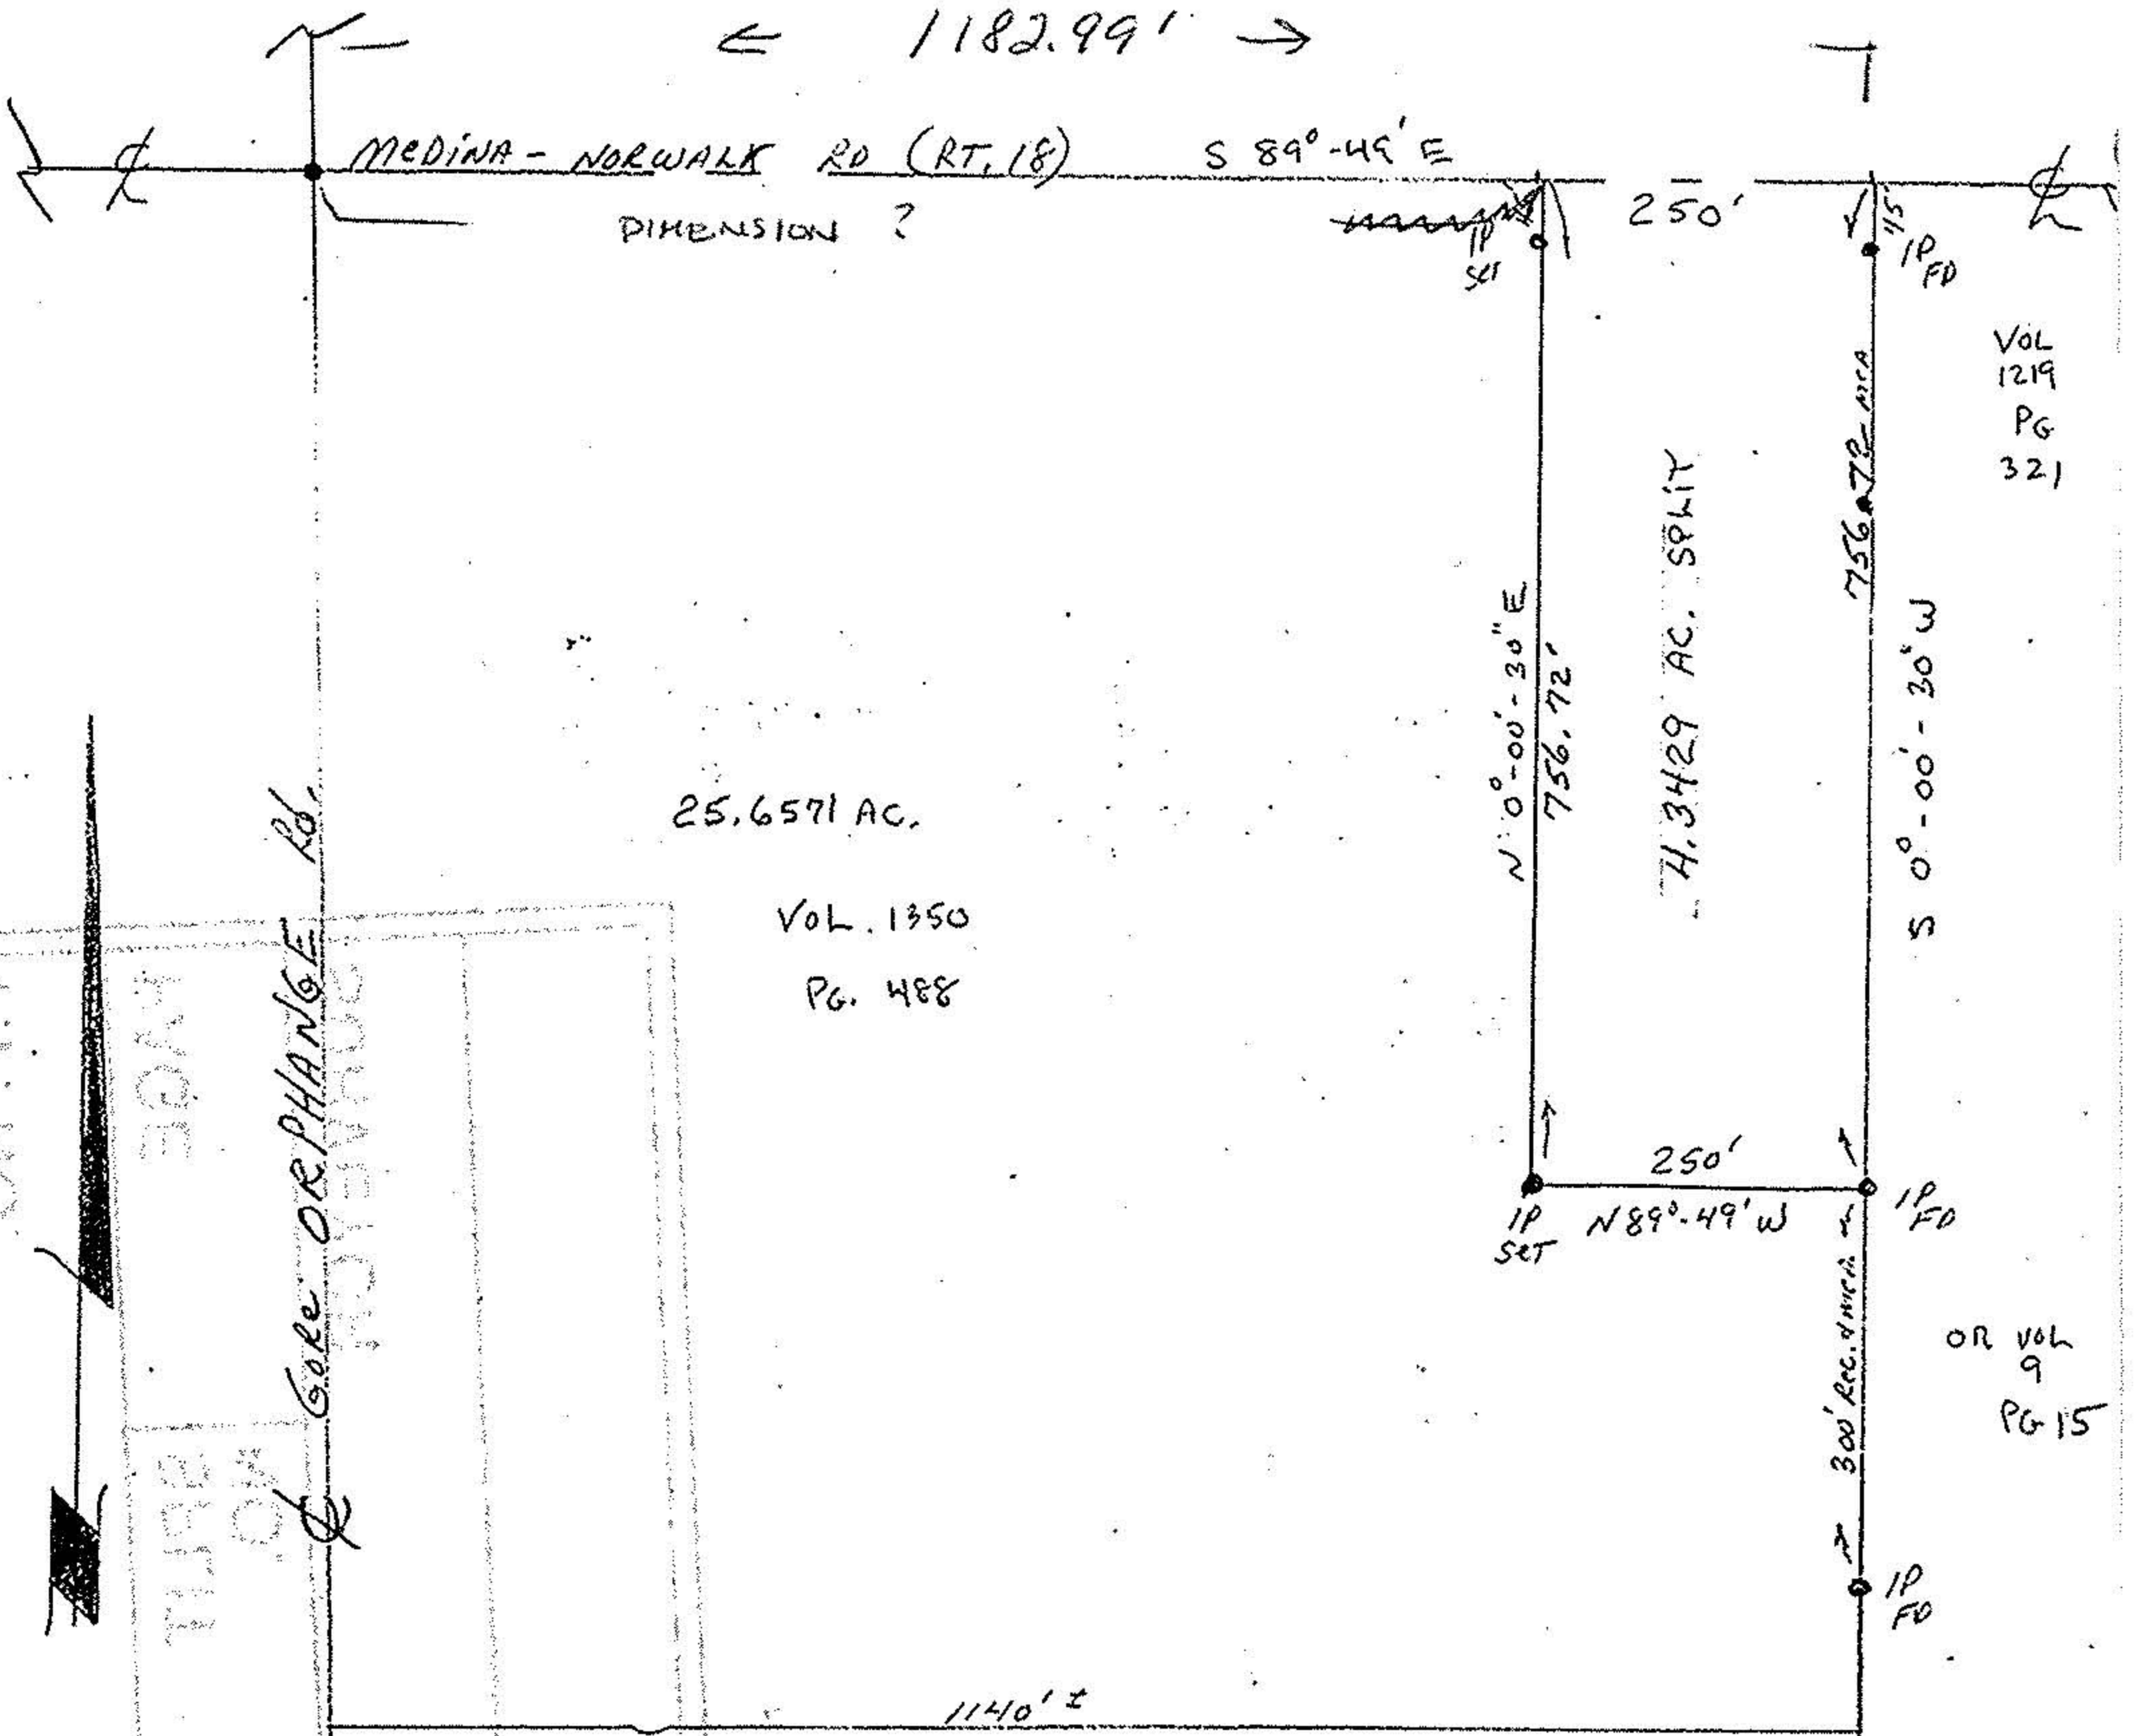

#19269

APPROVED  
ORAIN CO.  
MAP DEPT.

DATE 1-30-91

PAGE 17-E  
BY CAROLYN  
FRANCIS

VOID # 19269

ARTER

DATE: OCT. 28, 1990

SCALE: 1"=200'

17-01-000-070-10-11 17-01-000-070-10-11 17-01-000-070-10-11