


17 E #19449 17-07-020-000

CARDINAL SURVEYS
PLAT OF SURVEY
PREPARED FOR BOB HOWSHOFSKY

BRIGHTON TOWNSHIP; PART OF ORIGINAL LOT NO. 20 IN
TRACT NO. 7 2.3320 ACRE SPLIT FROM 25.6571 ACRE
PARCEL PER DEED, RECORDED IN VOL. 1350 PG. 488. 23.3251 REMAINDER

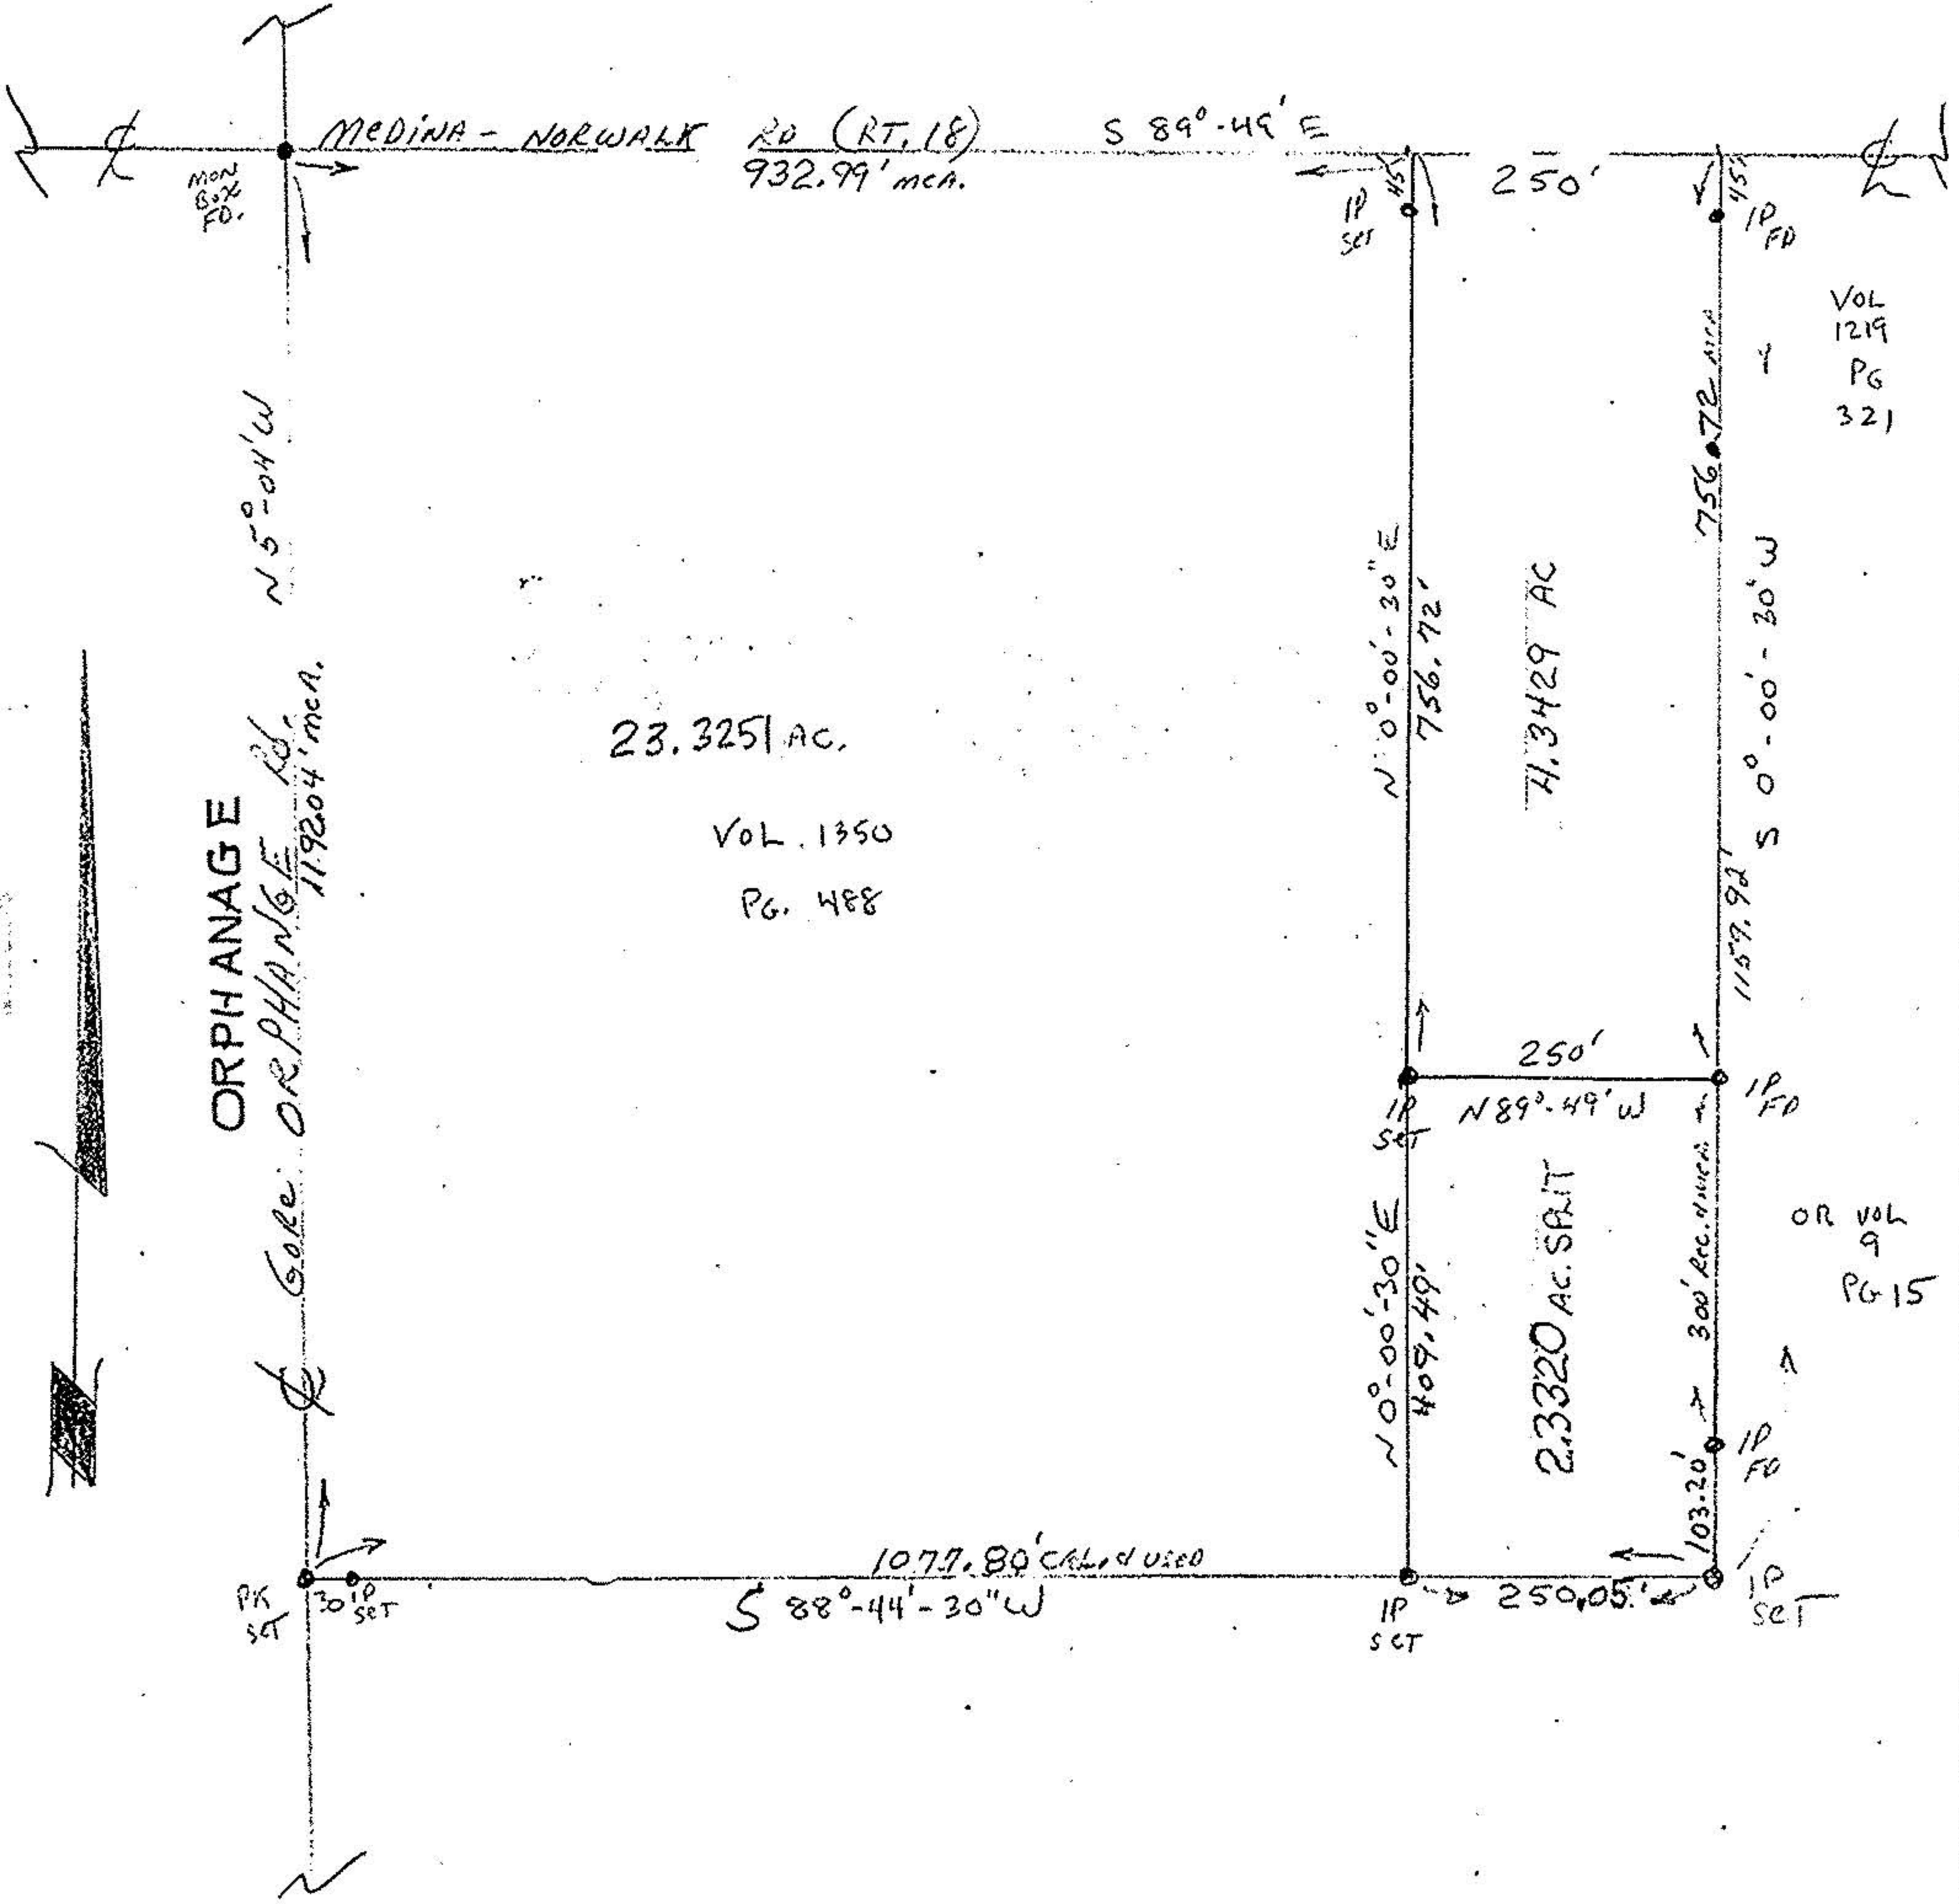

DATE: FEB. 6, 1991

SCALE: 1" = 200'