MAP OF SURVEY, LOT SPLIT AND ASSEMBLY

PREPARED FOR

HARRISON C. AND MARJORIE A. TRIPP

SITUATED IN THE TOWNSHIP OF BRIGHTON, COUNTY OF LORAIN AND THE TOWNSHIP OF CLARKSFIELD, COUNTY OF HURON IN THE STATE OF OHIO AND BEING KNOWN AS PART OF ORIGINAL LOT 5 OF THE FIRST SECTION IN SAID CLARKSFIELD TOWNSHIP AND PART OF ORIGINAL LOT 17 IN THE 'GORE STRIP' IN SAID BRIGHTON TOWNSHIP

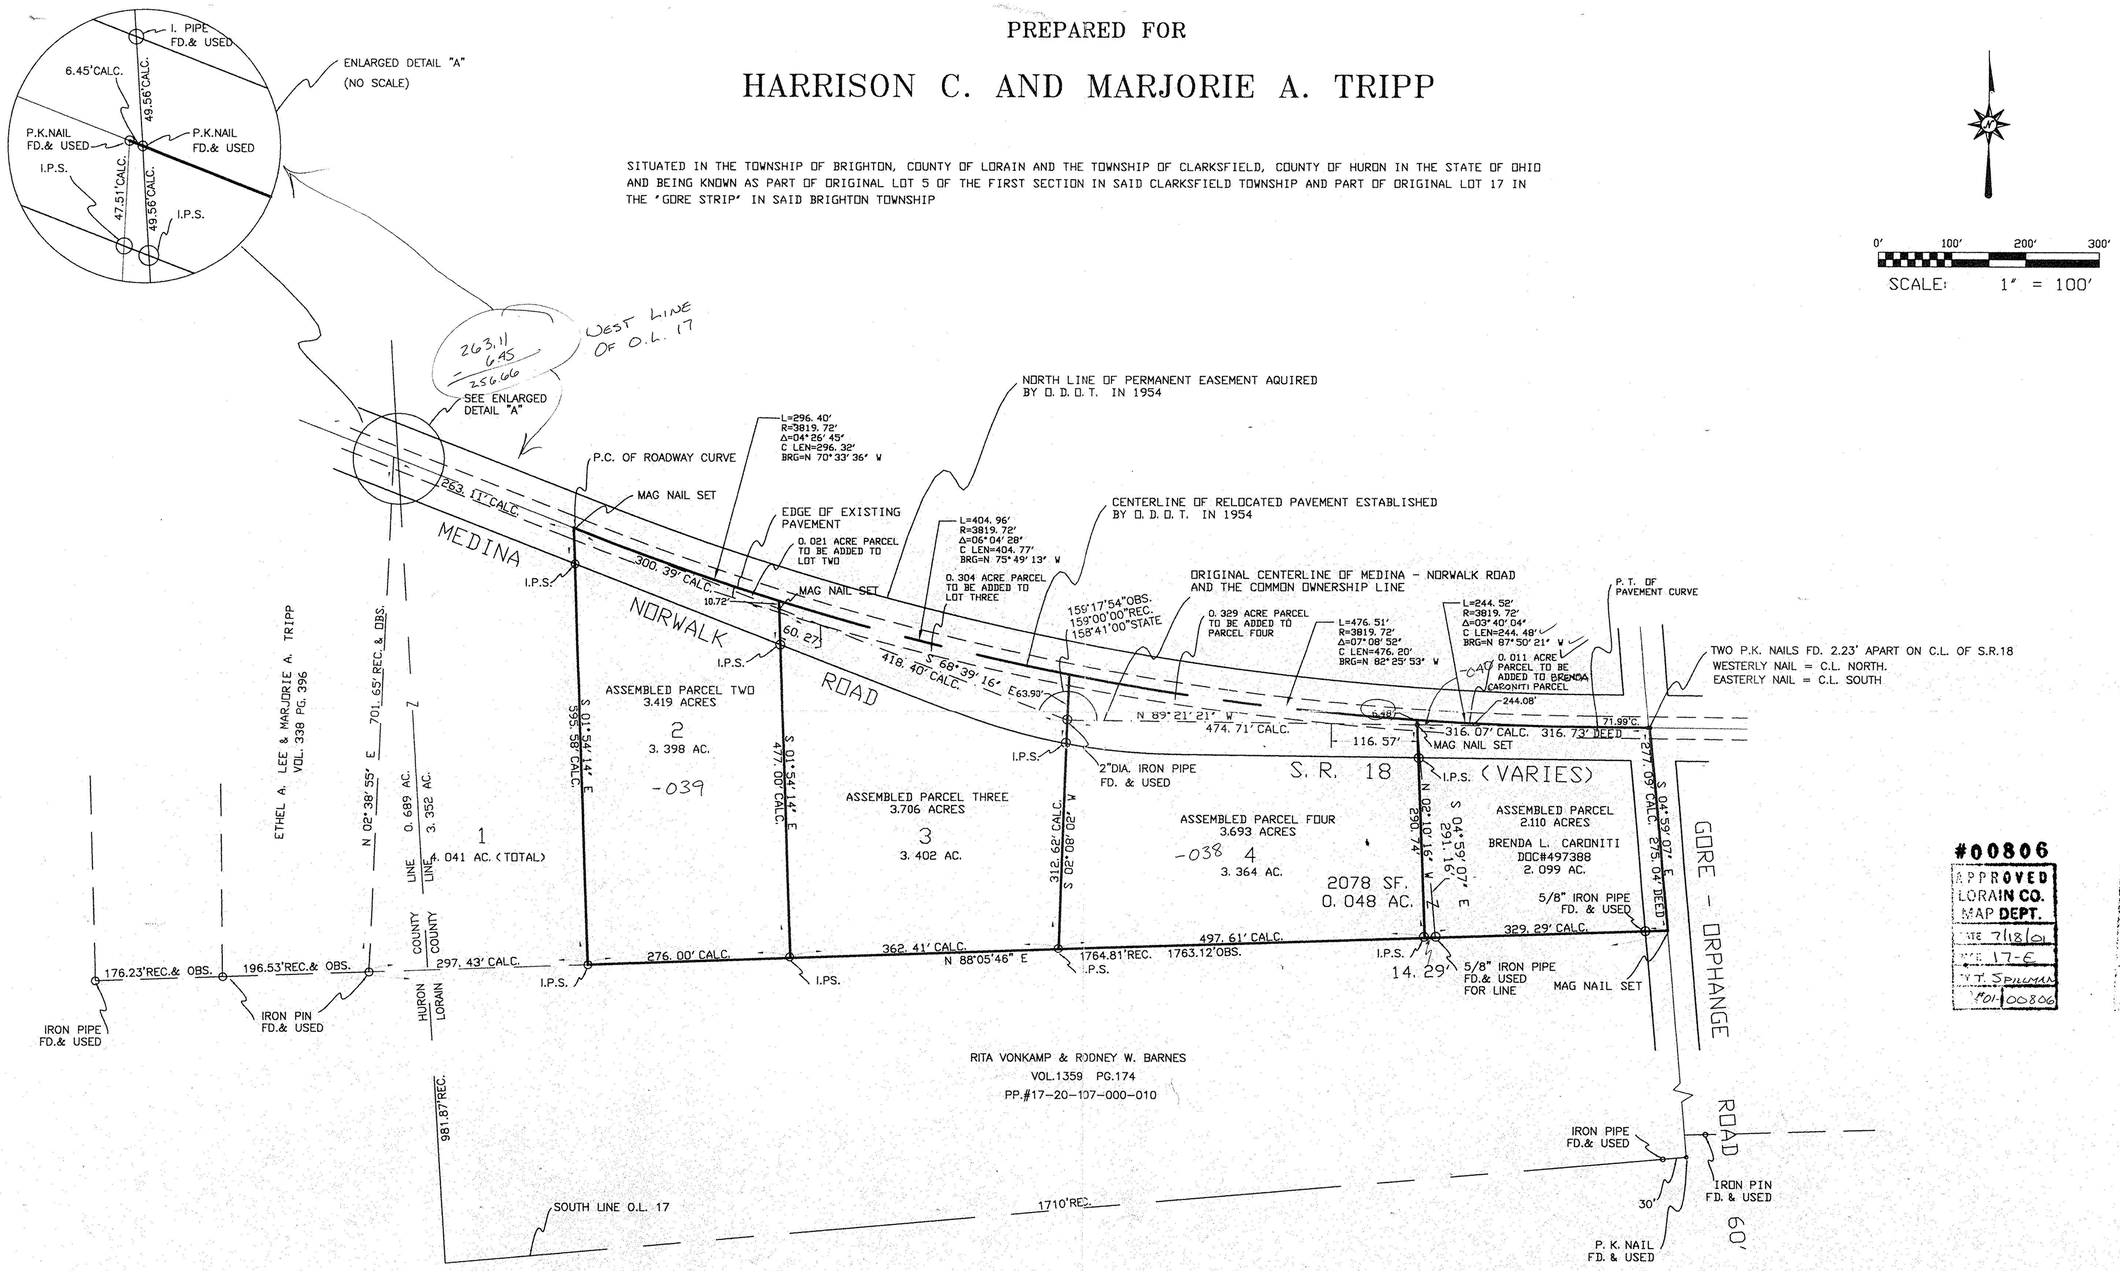

#00806
APPROVED
LORAIN CO.
MAP DEPT.
DATE 7/18/01
PAR. 17-E
BY T. SPILMAN
#01-00806

#00750
APPROVED
LORAIN CO.
MAP DEPT.
DATE 3/28/02
PAR. 17-E
BY T. SPILMAN
#01-00750

SURVEYOR'S STATEMENT

DISTANCES ARE EXPRESSED IN FEET AND DECIMAL PARTS THEREOF. BEARINGS ARE TO AN ASSUMED MERIDIAN AND ARE USED TO INDICATE ANGLES ONLY. PERMANENT MONUMENTS WERE FOUND OR SET AS INDICATED HEREON. —o— I. P. S. INDICATES A 5/8' DIAMETER IRON PIN WITH CAP SET. ALL OF WHICH I DECLARE TO BE CORRECT TO THE BEST OF MY ABILITIES AND BELIEF.

STATE OF OHIO THOMAS M. SNEZEK S-7051 SURVEYOR

Thomas M. Snezek — 3-08-01

THOMAS M. SNEZEK, REGISERED OHIO SURVEYOR NO. 7051 — DATE

REVISED - 3/5/01
9706 - 6/28/97