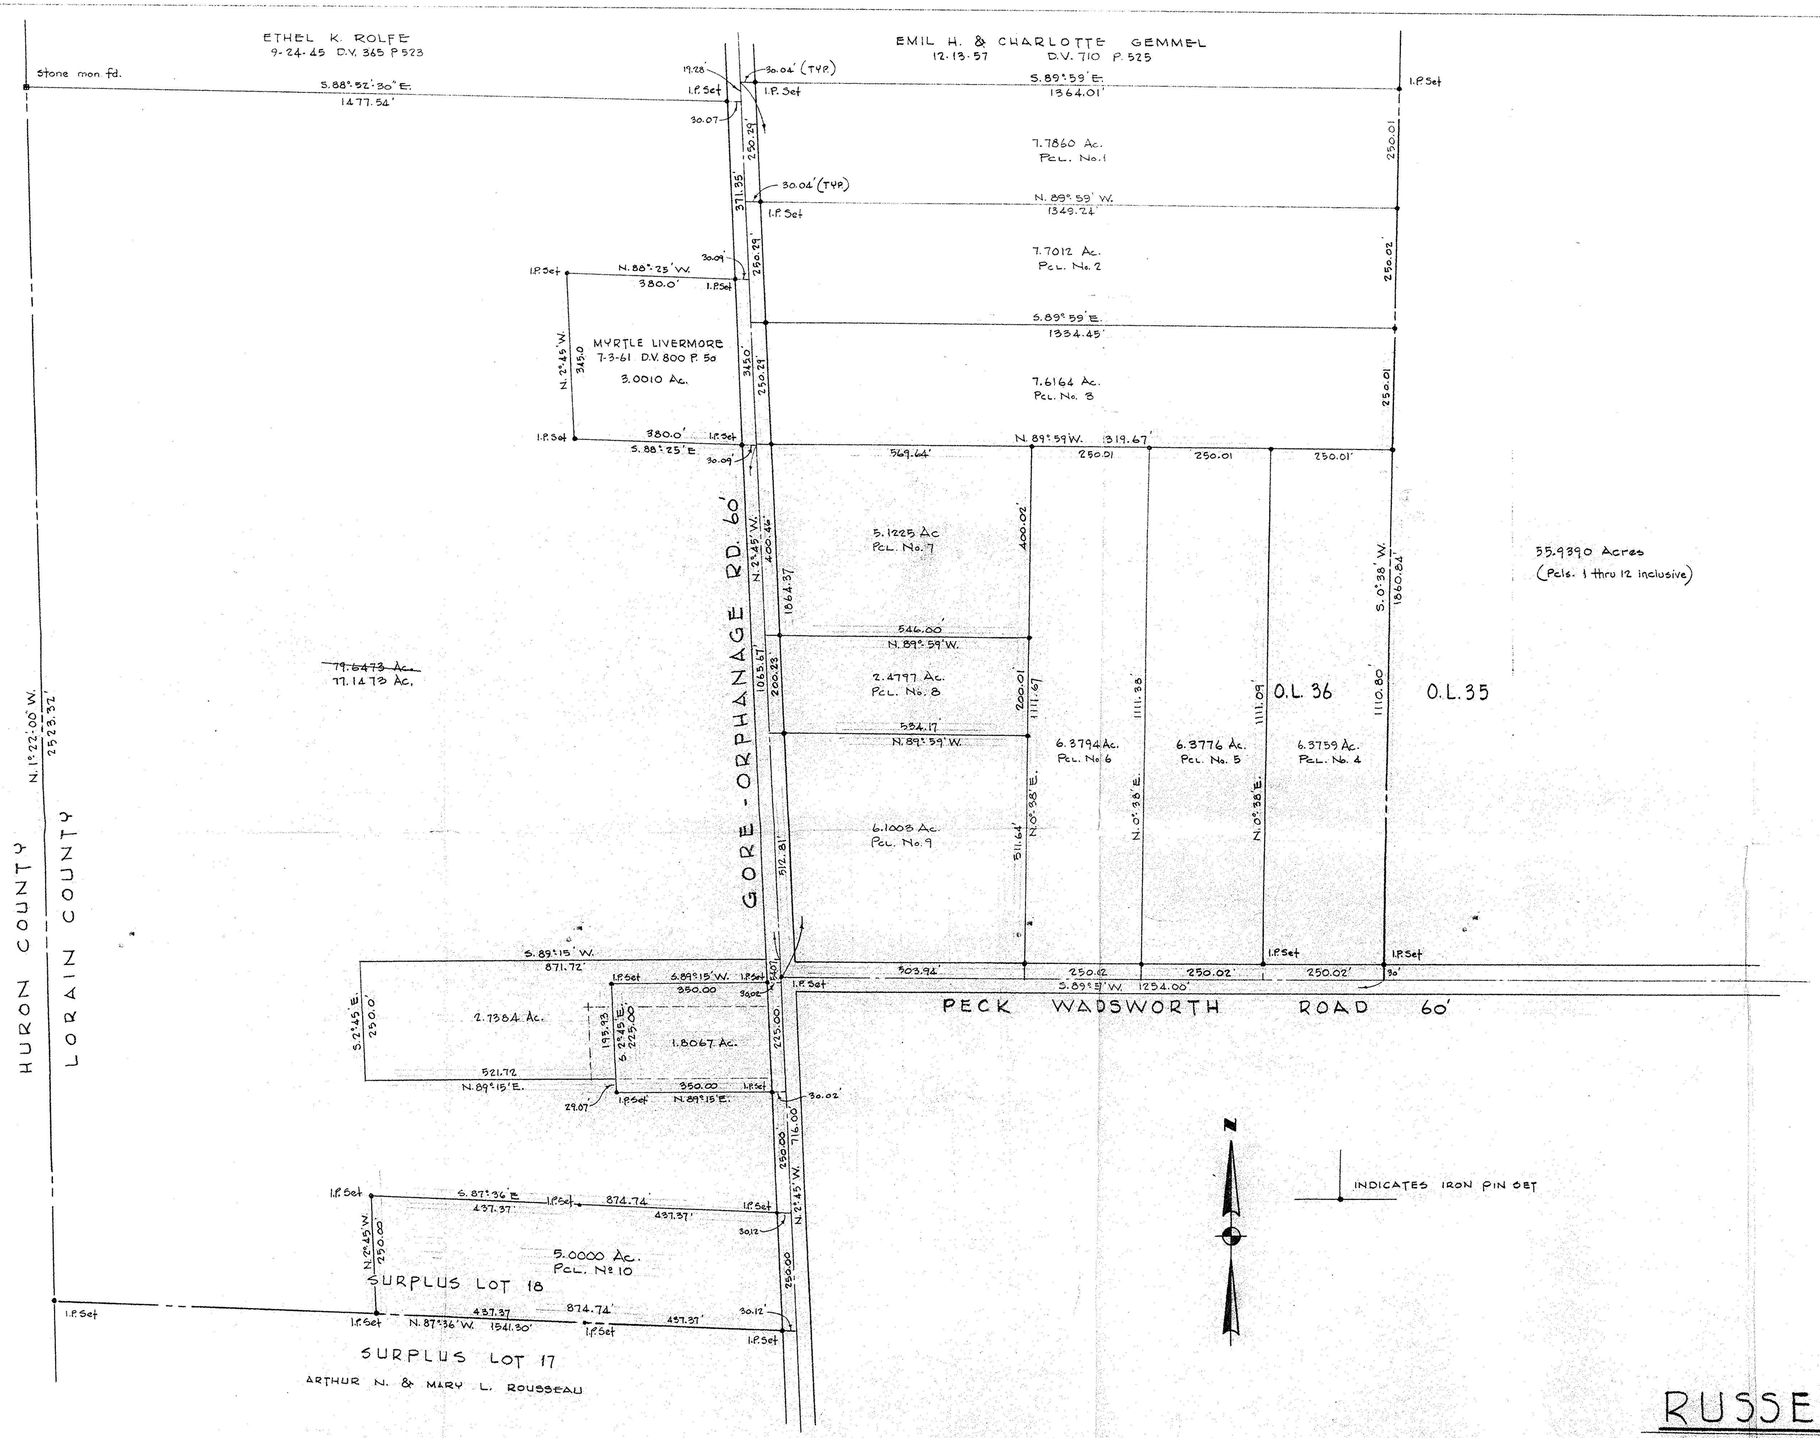


SURVEY FOR

# RUSSEL L. SWORD

PART OF SURPLUS LOT 18 OF THE GORE STRIP AND ORIG. LOT 36
BRIGHTON TWP. LORAIN COUNTY OHIO
SCALE 1" = 150' JULY, 1978

LAUNDON · SIMON · CAHL & ASSOC.
ENGINEERS SURVEYORS

Job No. 76-549 F.B. 180 P. 51 OCT. '78
Job No. 78-769 F.B. 180 P. 60 JULY '78
Job No. 79-924 No Field Book OCT. '79

STATE OF OHIO
RODGER G. SIMON
5101
REGISTERED SURVEYOR

#19485

APPROVED
LORAIN CO.
MAP DEPT.
DATE 8-2-91
PAGE 17-A
BY T. McMan
ADD AFTER 19485

REVISED 11-22-78 ADDN. of Pcls. 2,3,5,6,7,8,9,10,11 & 12 R.G.S.
REVISED 10-15-79 HEGMAN PCL. (79-924)
REVISED 5-16-88 Deletion of Pcls. 7 thru 12 Add Pcls. 7, 8 & 9 R.G.S.
REVISED 6-19-91 Made Pcl. 10 5.00 Ac. R.G.S.
REVISED 5-16-88 ADDN. of PCL. No 10 R.G.S