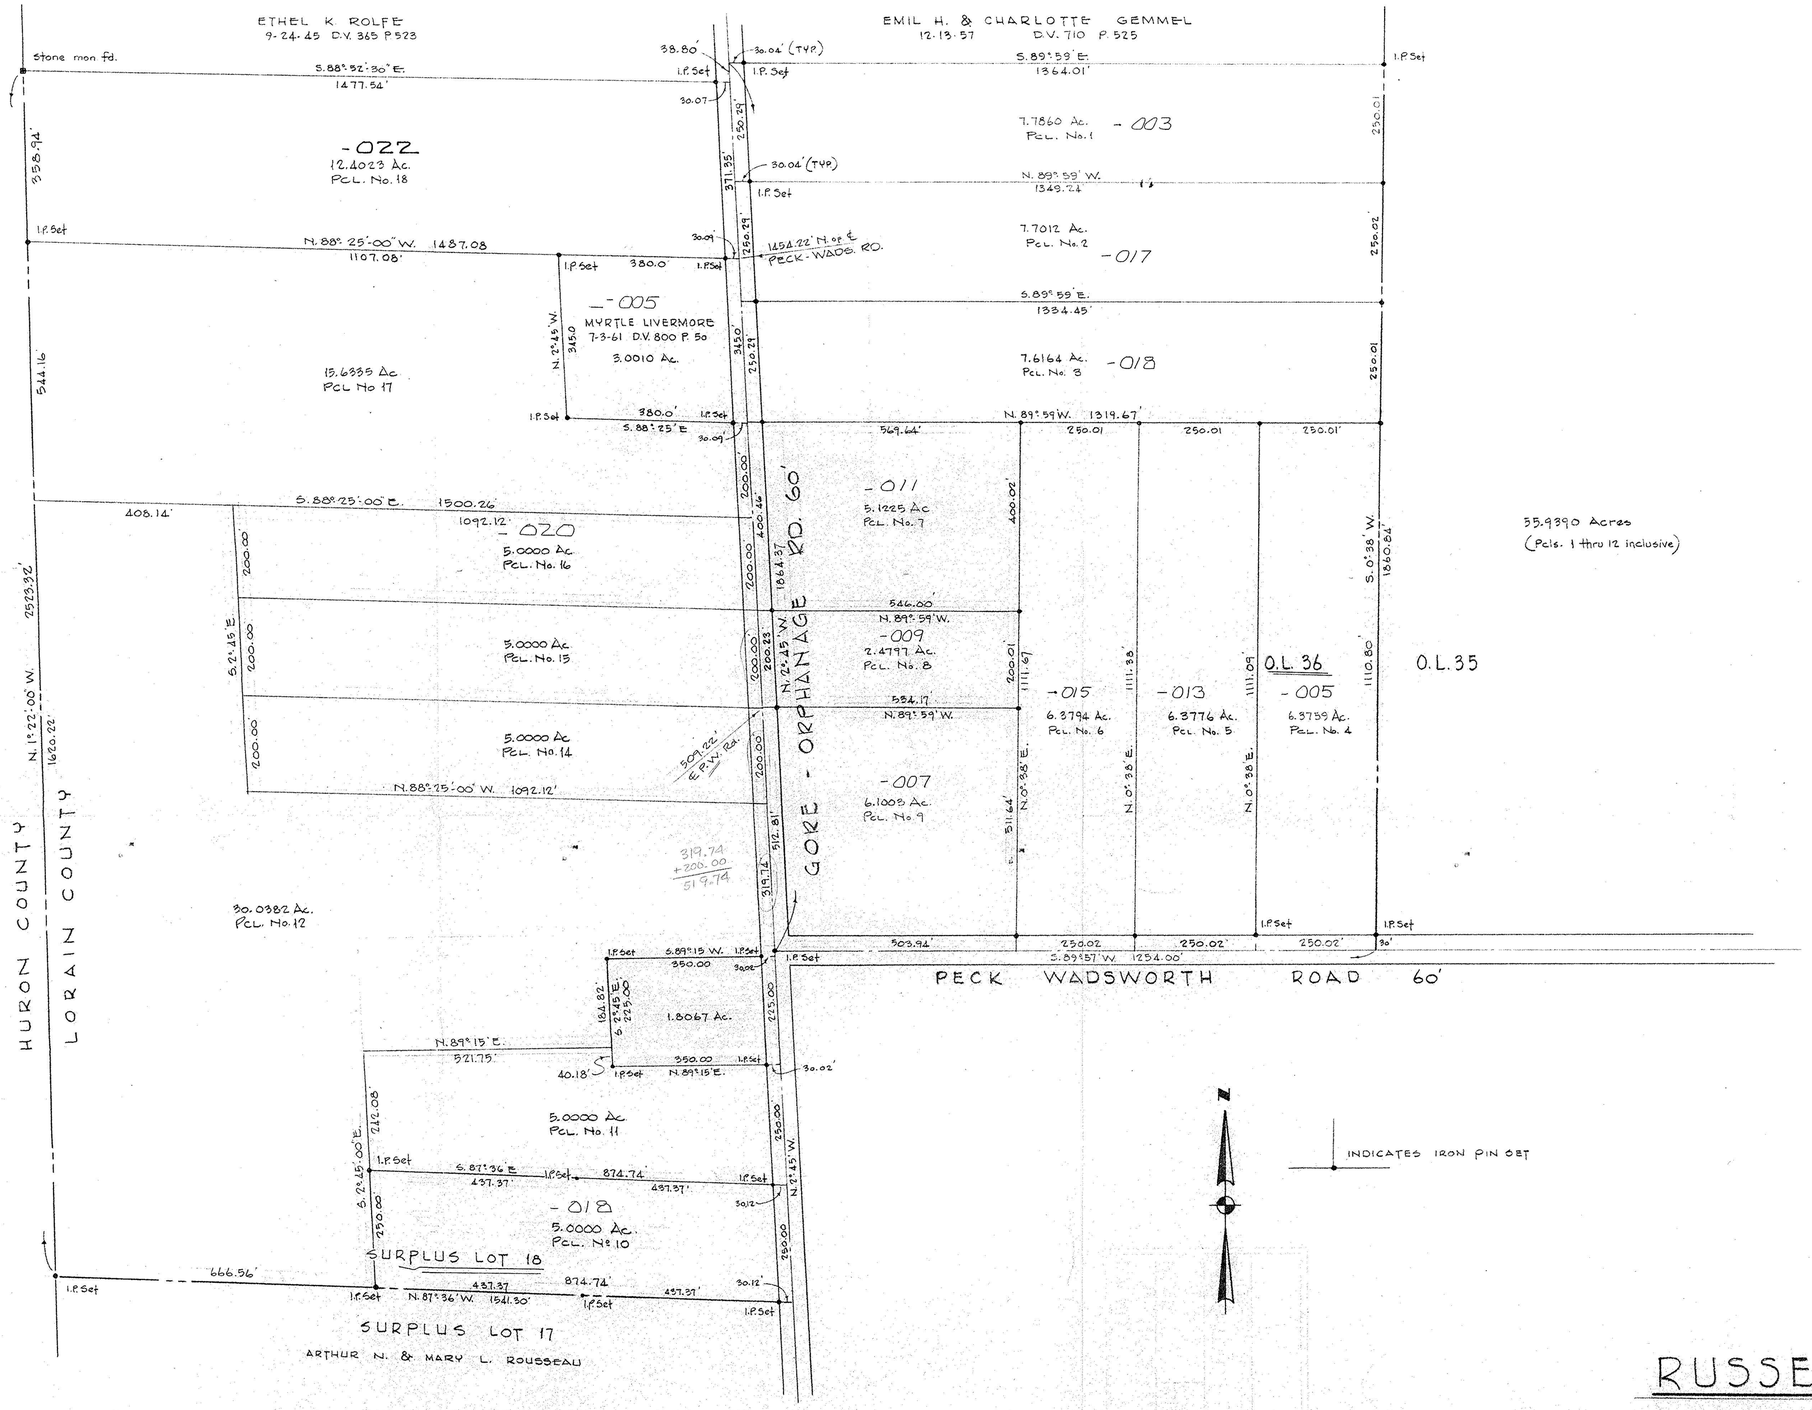

17-20-018-000-

20558

APPROVED LORAIN CO. MAP DEPT.	
DATE	1-5-93
PAGE	17-A
BY	CAROLYN FRANCIS
VOID AFTER #	20552A

SURVEY FOR

RUSSEL L. SWORD

PART OF SURPLUS LOT 18 OF THE GORE STRIP AND ORIG. LOT 36

BRIGHTON TWP. LORAIN COUNTY OHIO

SCALE 1" = 150' JULY, 1978

STATE OF OHIO
RODGER G. SIMON
5101
REGISTERED SURVEYOR

LAUNDON · SIMON · CAHL & ASSOC.
ENGINEERS SURVEYORS

Job No. 76-549 F.B. 180 P. 51 Oct. '78
Job No. 78-769 F.B. 180 P. 60 July '78
Job No. 79-924 No Field Book Oct. '79

REVISED 11-22-78 ADDN. of Pcls 2,3,5,6,7,8,9,10,11 & 12 R.G.S.
REVISED 10-15-79 HEGMAN PCL. (79-924)
REVISED 3-10-88 Deletion of Pcls 1 thru 12. Add Pcls. 7, & 49 R.G.S.

THIS IS THE COPY TO WORK FROM
PER R. SIMON 6/21/94 OTHER COPY WITH DIFFERENT DIMENSIONS WAS SUBMITTED THEN TAKEN BACK AFTER R. SIMON PROVIDED THIS COPY.

REVISED 7/1993 Add Pcls. 12-17 Chg. Pcl. 11
REVISED 7-29-91 Add Pcl. 11 R.G.S.
REVISED 6-19-91 Made Pcl. 10 5.00 Ac. R.G.S.
REVISED 5-16-88 ADDN. of PCL. No 10 R.G.S.