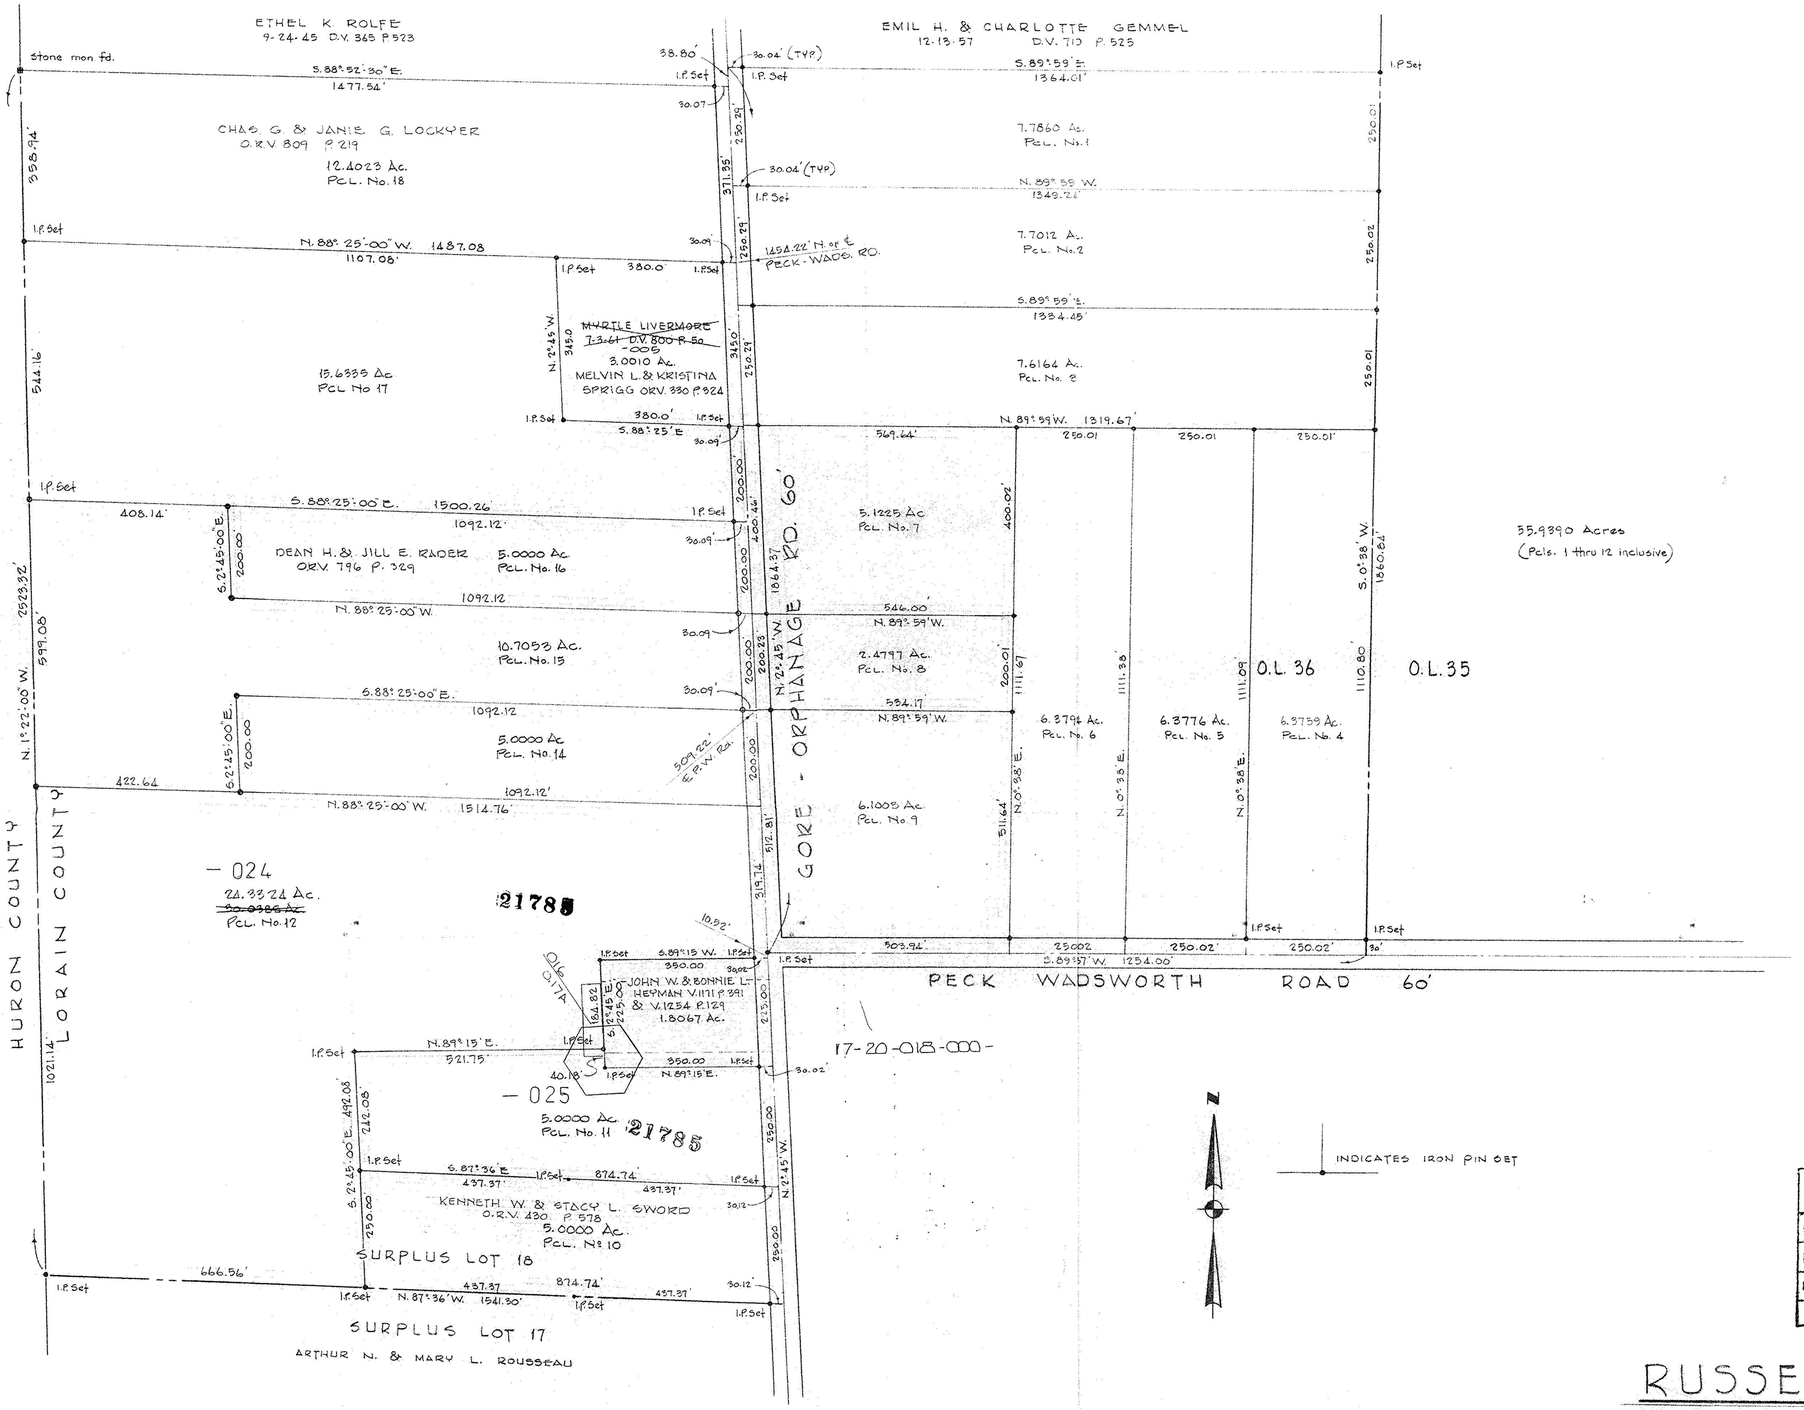

55.9390 Acres
(Pcls. 1 thru 12 inclusive)

21785

APPROVED LORAIN CO. MAP DEPT
DATE 6-4-96
PAGE 17-A
BY CAROLYN FRANCIS
#21785

STATE OF OHIO
RODGER G. SIMON
5101
REGISTERED SURVEYOR

APR 26 1996

SURVEY FOR

RUSSEL L. SWORD

PART OF SURPLUS LOT 18 OF THE GORE STRIP AND ORIG. LOT 36
BRIGHTON TWP. LORAIN COUNTY OHIO
SCALE 1" = 150' JULY, 1978

LAUNDON · SIMON · CAHL & ASSOC.
ENGINEERS SURVEYORS

Job No. 76-549 F.B. 180 P. 51 Oct. '78
Job No. 78-769 F.B. 180 P. 60 July '78
Job No. 79-924 No Field Book Oct. '79

REVISED 11-22-78 ADDN. of Pcls. 2,3,5,6,7,8,9,10,11 & 12 R.G.S.
REVISED 10-15-79 HEGMAN Pcl. (79-924)
REVISED 3-10-88 Deletion of Pcls 7 thru 12 Add Pcls 7,8 & 9 R.G.S.

REVISED 2/15/96 Change Pcl. No. 15 to 10.7053 Ac. 95-2763
REVISED 8/1/95 Change Pcl. No. 15 to 6.50 Ac. 95-2763
REVISED 7/1993 Add Pcls. 12-17 Chg. Pcl. 11 93-2313
REVISED 7-29-91 Add Pcl. 11 R.G.S.
REVISED 6-19-91 Made Pcl. 10 5.00 Ac. R.G.S.
REVISED 5-16-88 ADDN. of Pcl. No. 10 R.G.S.