


MAP OF SURVEY AND LOT SPLIT

PREPARED FOR

BRIAN R. HONOSHOFSKY

SITUATED IN THE TOWNSHIP OF BRIGHTON, COUNTY OF LORAIN, STATE OF OHIO
AND BEING KNOWN AS PART OF ORIGINAL BRIGHTON TOWNSHIP LOT No. 20, TRACT 7

MEDINA - NORWALK ROAD S.R. 18

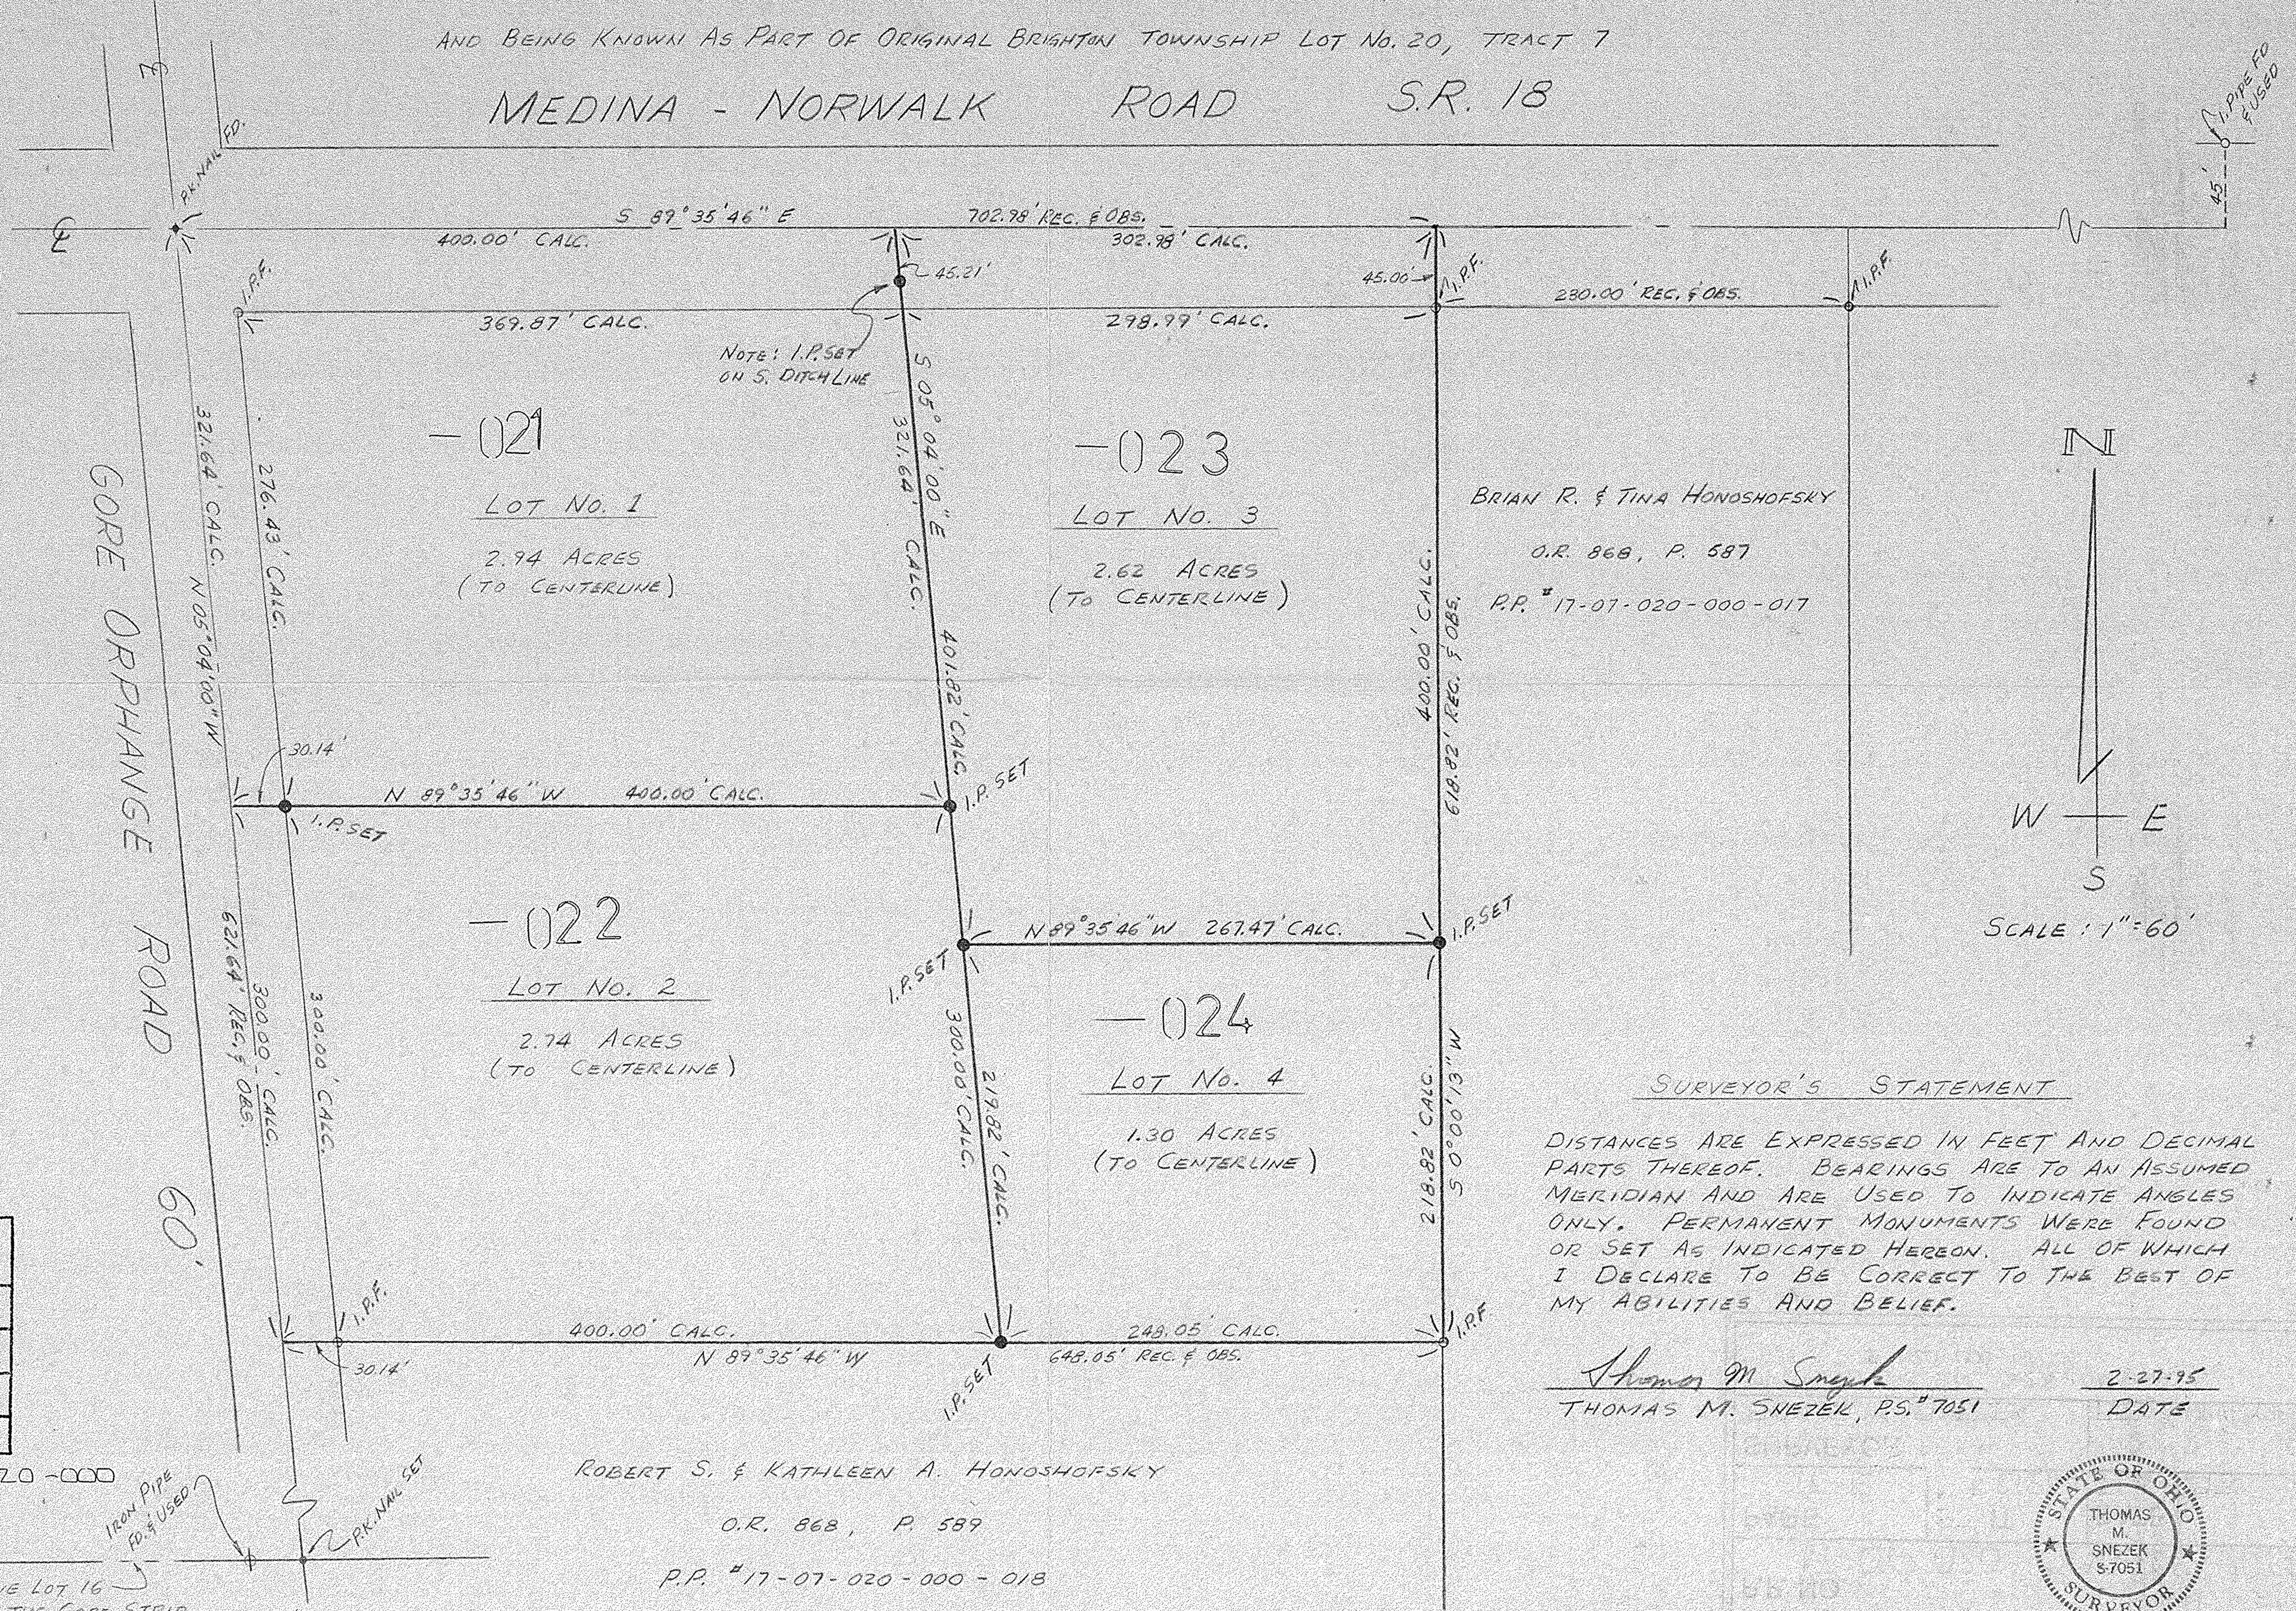

21284
APPROVED
LORAIN CO.
MAP DEPT
DATE 3-27-95
PAGE 17-E
BY CAROLYN
FRANCIS
21284

17-07-020-000

IRON PIPE
FD. USED
N. LINE LOT 16
OF THE GORE STRIP

ROBERT S. & KATHLEEN A. HONOSHOFSKY
O.R. 868, P. 589
P.P. # 17-07-020-000-018

BRIAN R. & TINA HONOSHOFSKY
O.R. 868, P. 587
P.P. # 17-07-020-000-017

SURVEYOR'S STATEMENT

DISTANCES ARE EXPRESSED IN FEET AND DECIMAL PARTS THEREOF. BEARINGS ARE TO AN ASSUMED MERIDIAN AND ARE USED TO INDICATE ANGLES ONLY. PERMANENT MONUMENTS WERE FOUND OR SET AS INDICATED HEREON. ALL OF WHICH I DECLARE TO BE CORRECT TO THE BEST OF MY ABILITIES AND BELIEF.

Thomas M. Snezek
THOMAS M. SNEZEK, P.S. # 7051

2-27-95
DATE

