


5639

17-G

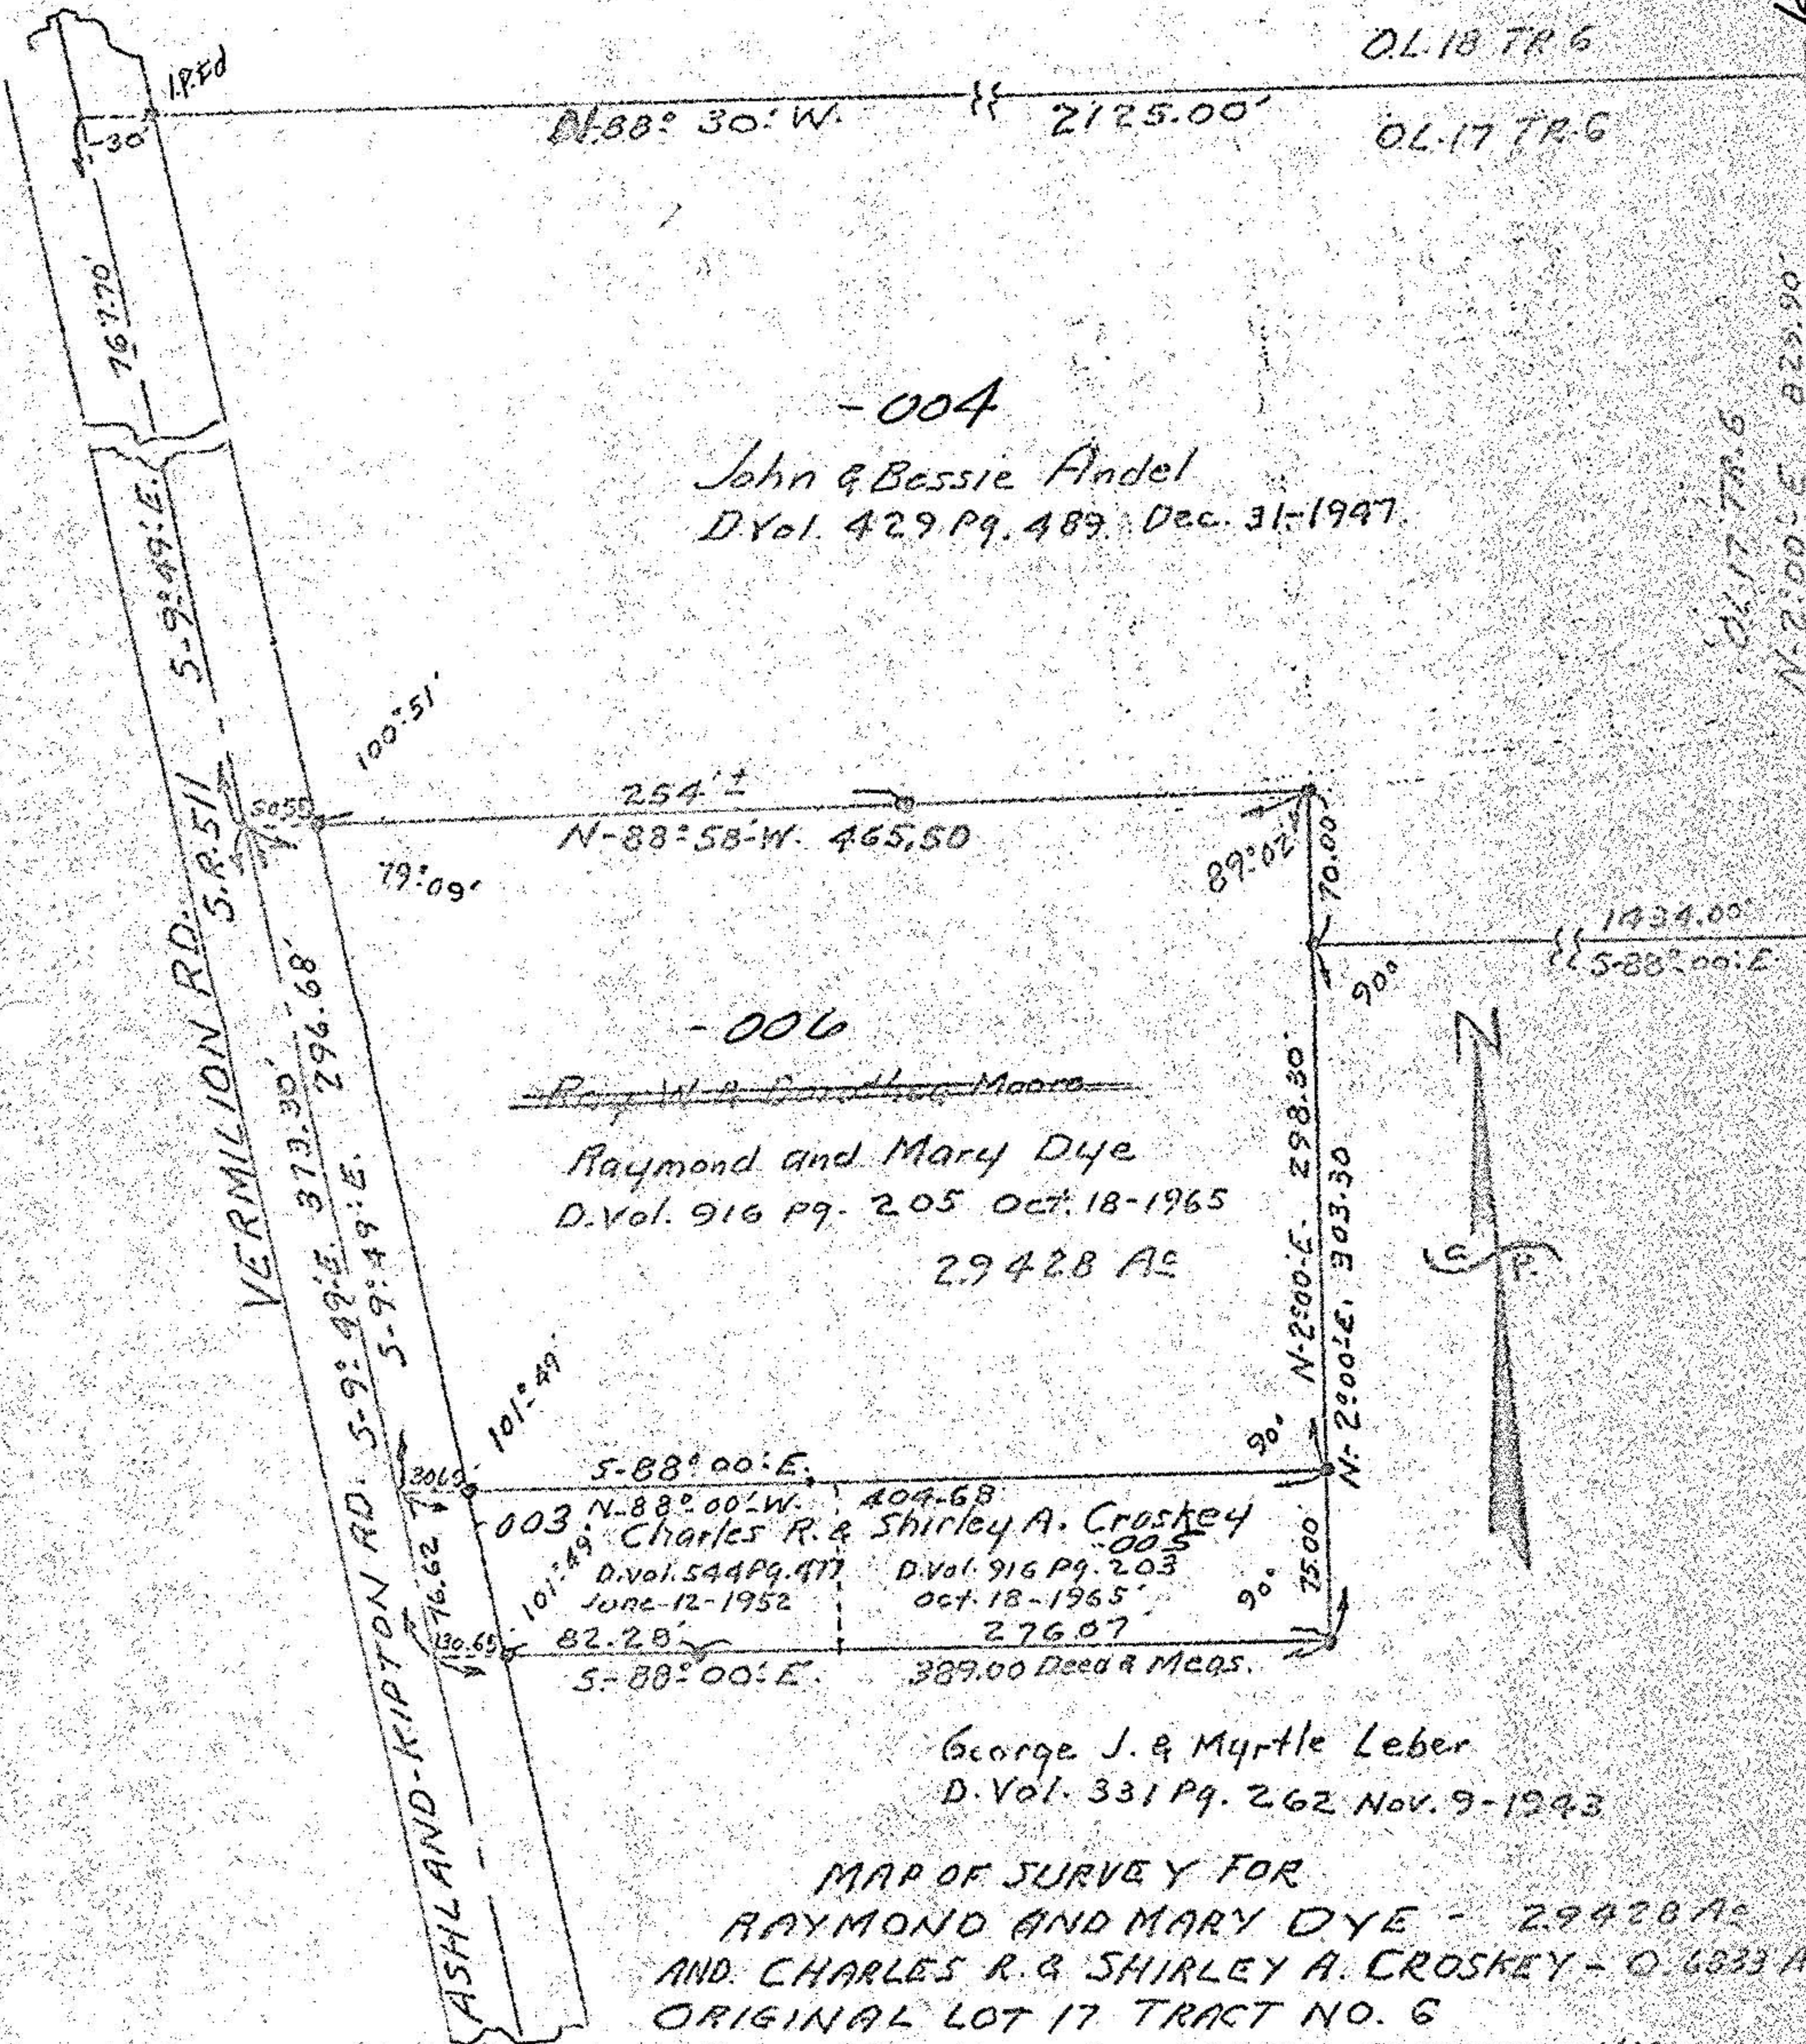

- 004

John & Bessie Andel
D. Vol. 429 Pg. 489. Dec. 31-1947.

- 006

Raymond and Mary Dye
D. Vol. 916 Pg. 205 Oct. 18-1965
29428 Ac

003
Charles R. & Shirley A. Croskey
D. Vol. 544 Pg. 477 June-12-1952
D. Vol. 916 Pg. 203 Oct. 18-1965
276.07
389.00 Deed & Meas.

George J. & Myrtle Leber
D. Vol. 331 Pg. 262 Nov. 9-1943

MAP OF SURVEY FOR
RAYMOND AND MARY DYE - 29428 Ac
AND CHARLES R. & SHIRLEY A. CROSKY - 0.6333 Ac
ORIGINAL LOT 17 TRACT NO. 6
BRIGHTON TWP. LORAIN COUNTY OHIO
SCALE 1" = 100' JUNE - 25 - 1969
C.E. Penfound Registered Surveyor No. 3200

Note: Iron pins found or set shown thus.

017 TR. 6

X 5639

17-06-017-000