SURVEY
OF PART OF
BRIGHTON TOWNSHIP
LOT NO. 19 TRACT 6
COUNTY OF LORAIN STATE OF OHIO

PREPARED BY
HAPONEK & ASSOC INC.
SURVEYORS
N RIDGEVILLE, OH

PREPARED FOR:
ZF LAND CO. LTD.
45265 GRIGGS RD
WELLINGTON, OH.
AND
RONALD JOHNSTON
50825 JONES RD
WELLINGTON, OH.

DATE: MARCH 1999
SCALE: 1" = 100'

STATE OF OHIO
DANE A. HAPONEK
S-6711
REGISTERED SURVEYOR

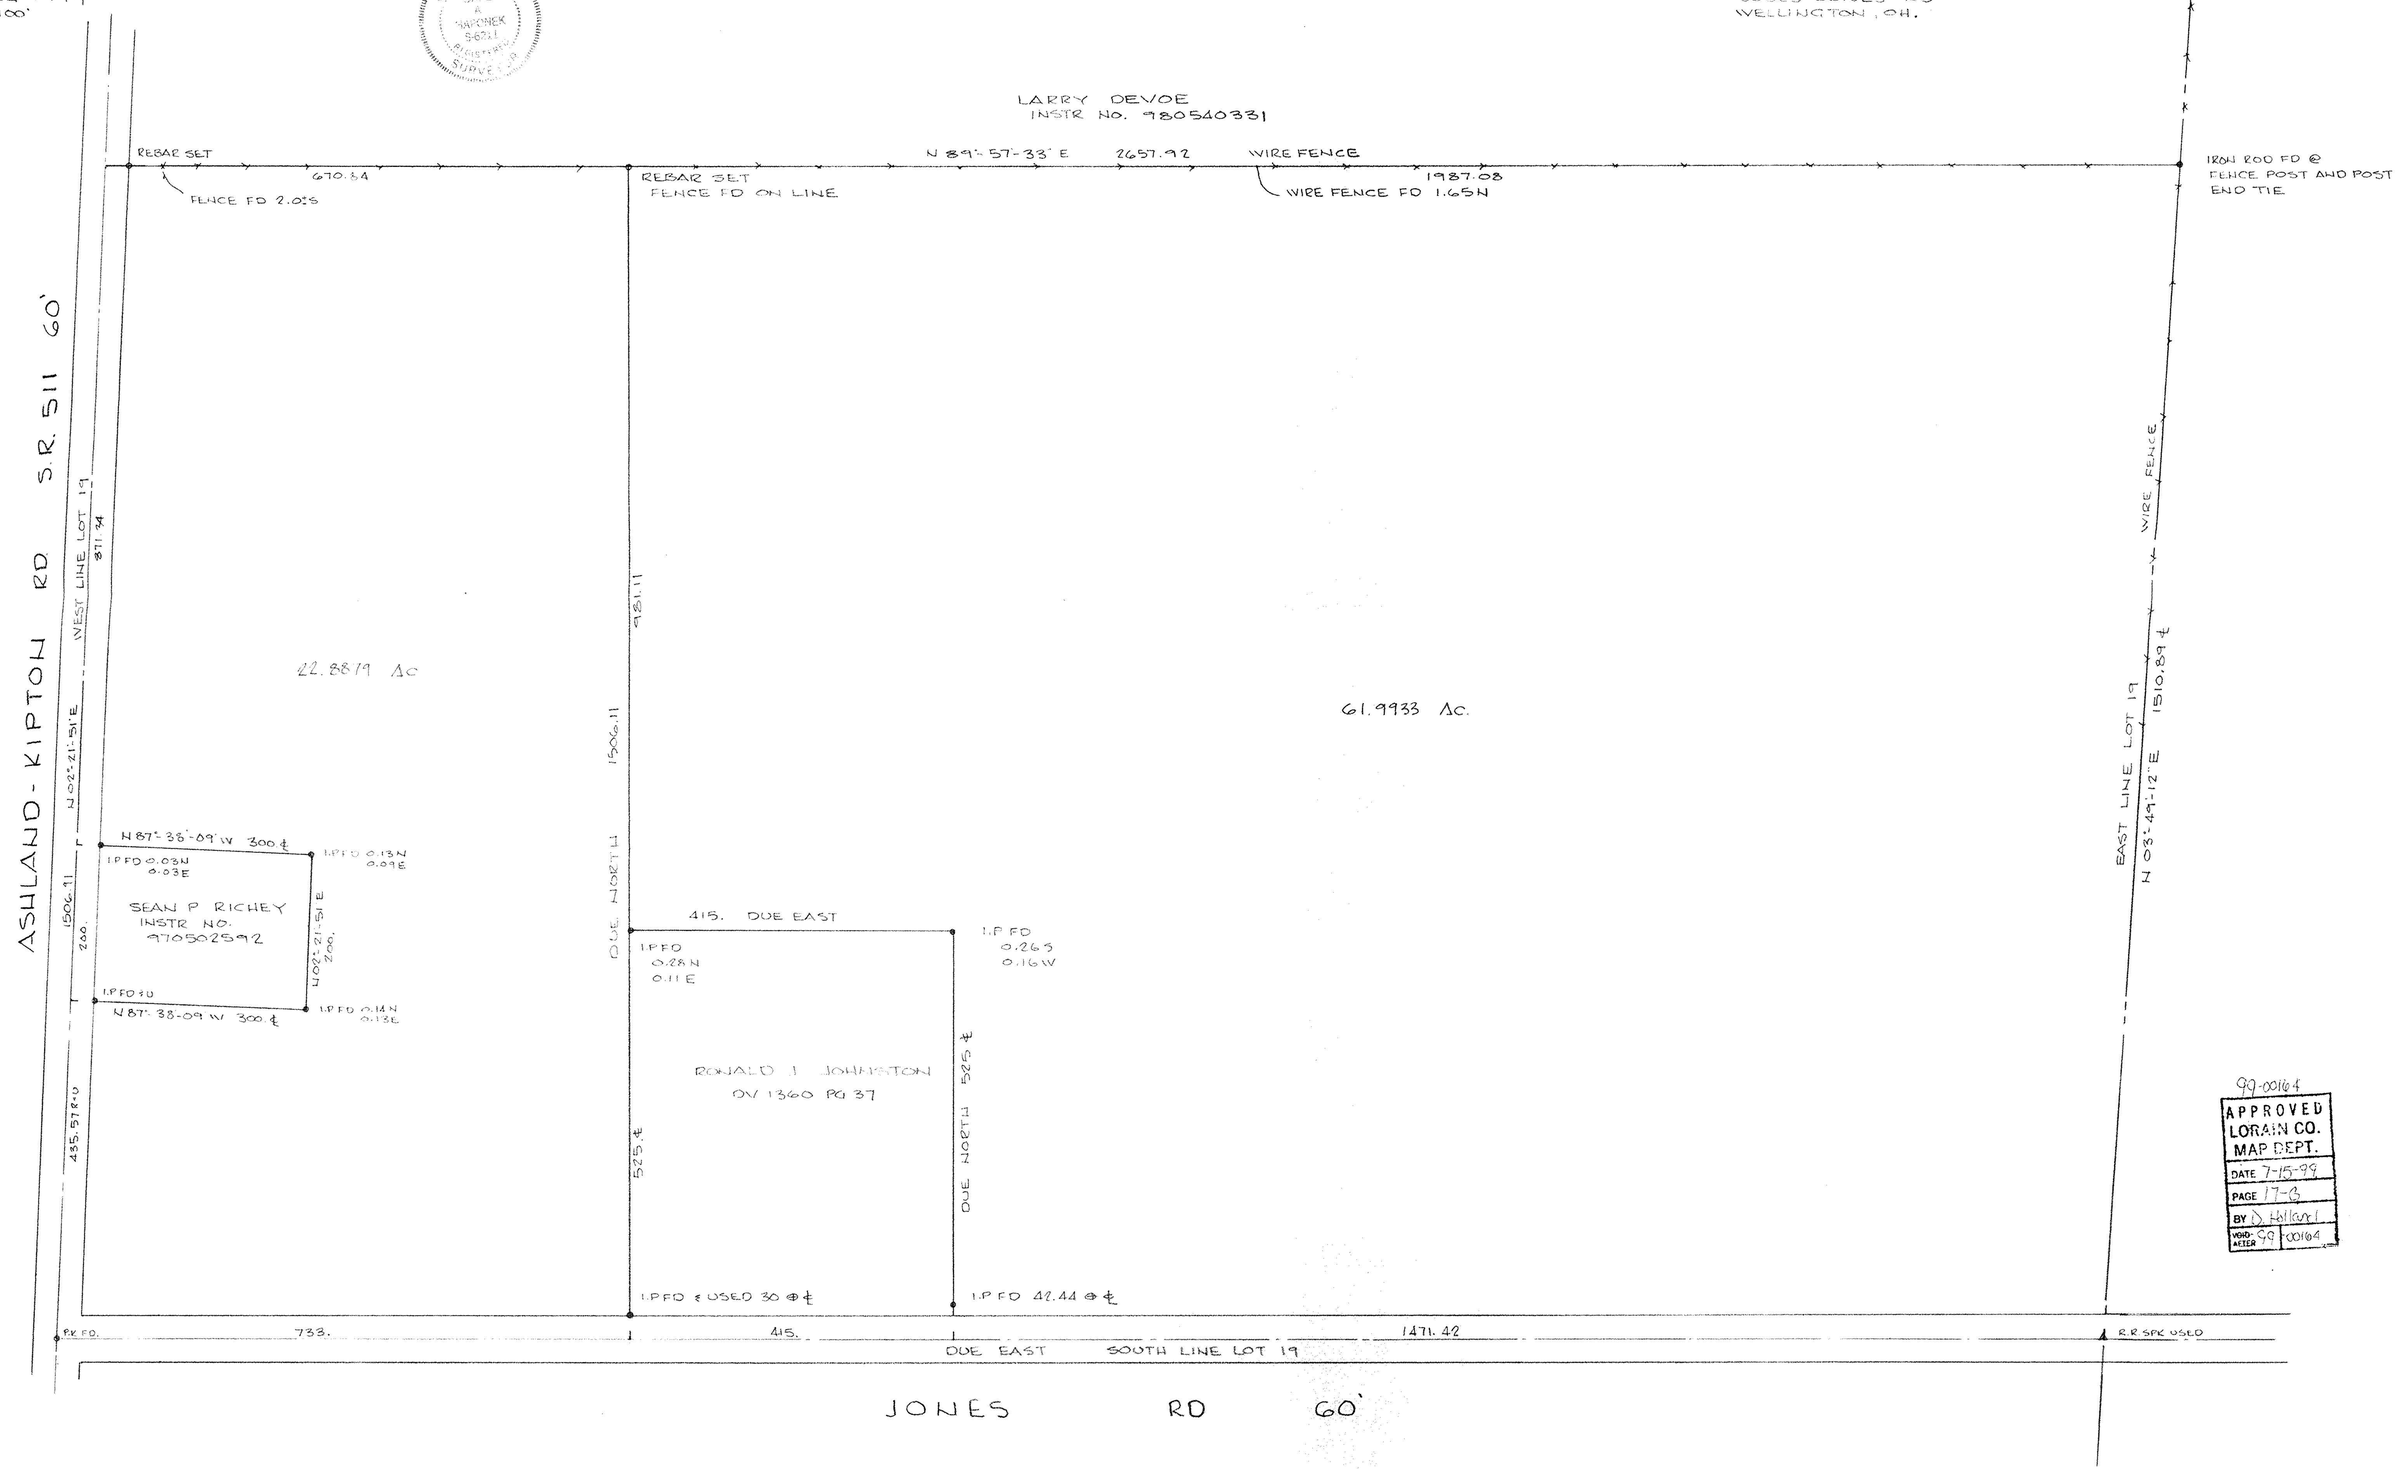

99-00164
APPROVED
LORAIN CO.
MAP DEPT.
DATE 7-15-99
PAGE 17-6
BY D Hilbert
VOID-AFTER 99-00164

99-04