17-06-032
17-H

11386
17-H
pg. 2-2-88

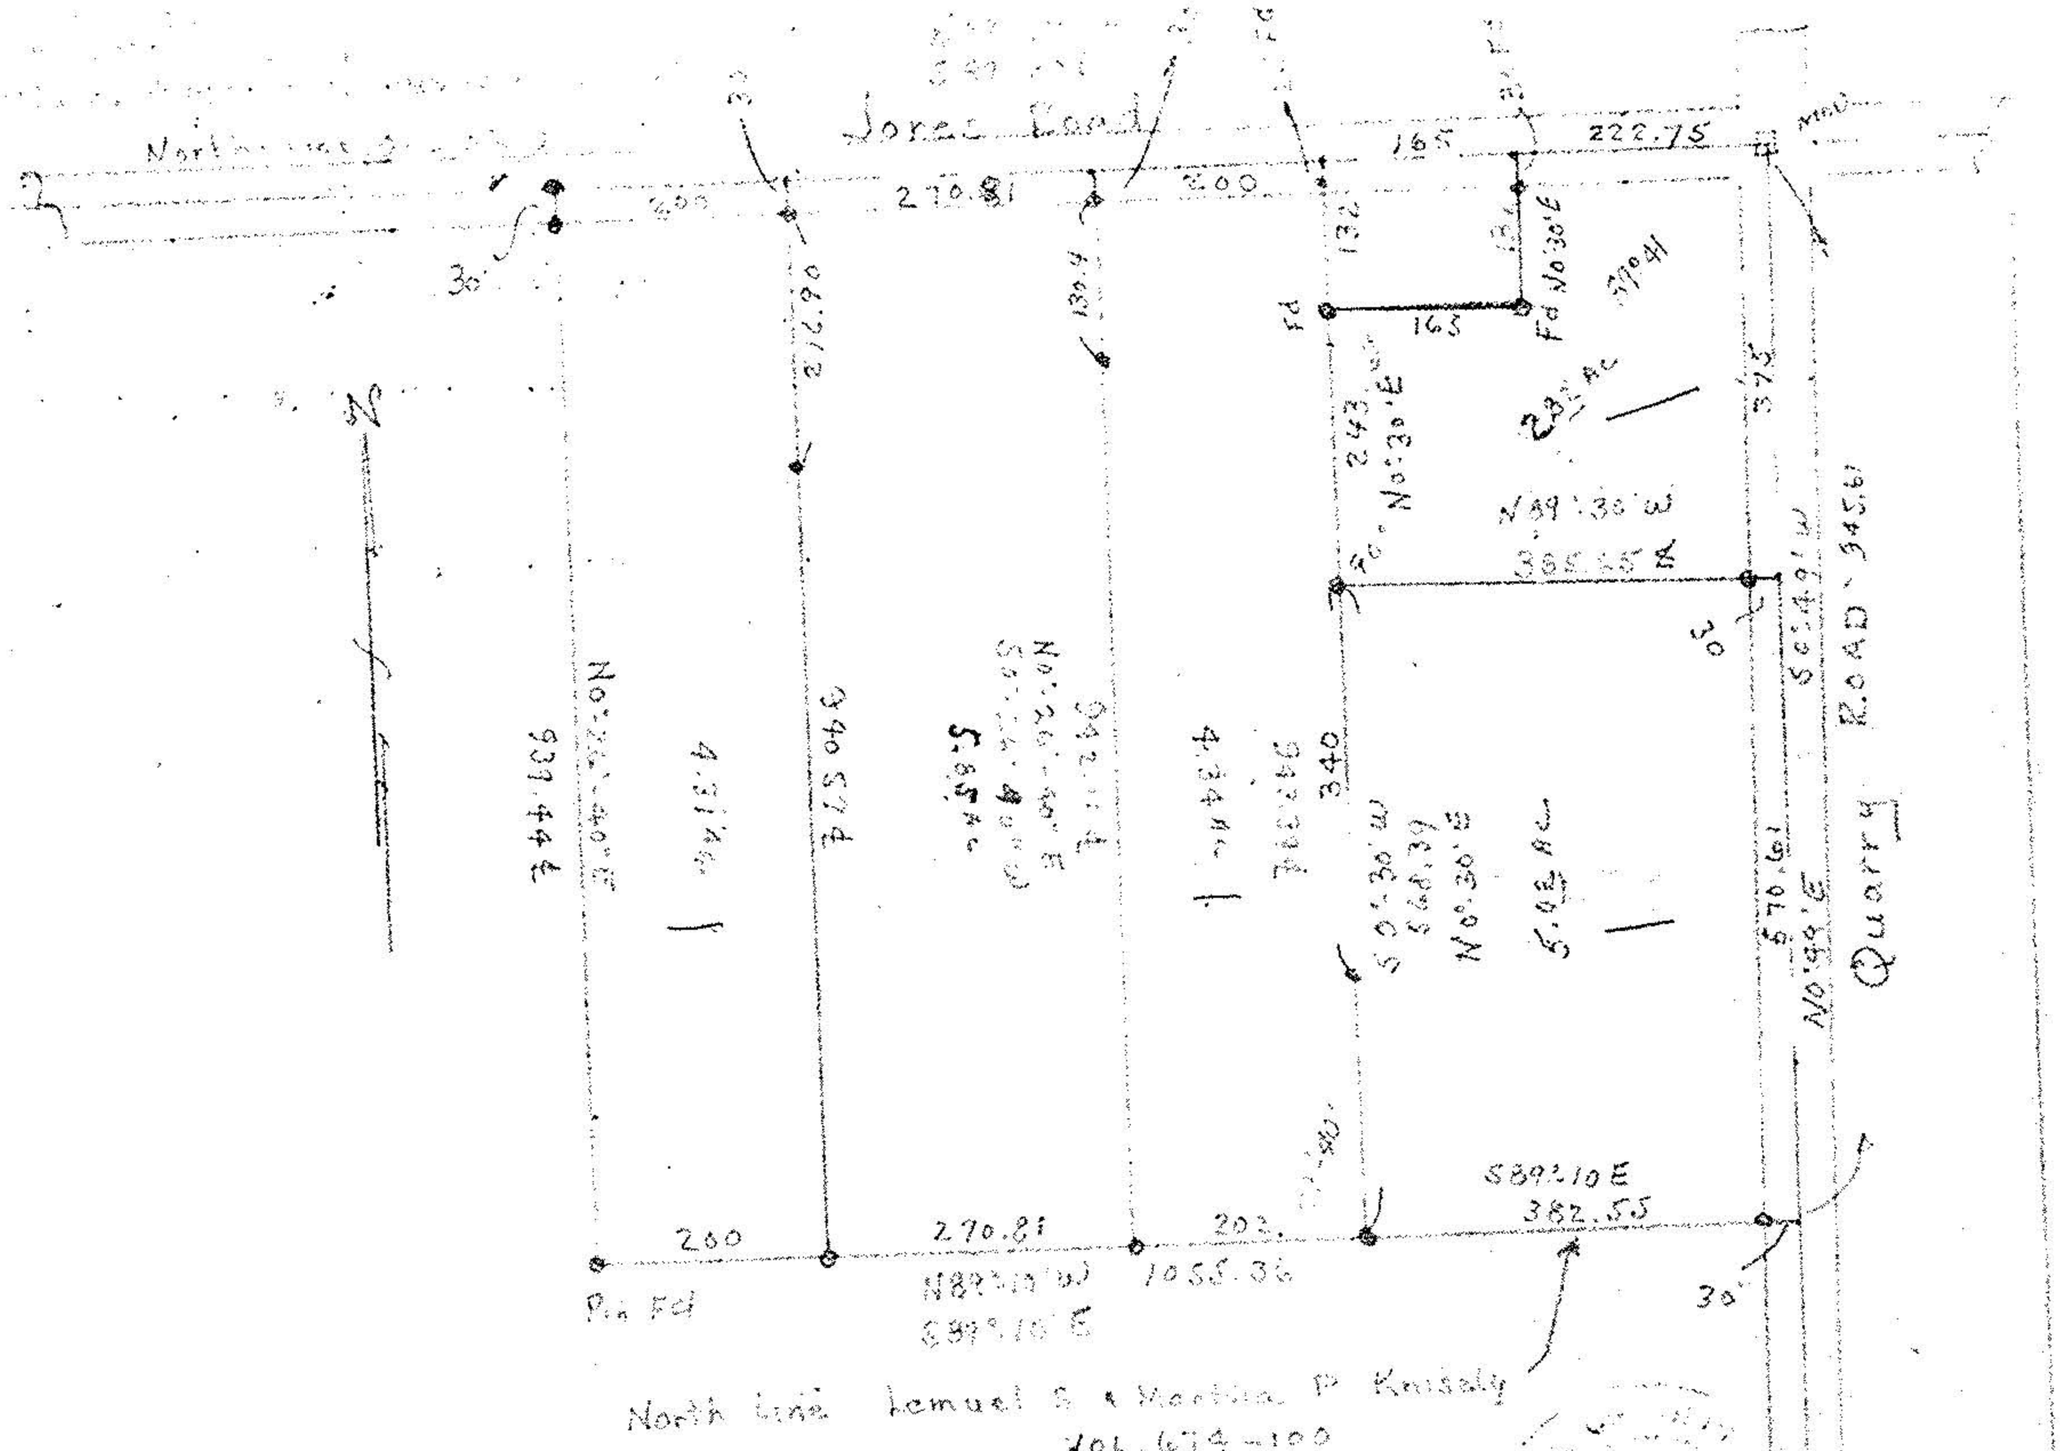

North Line Lemuel S & Martha P Knisely
Vol. 674-100