



PLAT OF SURVEY  
FOR

BETTY WAGNER

SITUATED IN THE TOWNSHIP OF WELLINGTON,  
COUNTY OF LORAIN, STATE OF OHIO, KNOWN  
AS BEING A PART OF ORIGINAL LOT NO. 1,  
TOWNSHIP 3 NORTH, RANGE 18 WEST.

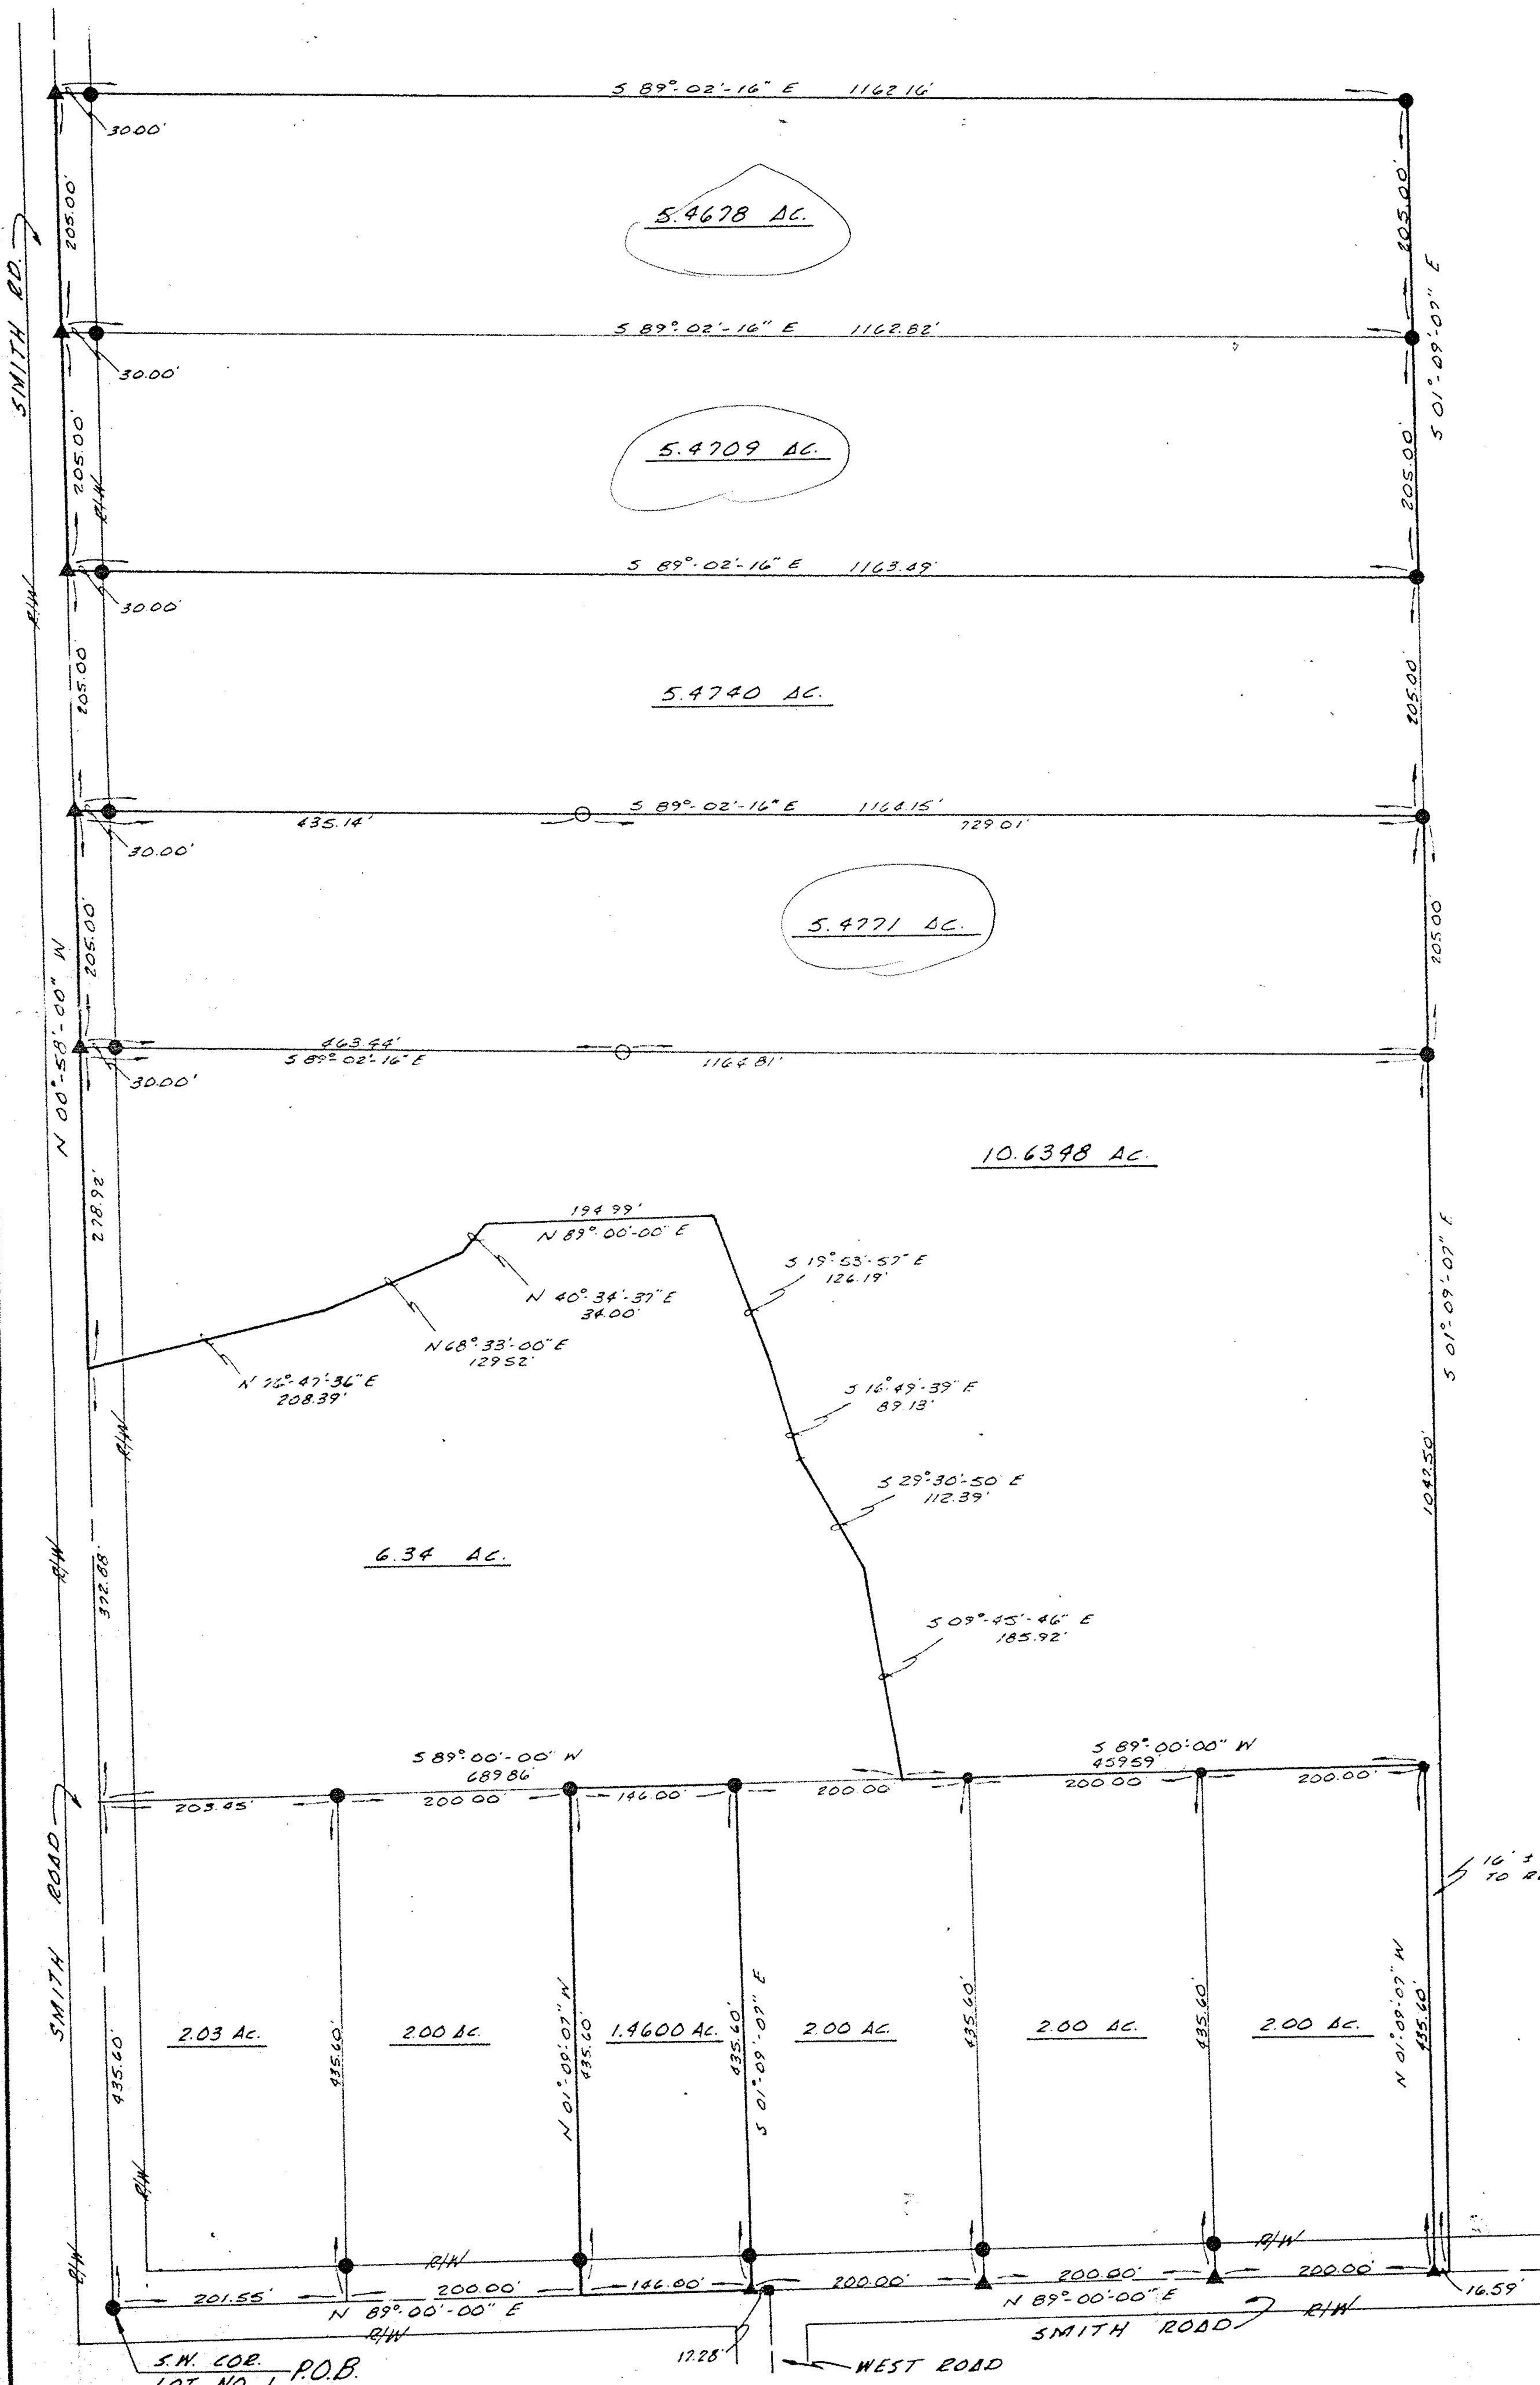

NORTH

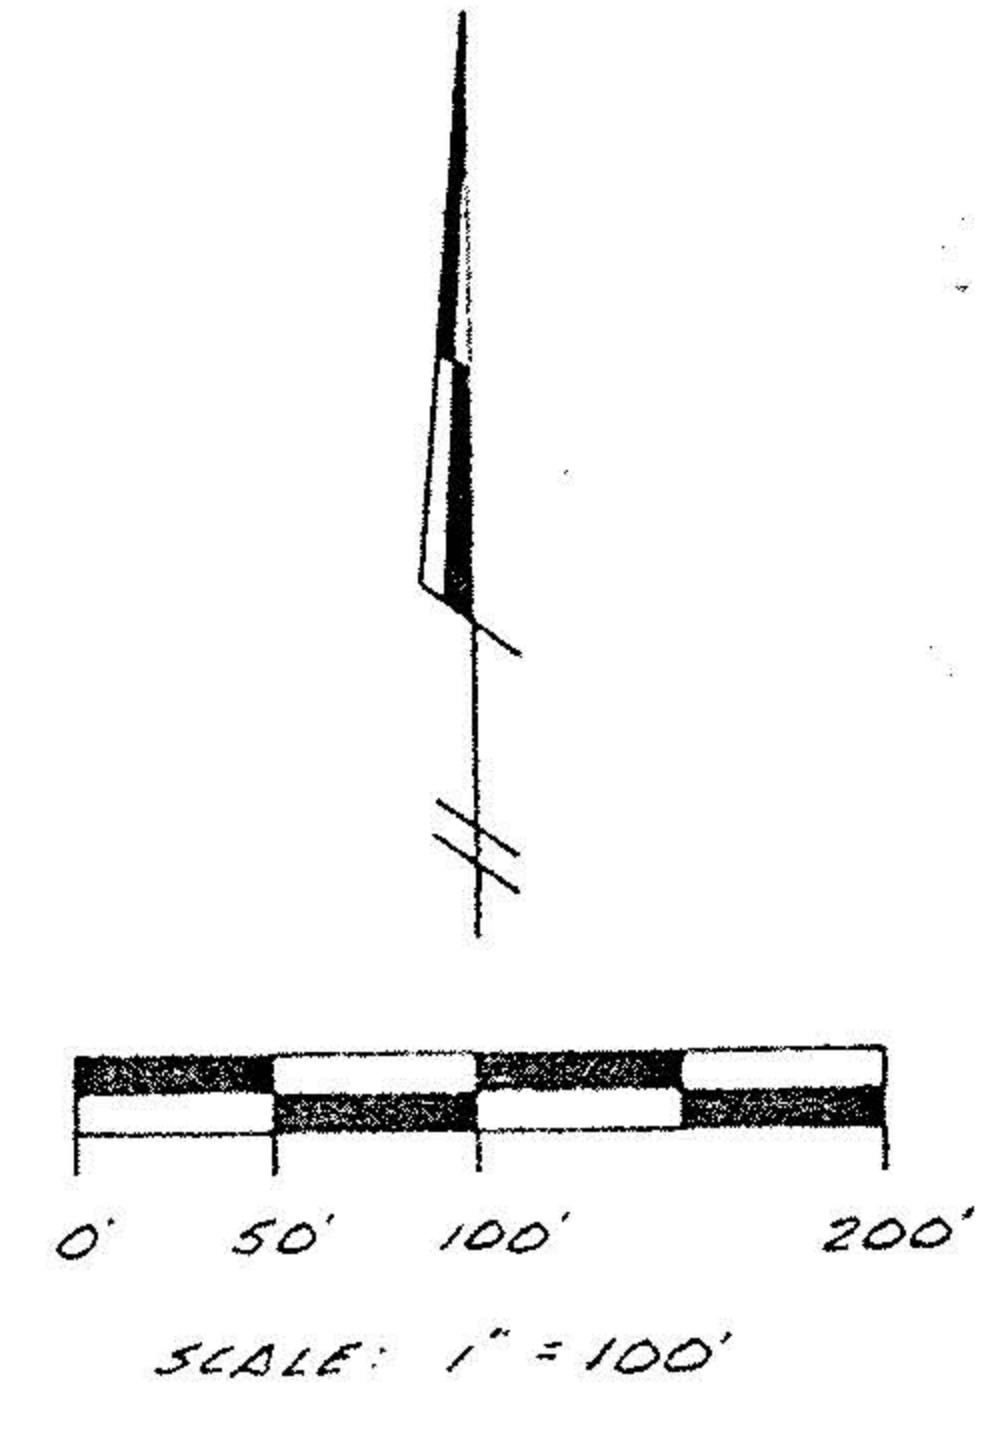

LEGEND

- IRON PIN FOUND
- IRON PIN SET
- ▲ R/R SPIKE FOUND
- MONUMENT BOX FOUND



*William L. Fox*  
WILLIAM L. FOX P.S.  
REG. SURVEYOR NO. 5878

I HEREBY CERTIFY THIS  
PLAT TO BE A TRUE  
DELINERATION OF A FIELD  
SURVEY MADE BY WILLIAM  
L. FOX, AND THAT ALL  
MONUMENTS WERE FOUND  
OR SET AS SHOWN.

X19498

APPROVED	
LORAIN CO.	
MAP DEPT.	
DATE	8-13-91
PAGE	18-H
BY	<i>Carolyn Thomas</i>
VOID AFTER	1998

18-00-001-000  
DRAWN: C.E. THOMAS  
DATE: FEB. 8, 1991  
JOB NO.: 9106

REV.: JUNE 25, 1991