MAP OF SURVEY AND LOT SPLIT

PREPARED FOR

REGINALD G. AND MARILOU FLETCHER

SITUATED IN THE TOWNSHIP OF WELLINGTON, COUNTY OF LORAIN, STATE OF OHIO
AND BEING KNOWN AS PART OF ORIGINAL WELLINGTON TOWNSHIP LOT 4

0' 100' 200' 300'

CURVE TABLE

①	②	③
R = 3015.57'	R = 5729.58'	R = 5729.58'
A = 446.49'	A = 147.27'	A = 781.46'
C = 446.08'	C = 147.27'	C = 780.85'
N 89° 59'30" W	S 86° 29'16" E	S 88° 52'07" W

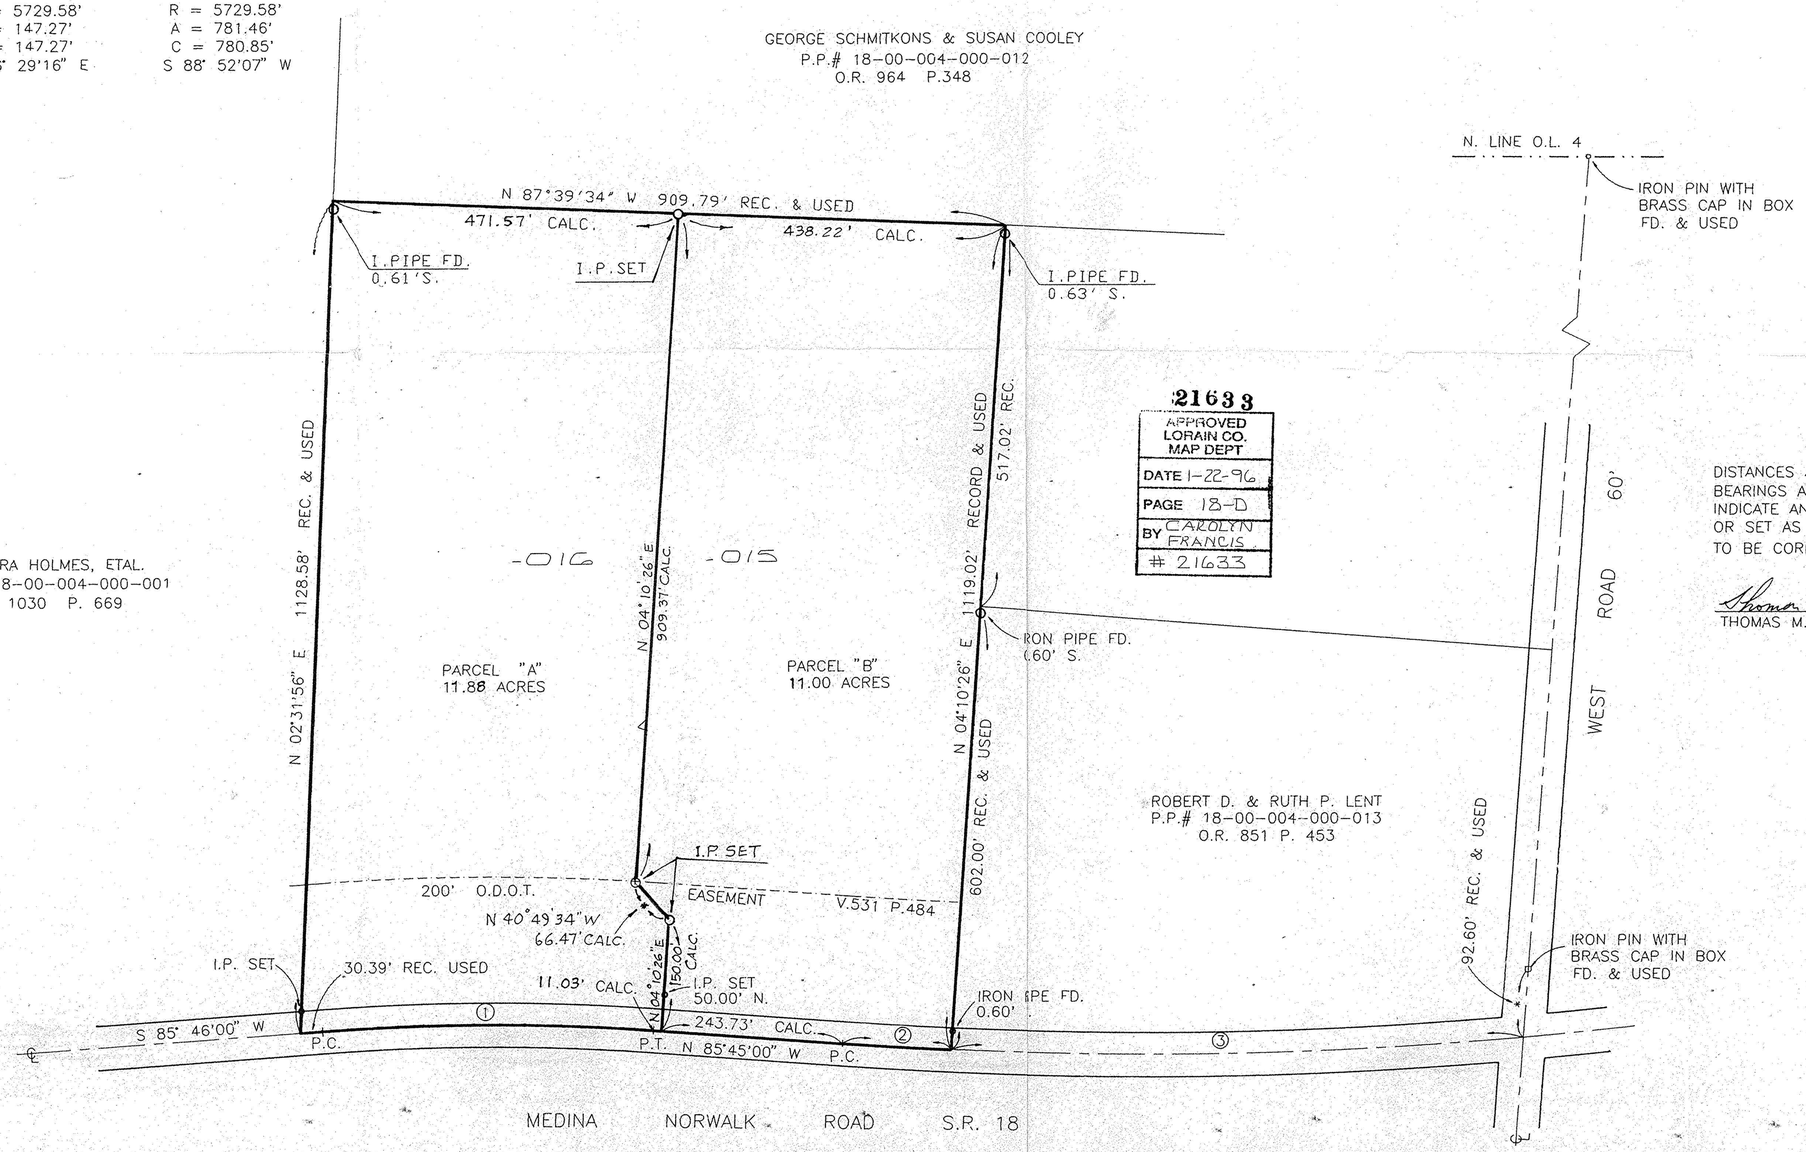

SURVEYOR'S STATEMENT

DISTANCES ARE EXPRESSED IN FEET AND DECIMAL PARTS THEREOF. BEARINGS ARE TO AN ASSUMED MERIDIAN AND ARE USED TO INDICATE ANGLES ONLY. PERMANENT MONUMENTS WERE FOUND OR SET AS INDICATED HEREON. ALL OF WHICH I DECLARE TO BE CORRECT TO THE BEST OF MY ABILITY AND BELIEF.

Thomas M. Snezek 10/27/95 REV 12/14/95

THOMAS M. SNEZEK P.S. 7051

STATE OF OHIO THOMAS M. SNEZEK 7051 SURVEYOR