

SURVEY FOR


**MERRILLE E. & GLORIA M. STUDENAKER**

PART OF O.L. 9 TOWNSHIP OF WELLINGTON  
 COUNTY OF LORAIN STATE OF OHIO  
 SCALE 1"=150' DEC. 1985  
 LAURICOM, SIMON, CAHL & ASSOC.  
 PROFESSIONAL LAND SURVEYORS  
 JOB NO. 95-2797 P. 288 P. 10-11

542.71  
 272.62  
 815.33

31.015  
 31.046

21  
 272.62  
 542.71  
 124.08  
 940.03  
 1575.06  
 3516.07

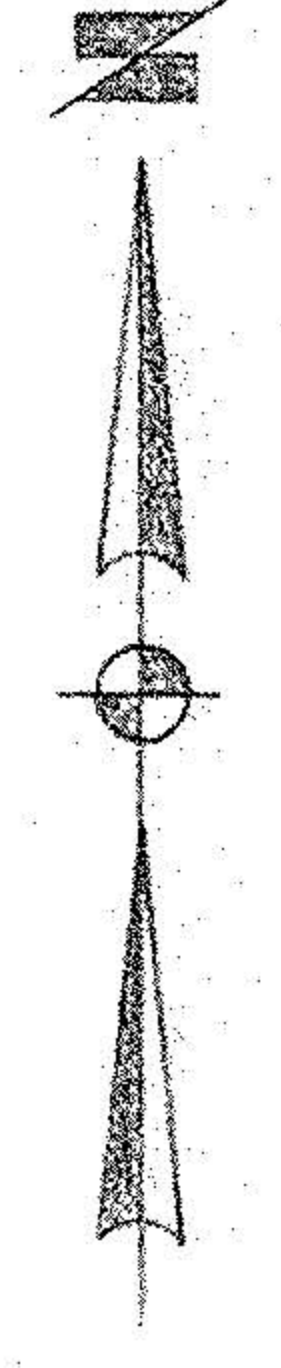

# 00074  
 APPROVED  
 LORAIN CO.  
 MAP DEPT.  
 DATE 4-26-99  
 BY [Signature]  
 100074

# 00073  
 APPROVED  
 LORAIN CO.  
 MAP DEPT.  
 DATE 4-26-99  
 BY [Signature]  
 100073

REVISED 1-25-99 Added 10.1661 & 10.470 Ac. P. 28, 29, 30, 1000