


Alma Bertha Stearns  
D. Vol. 224 Pg. 529 March 14-1927  
3.55 Ch.  
234.3°

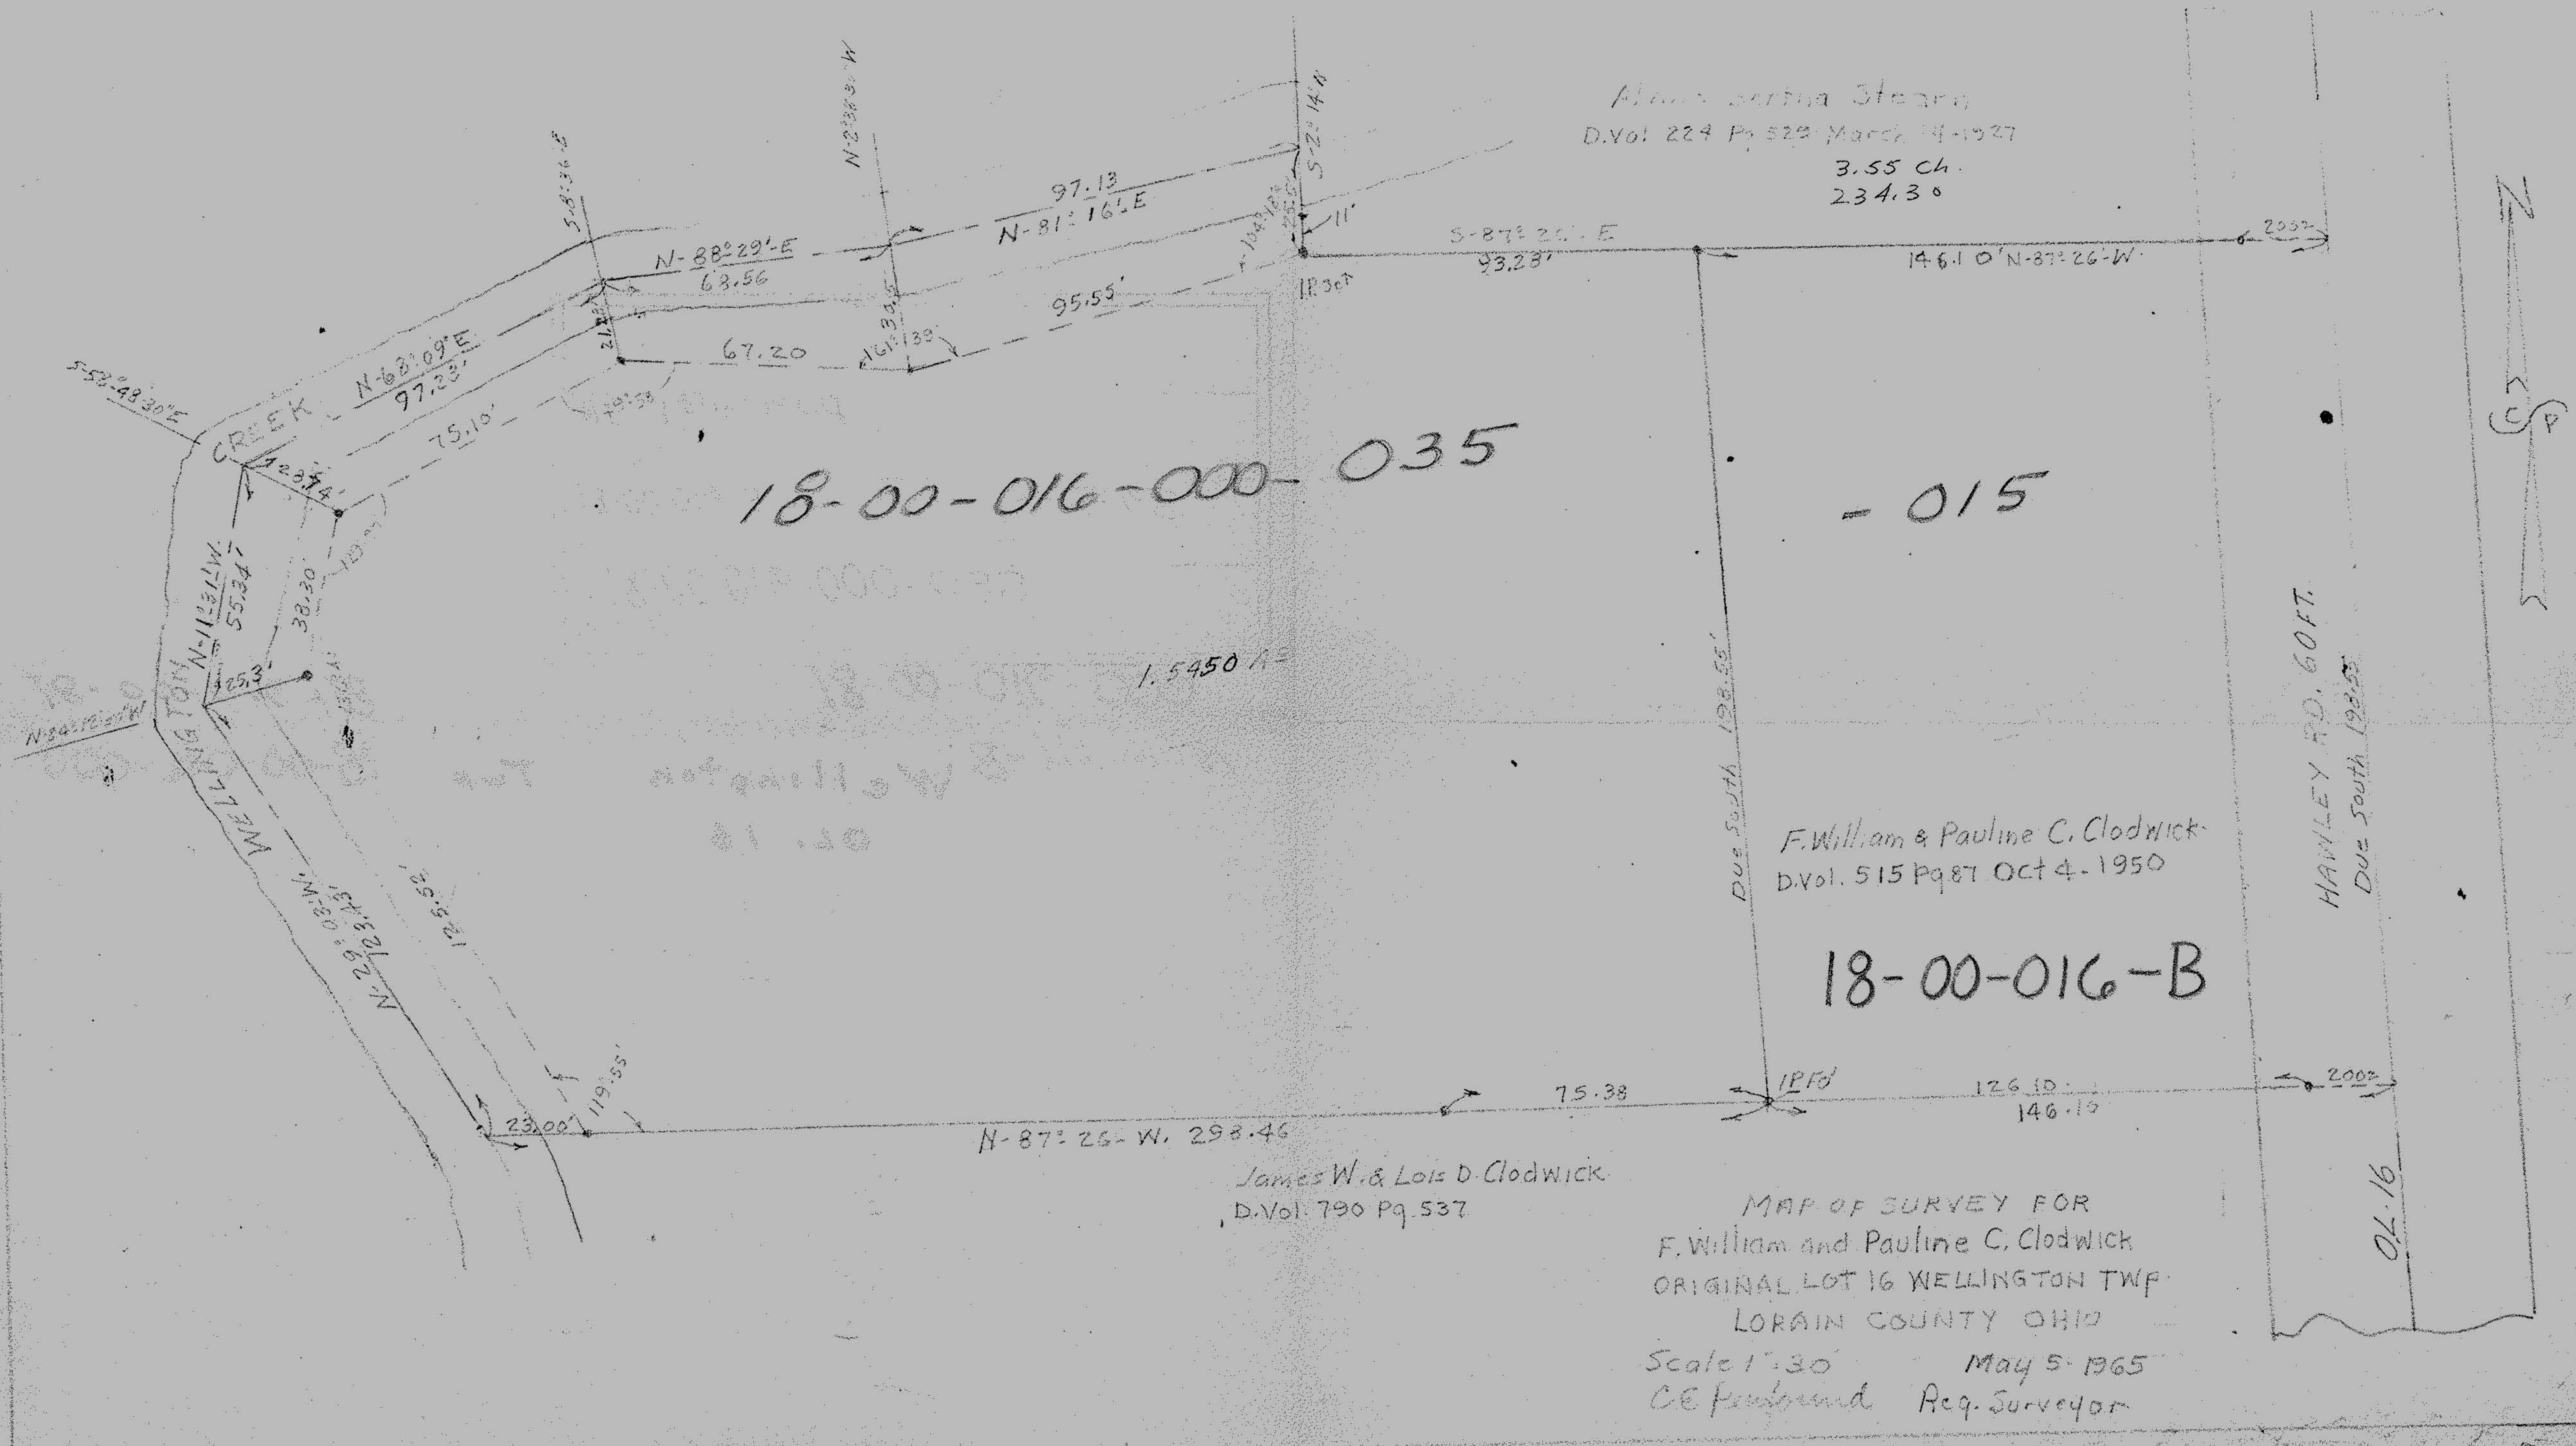

18-00-016-000-035

- 015

F. William & Pauline C. Clodwick  
D. Vol. 515 Pg. 87 Oct 4, 1950

18-00-016-B

James W. & Lois D. Clodwick  
D. Vol. 790 Pg. 537

MAP OF SURVEY FOR  
F. William and Pauline C. Clodwick  
ORIGINAL LOT 16 WELLINGTON TWP  
LORAIN COUNTY OHIO  
Scale 1"=30' May 5, 1965  
C.E. Peabody Reg. Surveyor

HAWLEY RD. 60 FT.  
DUE SOUTH 1925

OL 16