


AIDEN E. & EVELYN M.
TEWKSBURY
Vol. 672 PG. 32C
P.P. No. 18-00-016-000-005

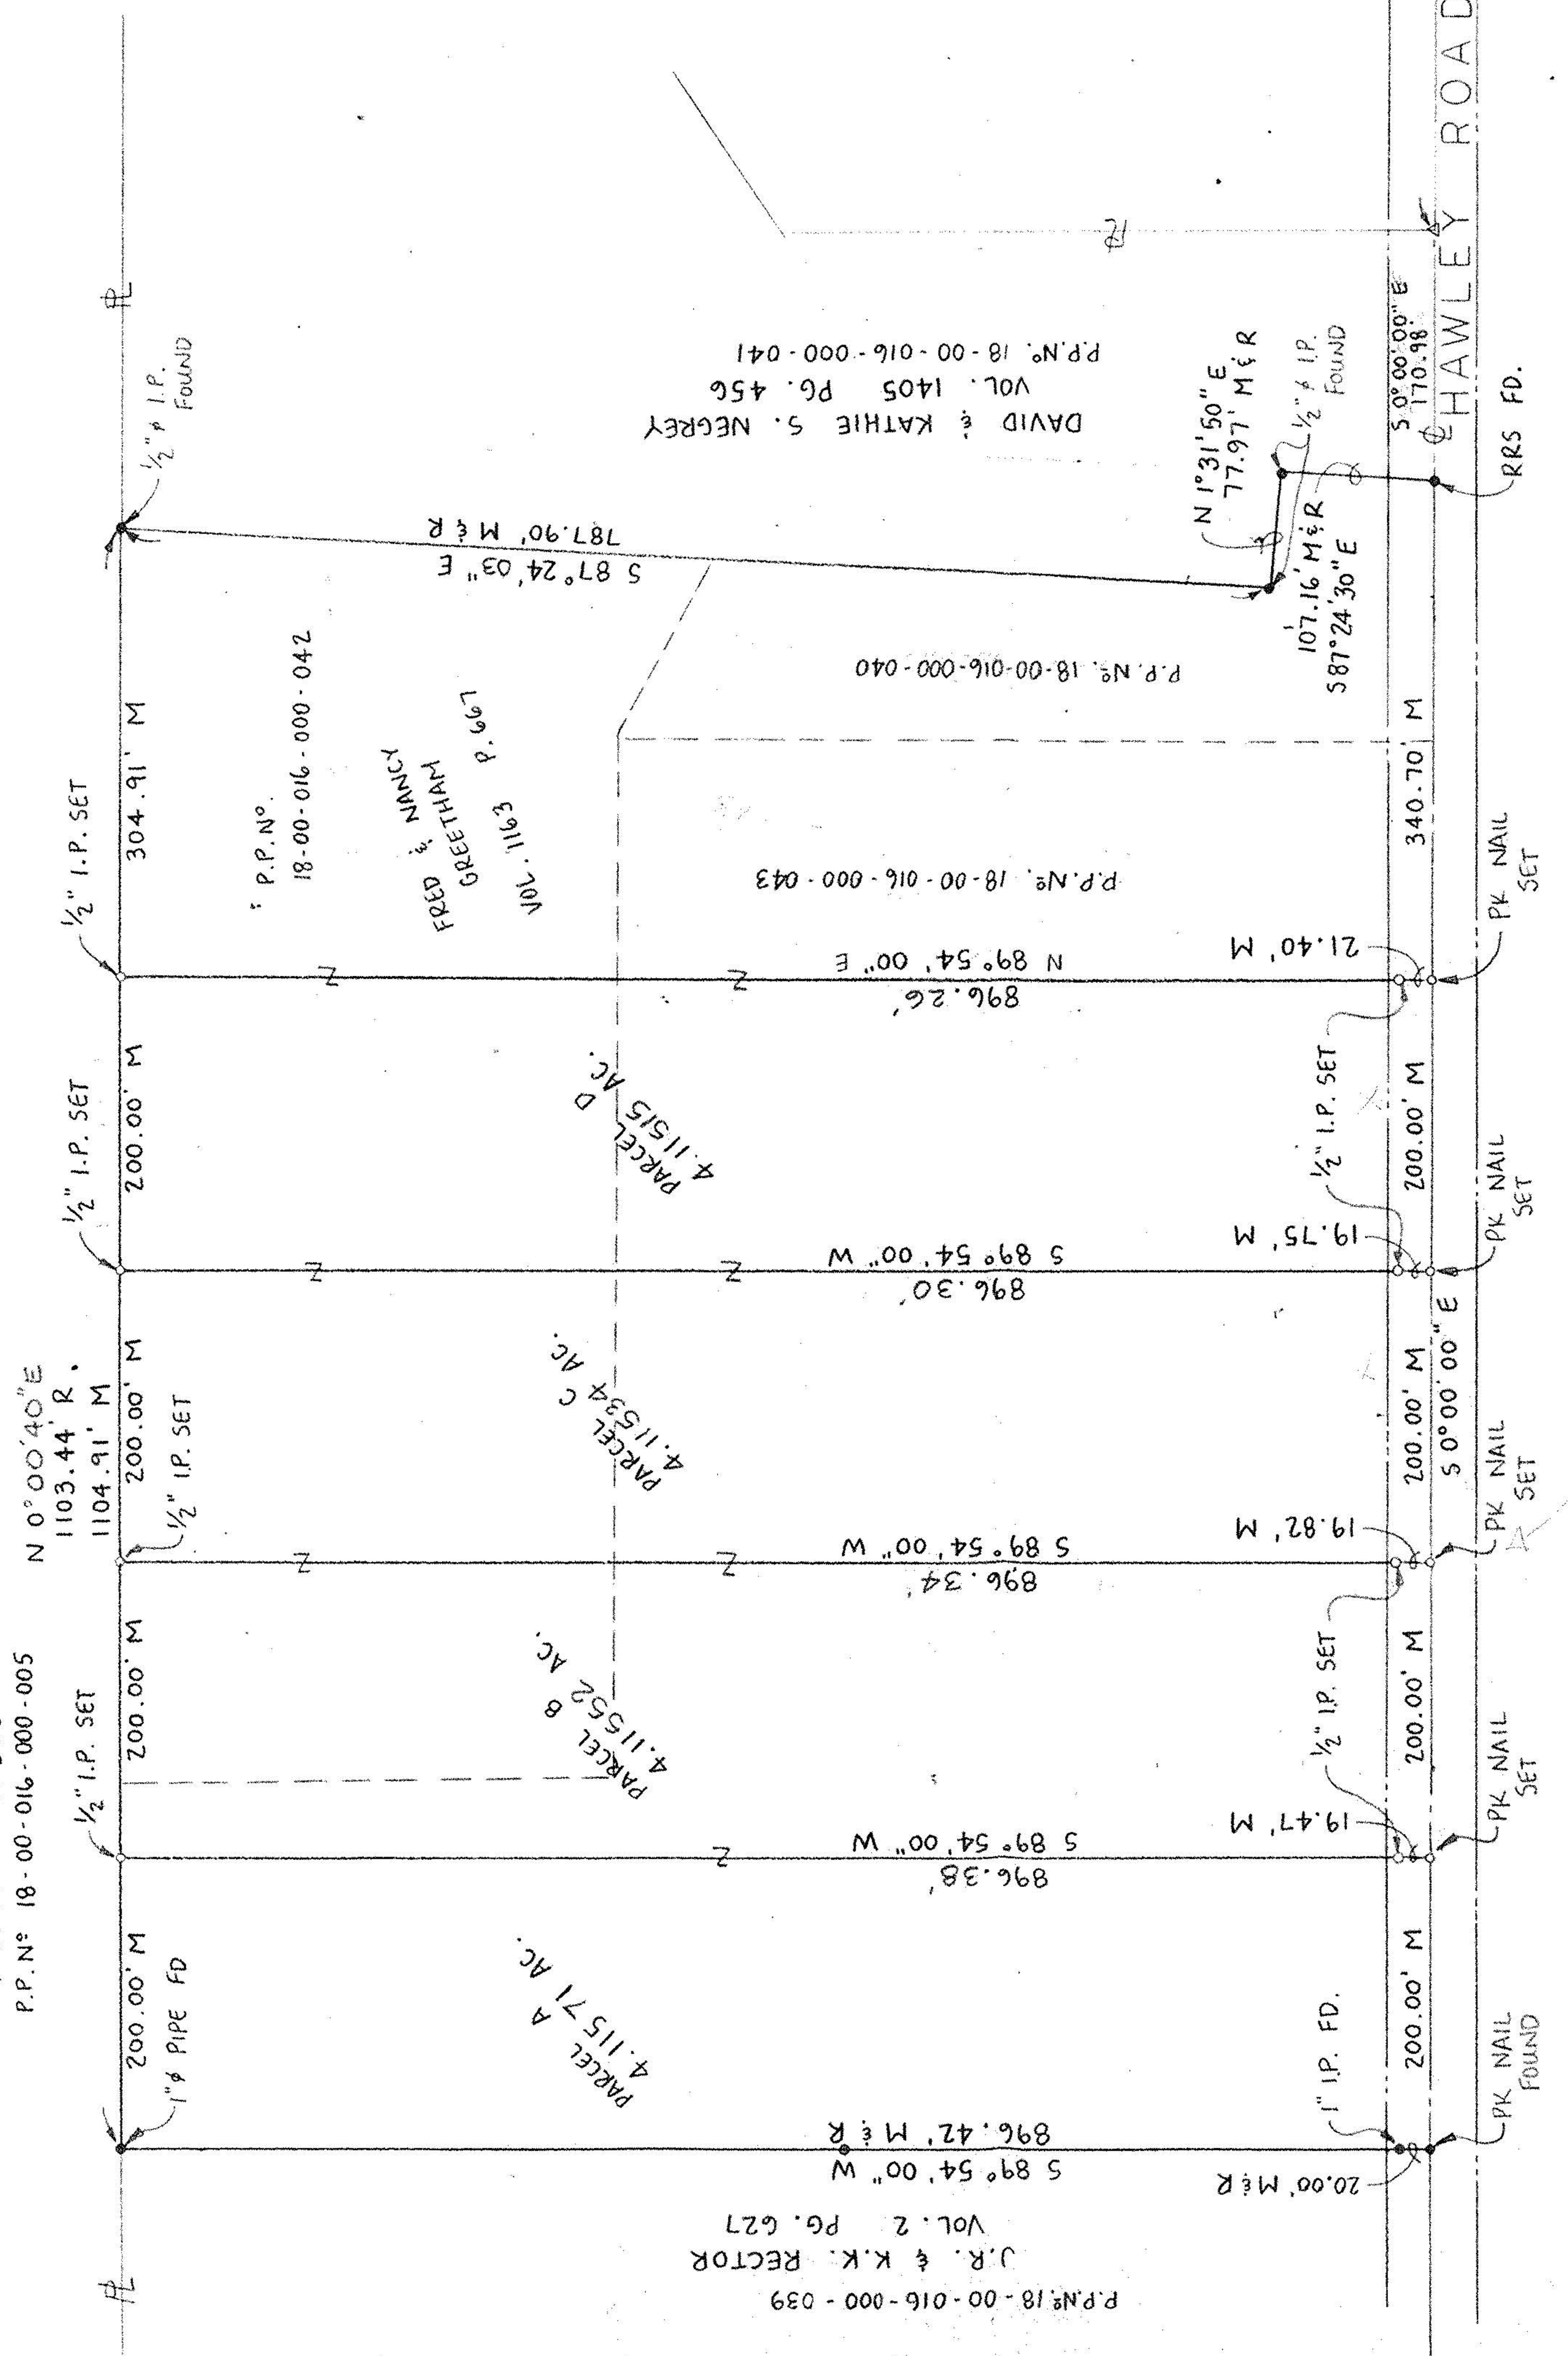

LEGEND :

P.P. No	PERMANENT PARCEL NUMBER
R	PROPERTY LINE
M	RECORD DISTANCE
o	MEASURED DISTANCE
*	NEW MONUMENT SET
I.P.	EXIST. SURVEY MONUMENT
RRS	IRON PIN
	RAILROAD SPIKE

#18396
APPROVED
LORAIN CO.
MAP DEPT.
DATE 5-22-89
PAGE 18-00-016-005
BY *William Lee Spencer*
VOID AFTER #18396



William Lee Spencer
REGISTERED SURVEYOR
NO. 6561

SURVEY OF FRED & NANCY
GREETHAM (V.1163, P.667)
PART OF LOT 16, WELLINGTON TWP.,
LORAIN COUNTY
DWN: SRN DATE: 4-4-89
CHK'D: WLS REV. 5-1-89
PREPARED FOR:
FRED B. GREETHAM

- NOTES:
1. ERROR OF CLOSURE 1: 10,000
 2. BEARINGS BASED ON ASSUMED MERIDIAN FOR THE PURPOSE OF DESCRIBING ANGLES ONLY.
 3. THIS SURVEY BASED ON LORAIN COUNTY DEED SURVEY & PLAT RECORD.
 4. TOTAL ACREAGE PER SURVEY 22.49468 ACRES.
A. DEDUCTIONS:
a. PARCEL "A" = 4.11571
b. PARCEL "B" = 4.11552
c. PARCEL "C" = 4.11534
d. PARCEL "D" = 4.11515
B. REMAINDER:
P.P.No. 18-00-016-000-040 = 1.37395 AC.
P.P.No. 18-00-016-000-042 = 2.69822 AC.
P.P.No. 18-00-016-000-043 = 1.96079 AC.

S-070