LAUNDON • SIMON • CAHL & ASSOC., INC.
PROFESSIONAL LAND SURVEYORS
110 MIDDLE AVE., ELYRIA, O. 44035

SURVEY FOR:

TIMOTHY R. PIEPER
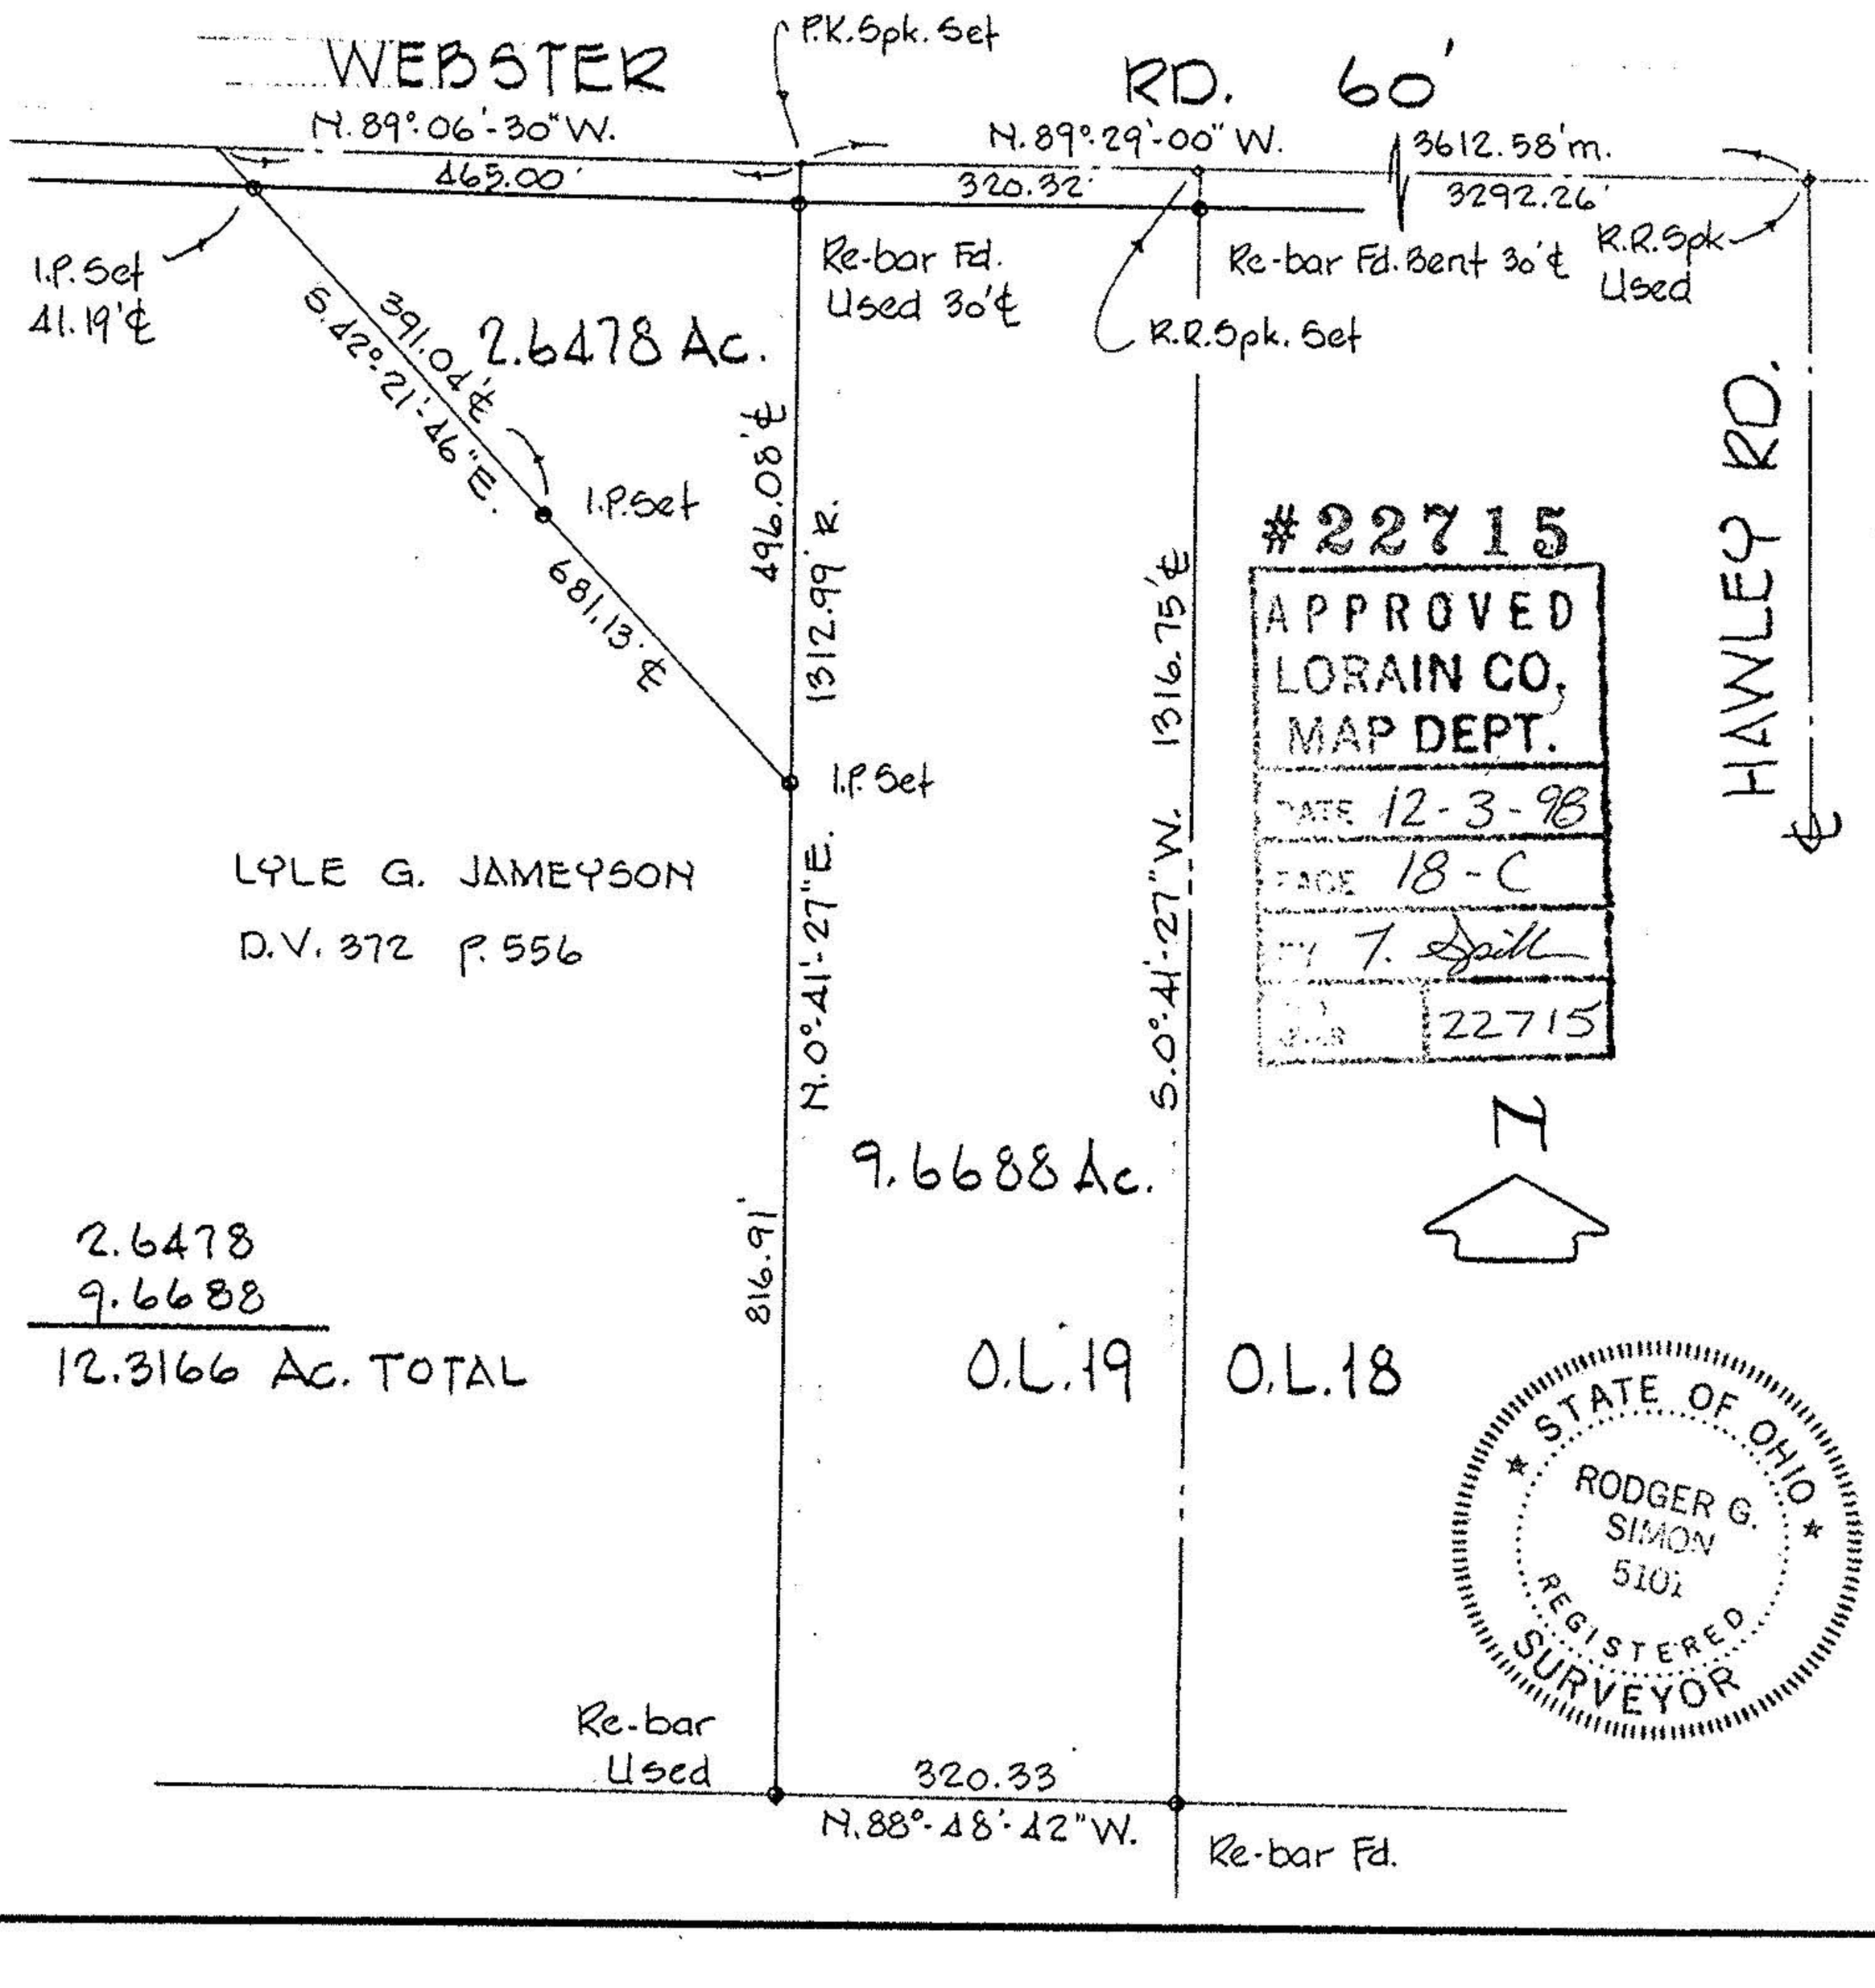
Orig. Lot No. 19	City of	Date APR. '98 Scale 1" = 200'
Orig. Sec No.	Village of	Dwn. by R.G.S. Chkd. by R.C.
Tract	County of LORAIN	Job No. 98-3025 F.B. 244/2
Township of WELLINGTON	State of Ohio	Printed