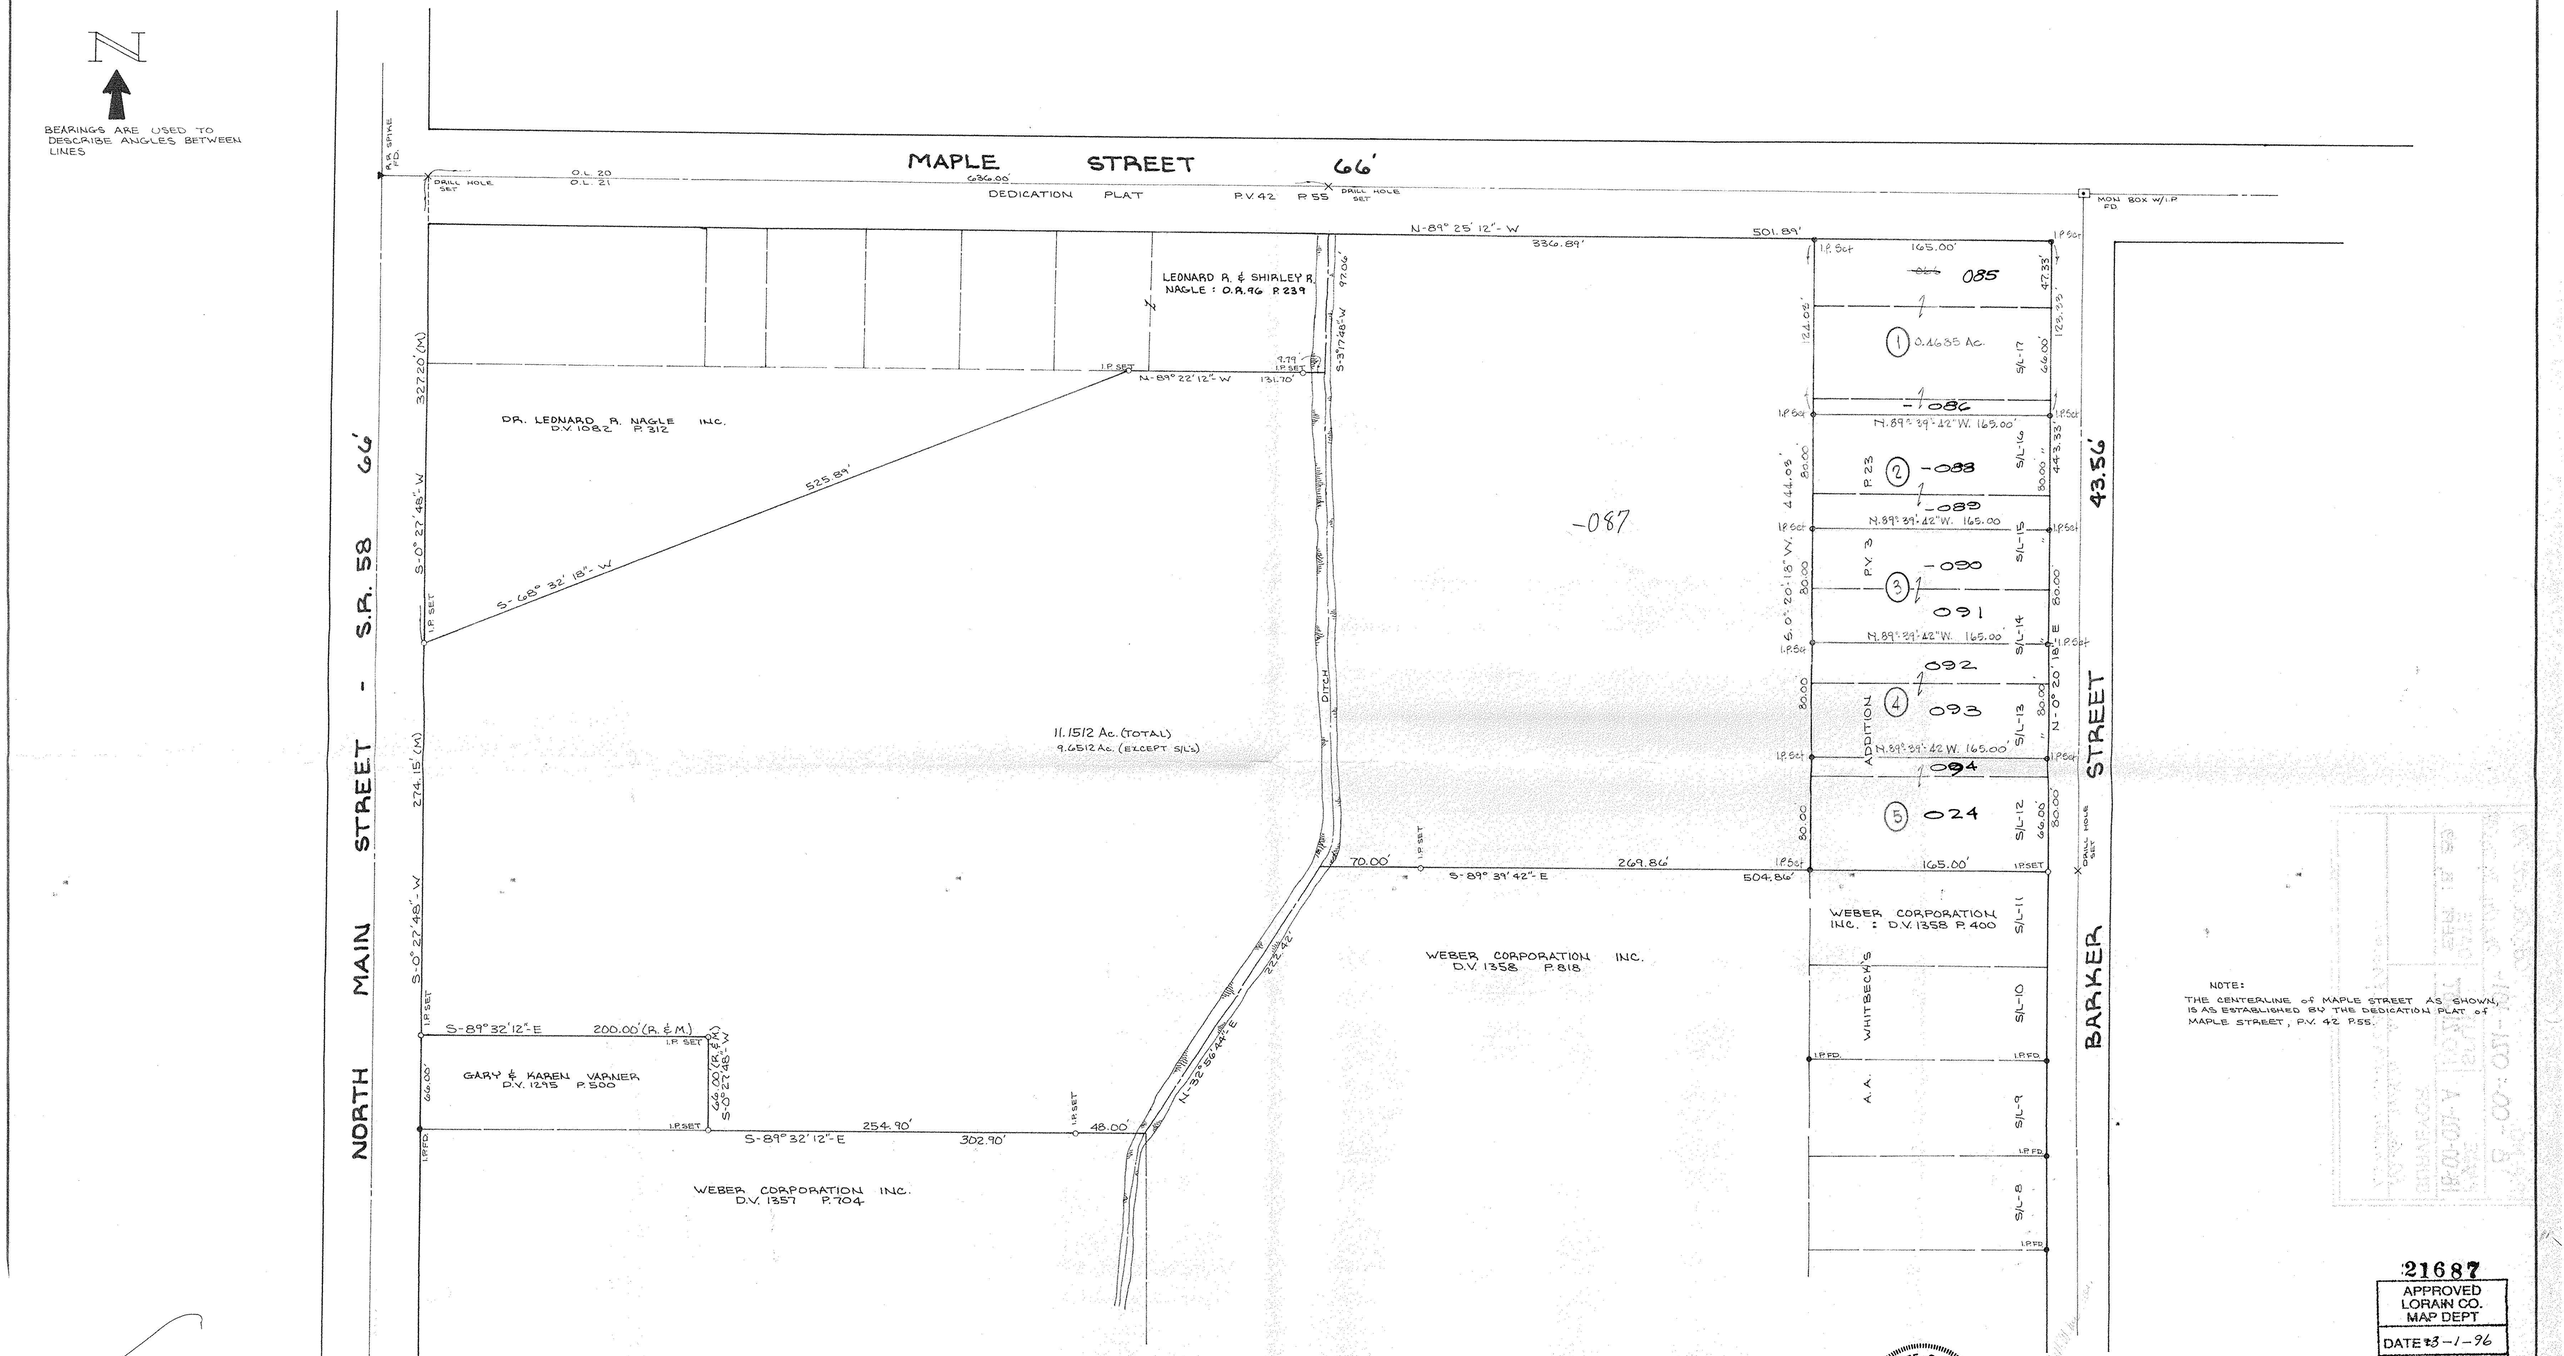

SURVEY for ESTATE of STEVE J. KOMIVES

PART of WELLINGTON TOWNSHIP, ORIGINAL LOT Nº 21

A.A. WHITBECK'S ADDITION - P.V. 3 P. 23 - S/L's 12-17

VILLAGE of WELLINGTON COUNTY of LORAIN

STATE of OHIO

SCALE: 1" = 50' SEPT. 18, 1989

REGISTERED SURVEYOR: RODGER G. SIMON # 5101

PREPARED BY

LAUNDON-SIMON-CAHL & ASSOCIATES INC.
106 MIDDLE AVENUE
ELYRIA, OHIO 44035

21687

APPROVED LORAIN CO. MAP DEPT

DATE 3-1-96

PAGE 18-00-021A

BY CAROLYN FRANCIS

21687

18-00-021-101-

REVISED 7/11/95 Add Parcels 1, 2, 3, 4 & 5 by R.G.S.

240

89-1858