18-00-021-103.034

LAUNDON · SIMON · CAHL & ASSOC. INC.
CONSULTING ENGINEERS & SURVEYORS
219 COURT ST. ELYRIA, OHIO 44035

SURVEY FOR:
GORDON F. & DORIS A. HALES
OF THE ELY. 66.0' OF S/L 3 & THE NLY. 80.0' OF S/L 11
BLK. 3 OF THE TOWN PLAT OF WELLINGTON P.V.1 P.6

Orig. Lot 21	City of	Date JUNE 1987 Scale
Orig. Sec	Village of WELLINGTON	Dwn. by R.G.S. Chkd. by C.J.
Tract	County of LORAIN	Job No. 87-1618 F.B.
Township of WELLINGTON	State of OHIO	Printed MAR 3

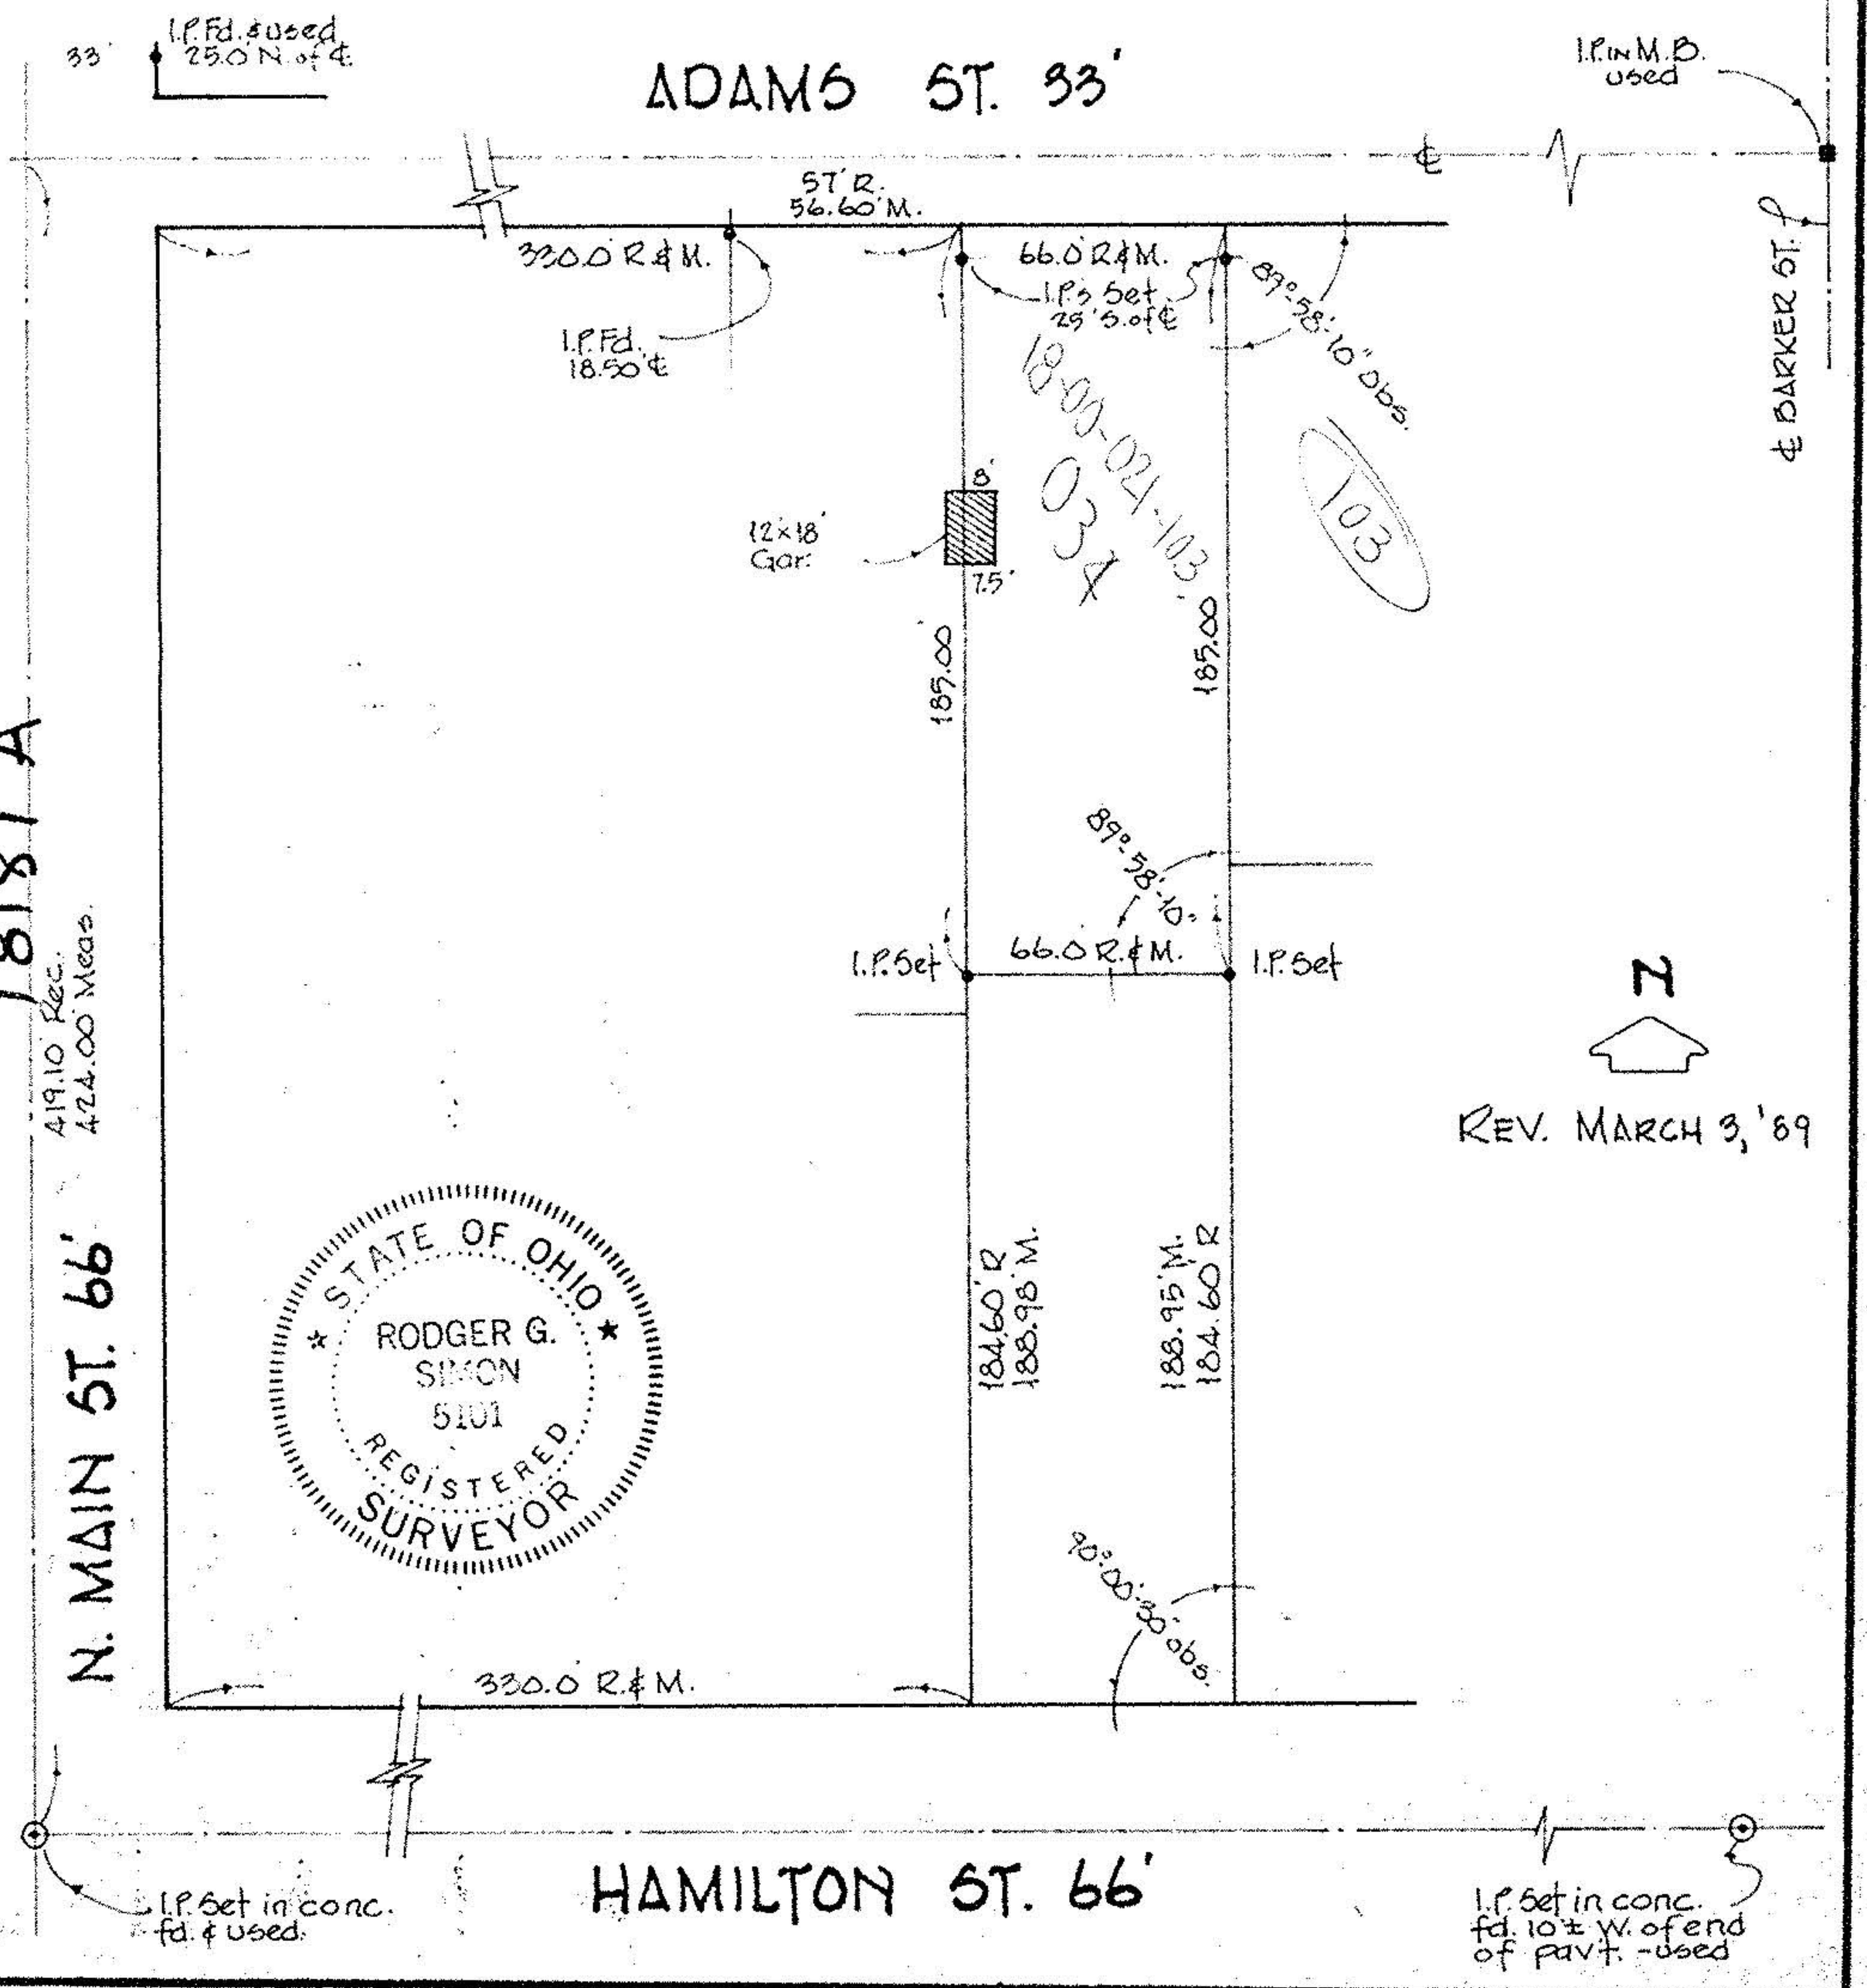

18-00-021-103.034