18-00-021-110-055

18-00-021-C

PLAT OF VILLAGE OF WELLINGTON

SHOWING Ohio Fuel Gas Co Lot

Col

PB 1030 P1

9/10/61

MWH

W.O. 1XA 611 88.32-2
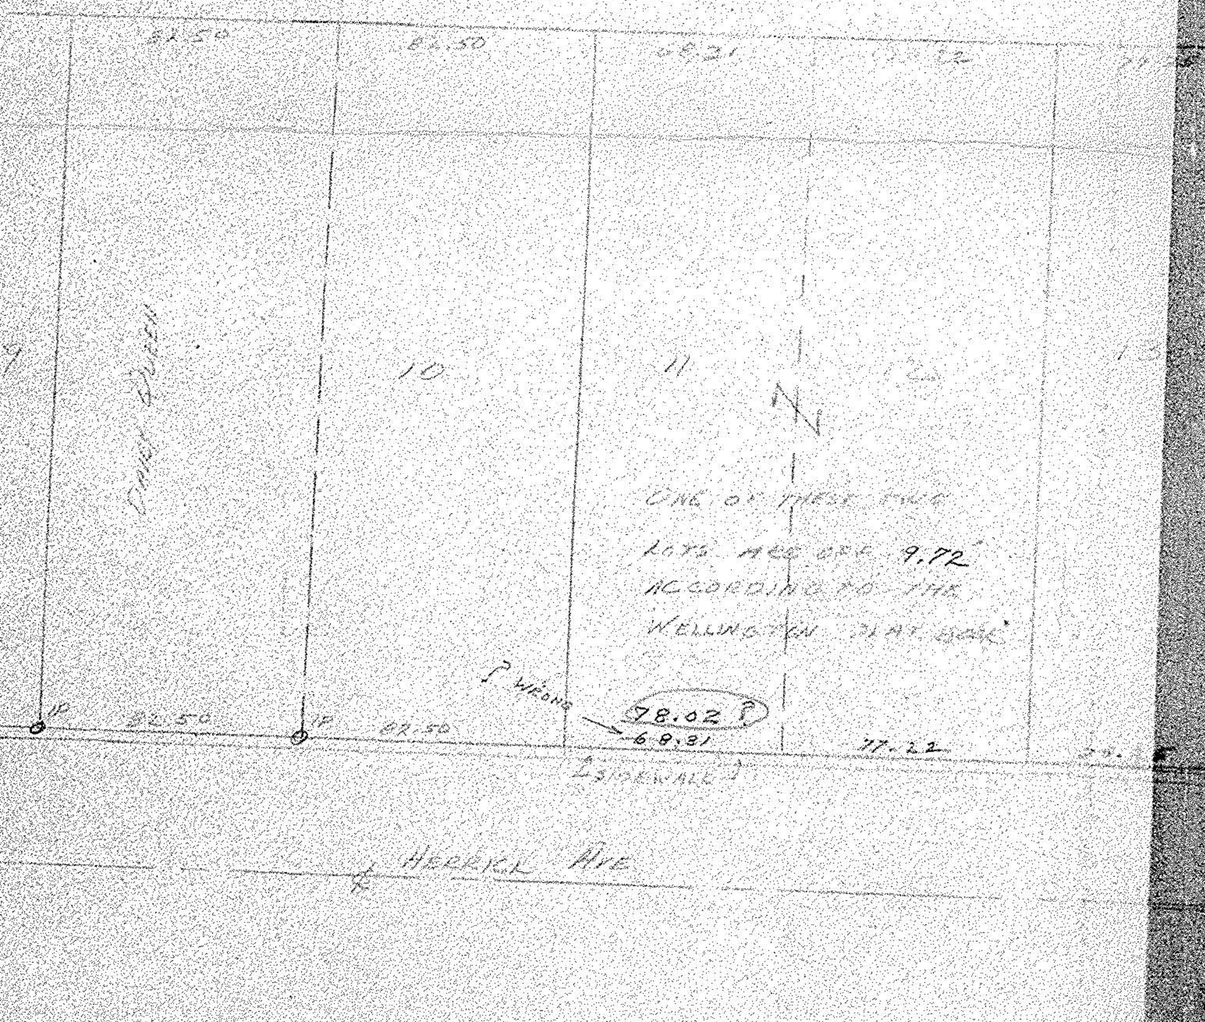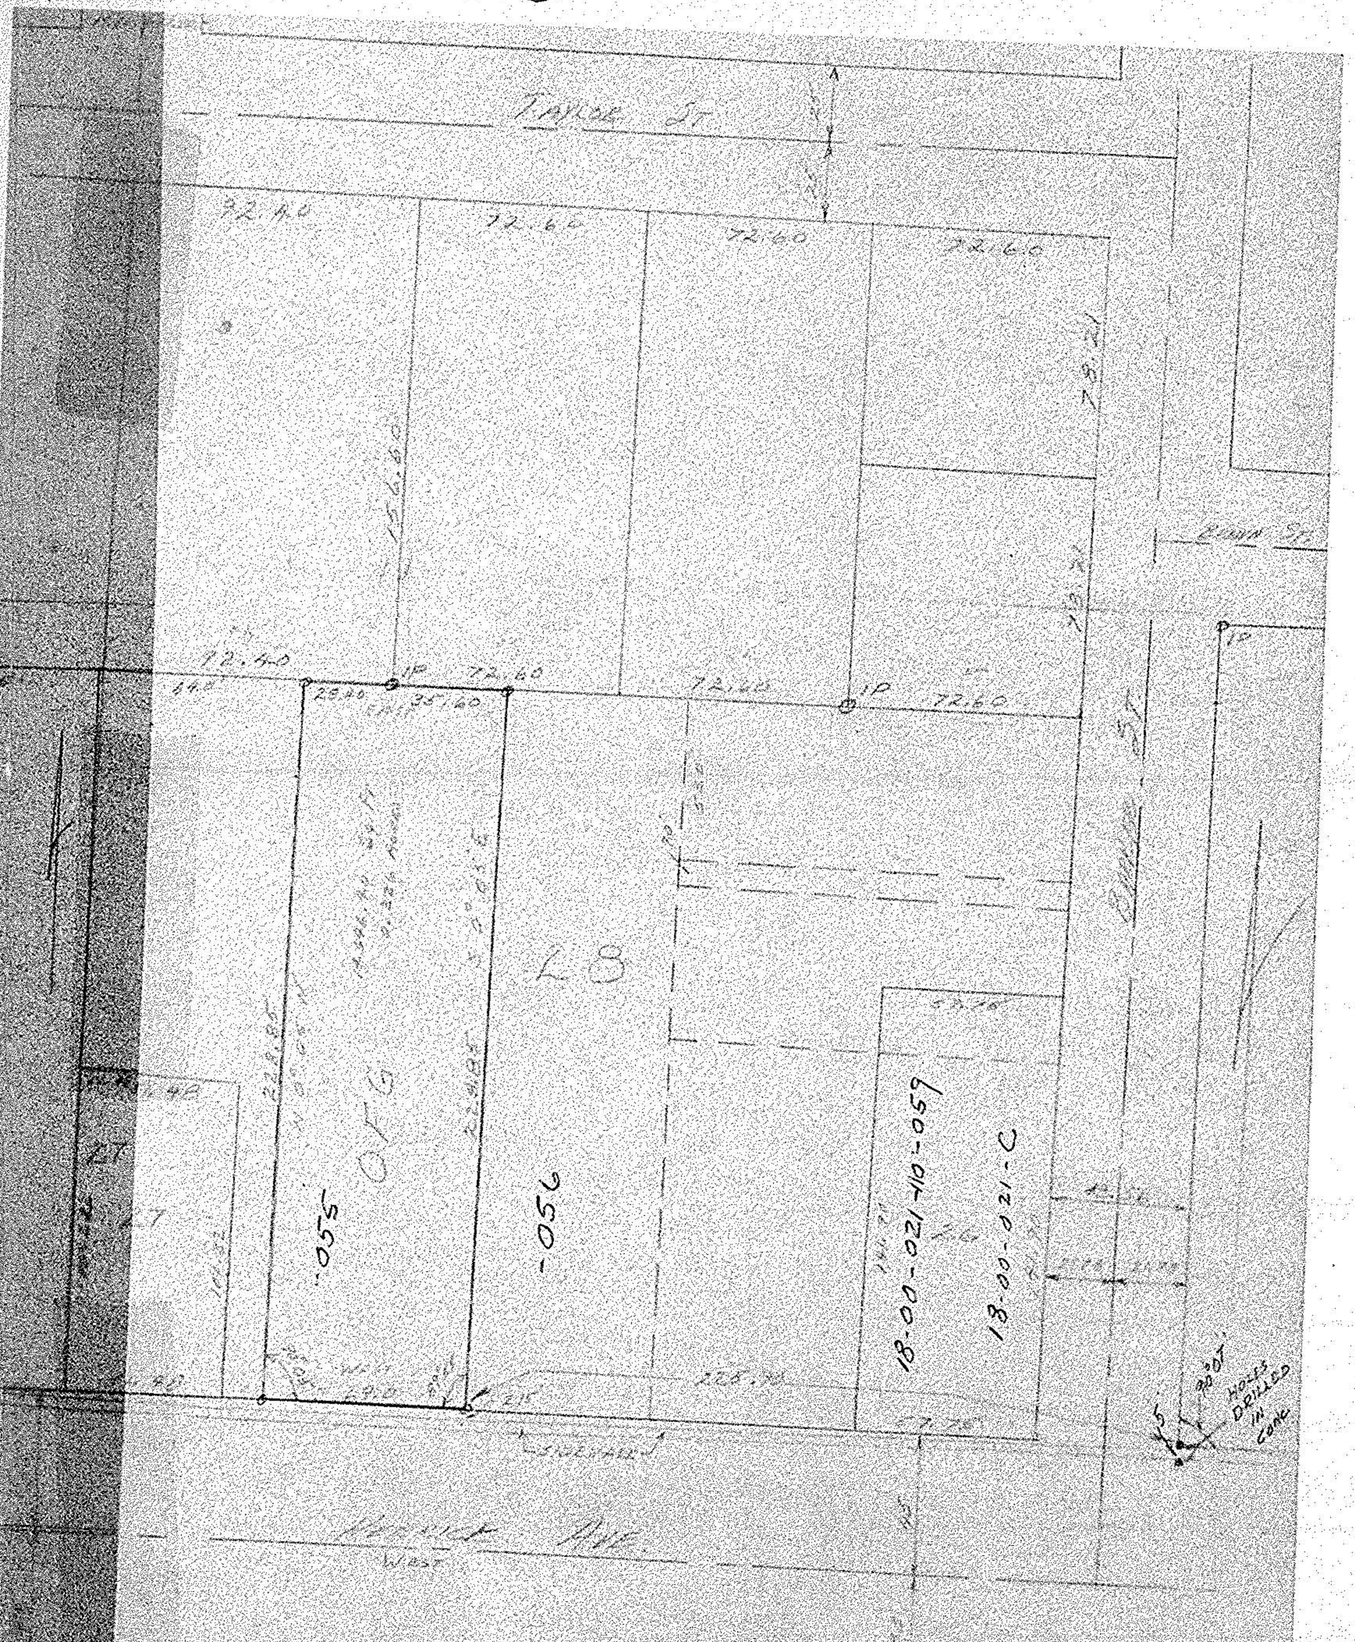
CAB-5611